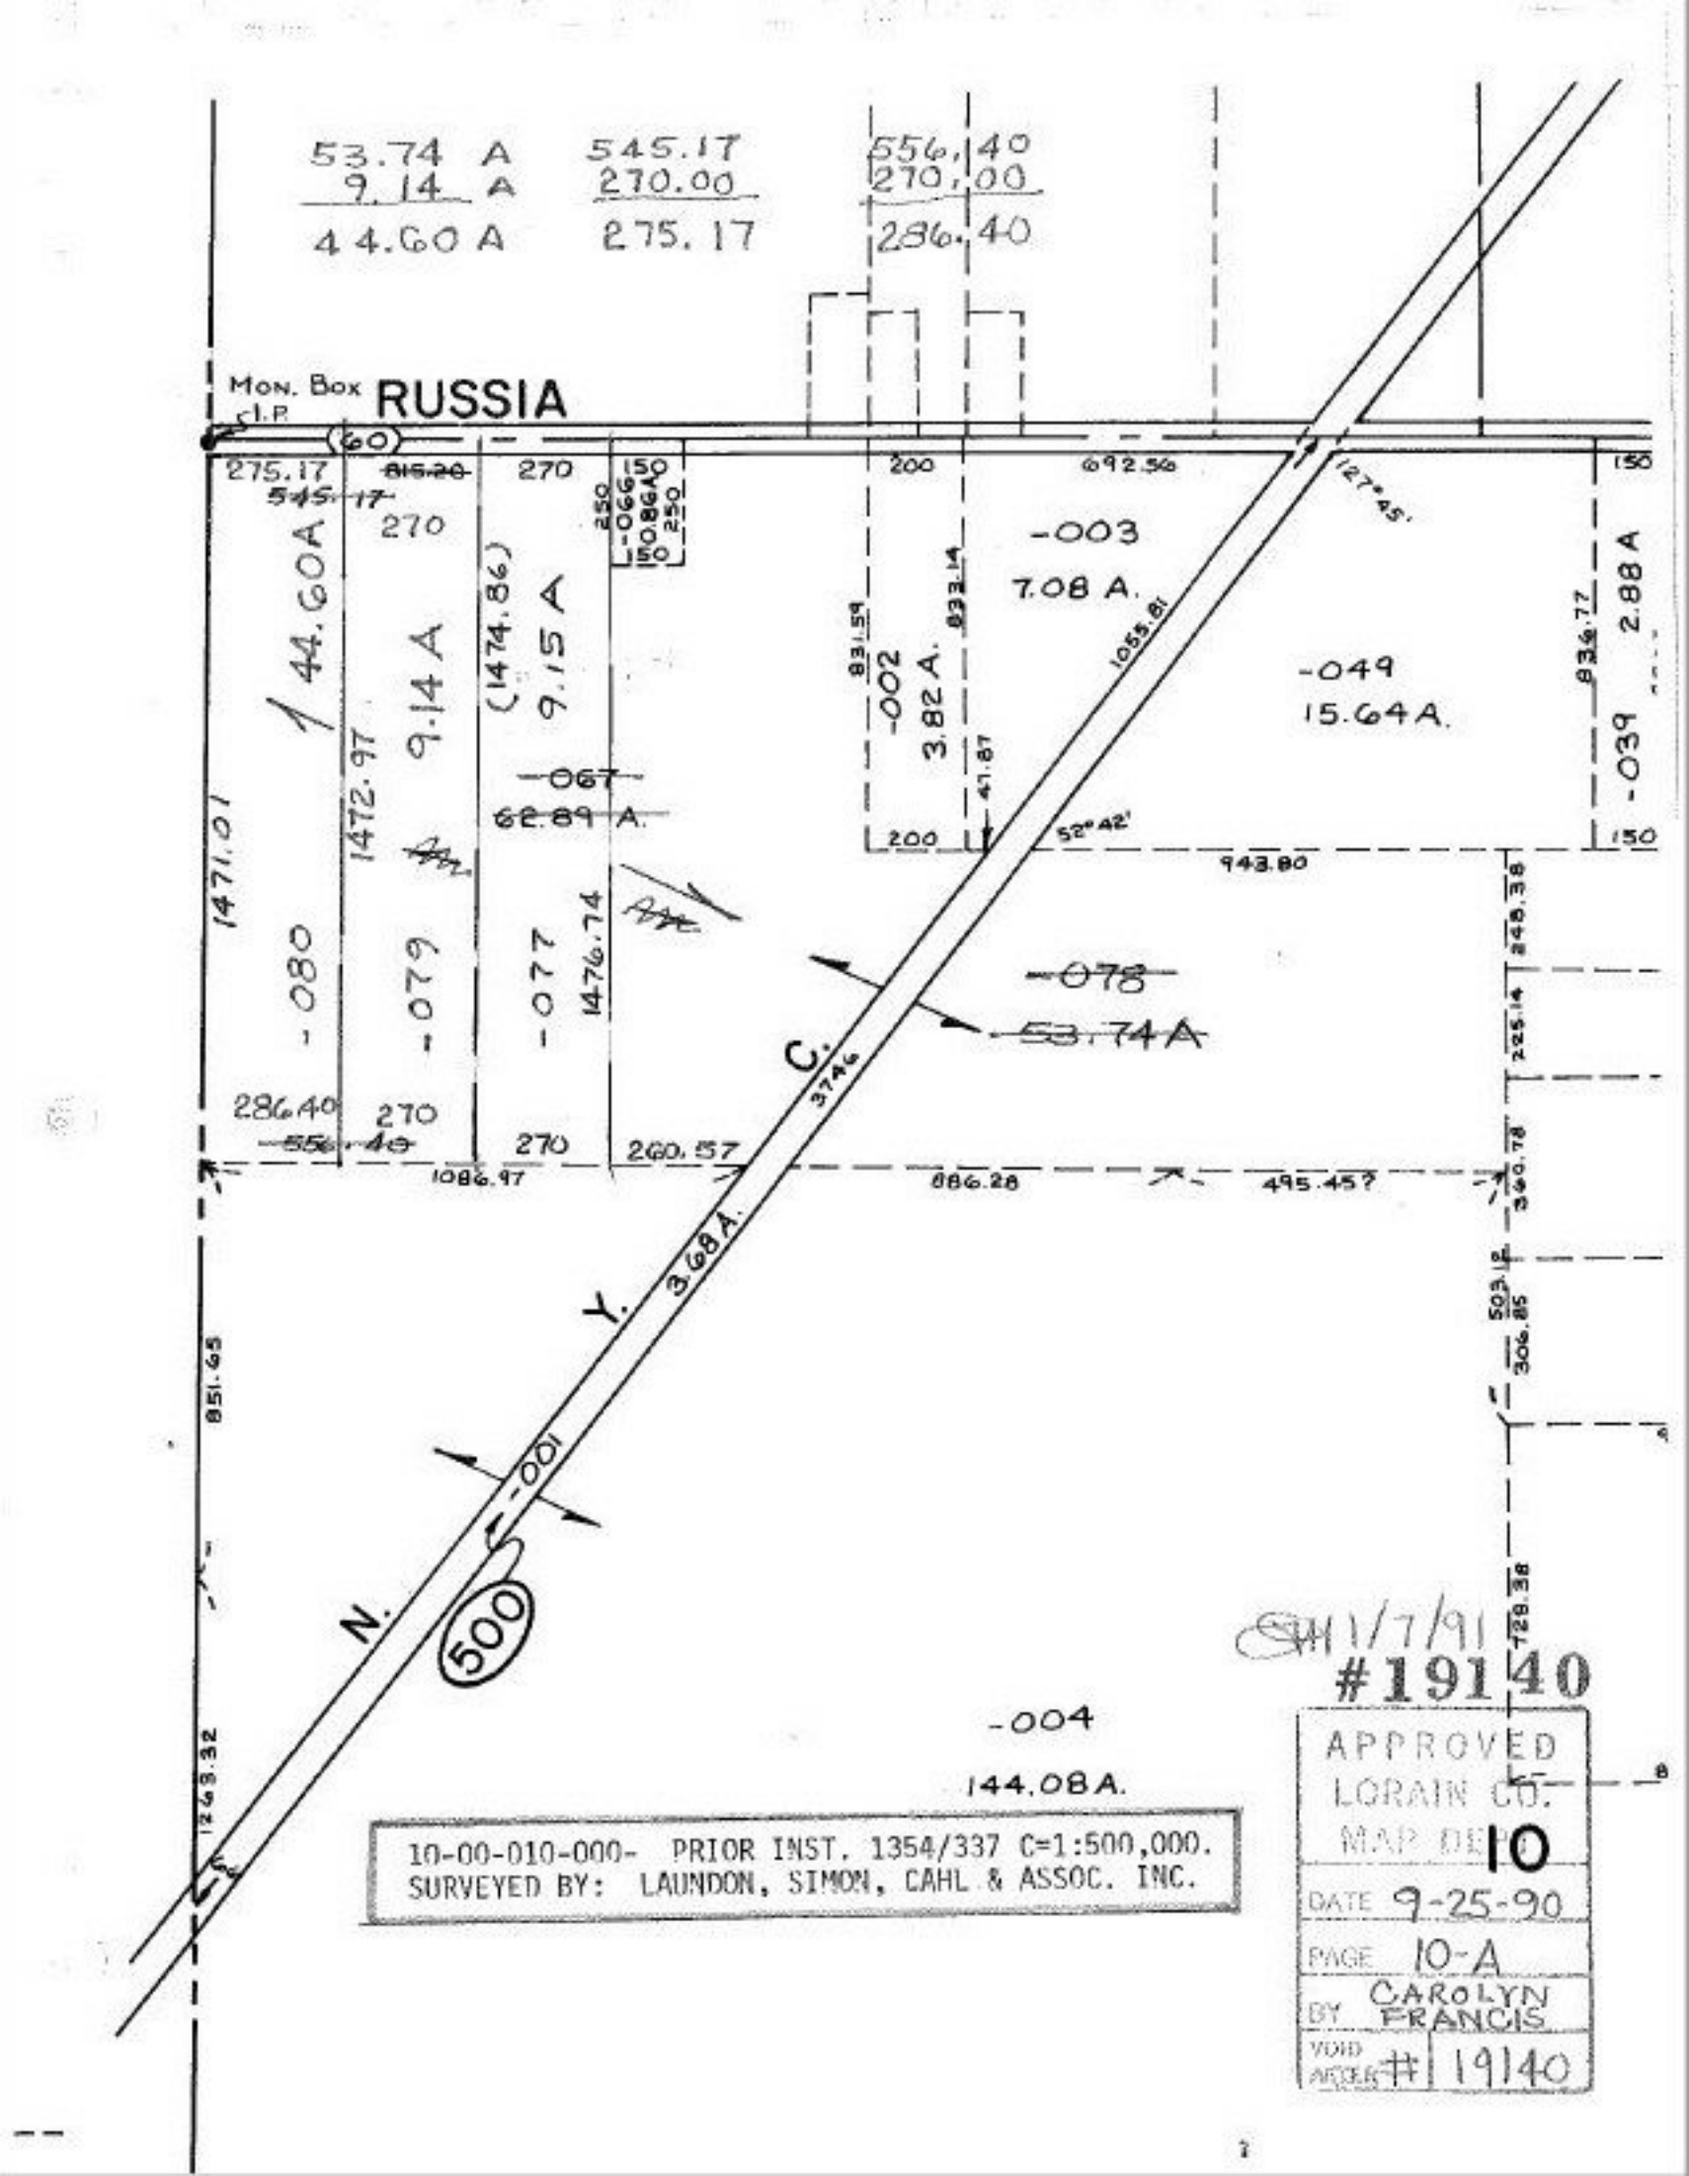

10-00-010-000- PRIOR INST. 1354/337 C=1:500,000.
SURVEYED BY: LAUNDON, SIMON, CAHL & ASSOC. INC.