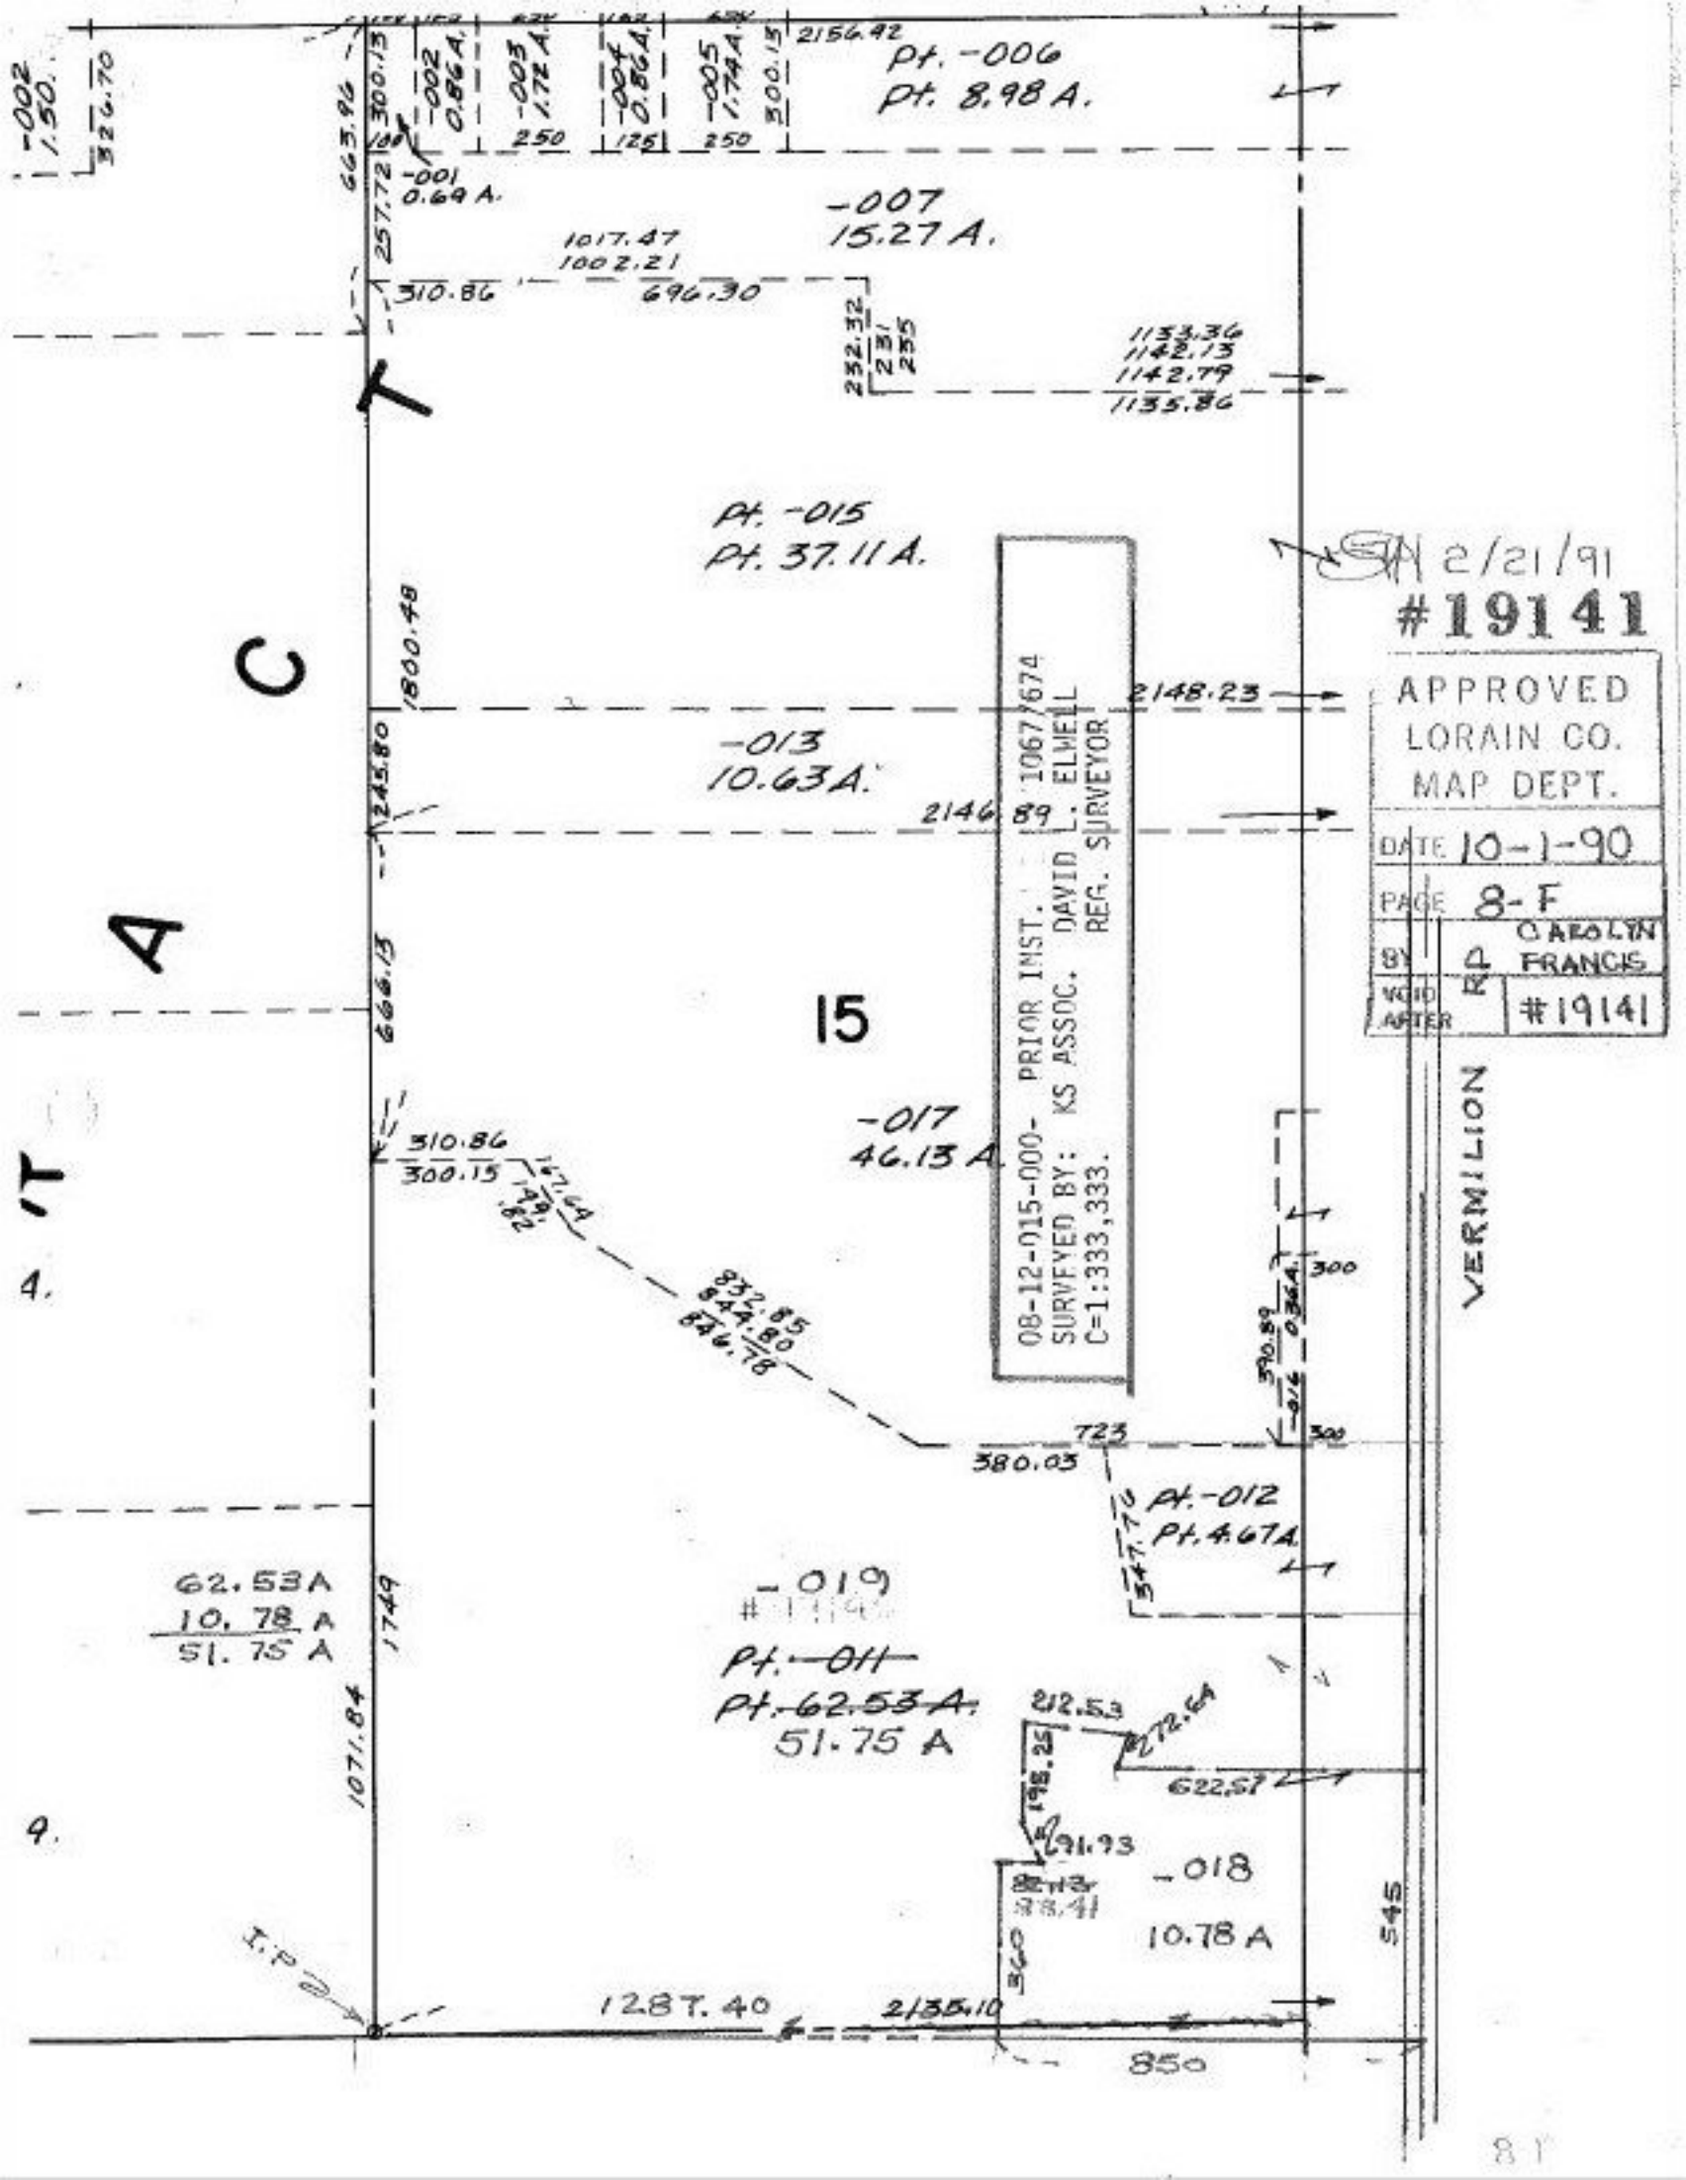
-002
1.50.
326.70
663.96
300.13
-002
0.86A.
-003
1.72A.
250
-004
0.86A.
125
-005
1.74A.
250
300.13
2156.42
Pt. -006
Pt. 8.98 A.
257.72
-001
0.69 A.
-007
15.27 A.
1017.47
1002.21
310.86
696.30
232.32
231
235
1133.36
1142.13
1142.79
1135.86
Pt. -015
Pt. 37.11 A.
2/21/91
#19141
APPROVED
LORAIN CO.
MAP DEPT.
DATE 10-1-90
PAGE 8-F
BY RP CAROLYN FRANCIS
VOID AFTER #19141
1800.48
2148.23
-013
10.63A.
245.80
2146.89
664.13
08-12-015-000- PRIOR INST. 1067/674
SURVEYED BY: KS ASSOC. DAVID L. ELWELL
C=1:333,333. REG. SURVEYOR
A C
T
15
T
4.
-017
46.13 A
310.86
300.15
147.64
142.2
833.85
644.80
826.78
390.89
-016 0.36A.
300
300
723
380.03
547.77
Pt. -012
Pt. 4.67A.
62.53A
10.78 A
51.75 A
1749
-019
Pt. -011
Pt. 62.53 A.
51.75 A
1071.84
212.53
172.64
622.57
198.25
191.93
-018
10.78 A
9.
545
I.P.
1287.40
2135.10
850
VERMILION