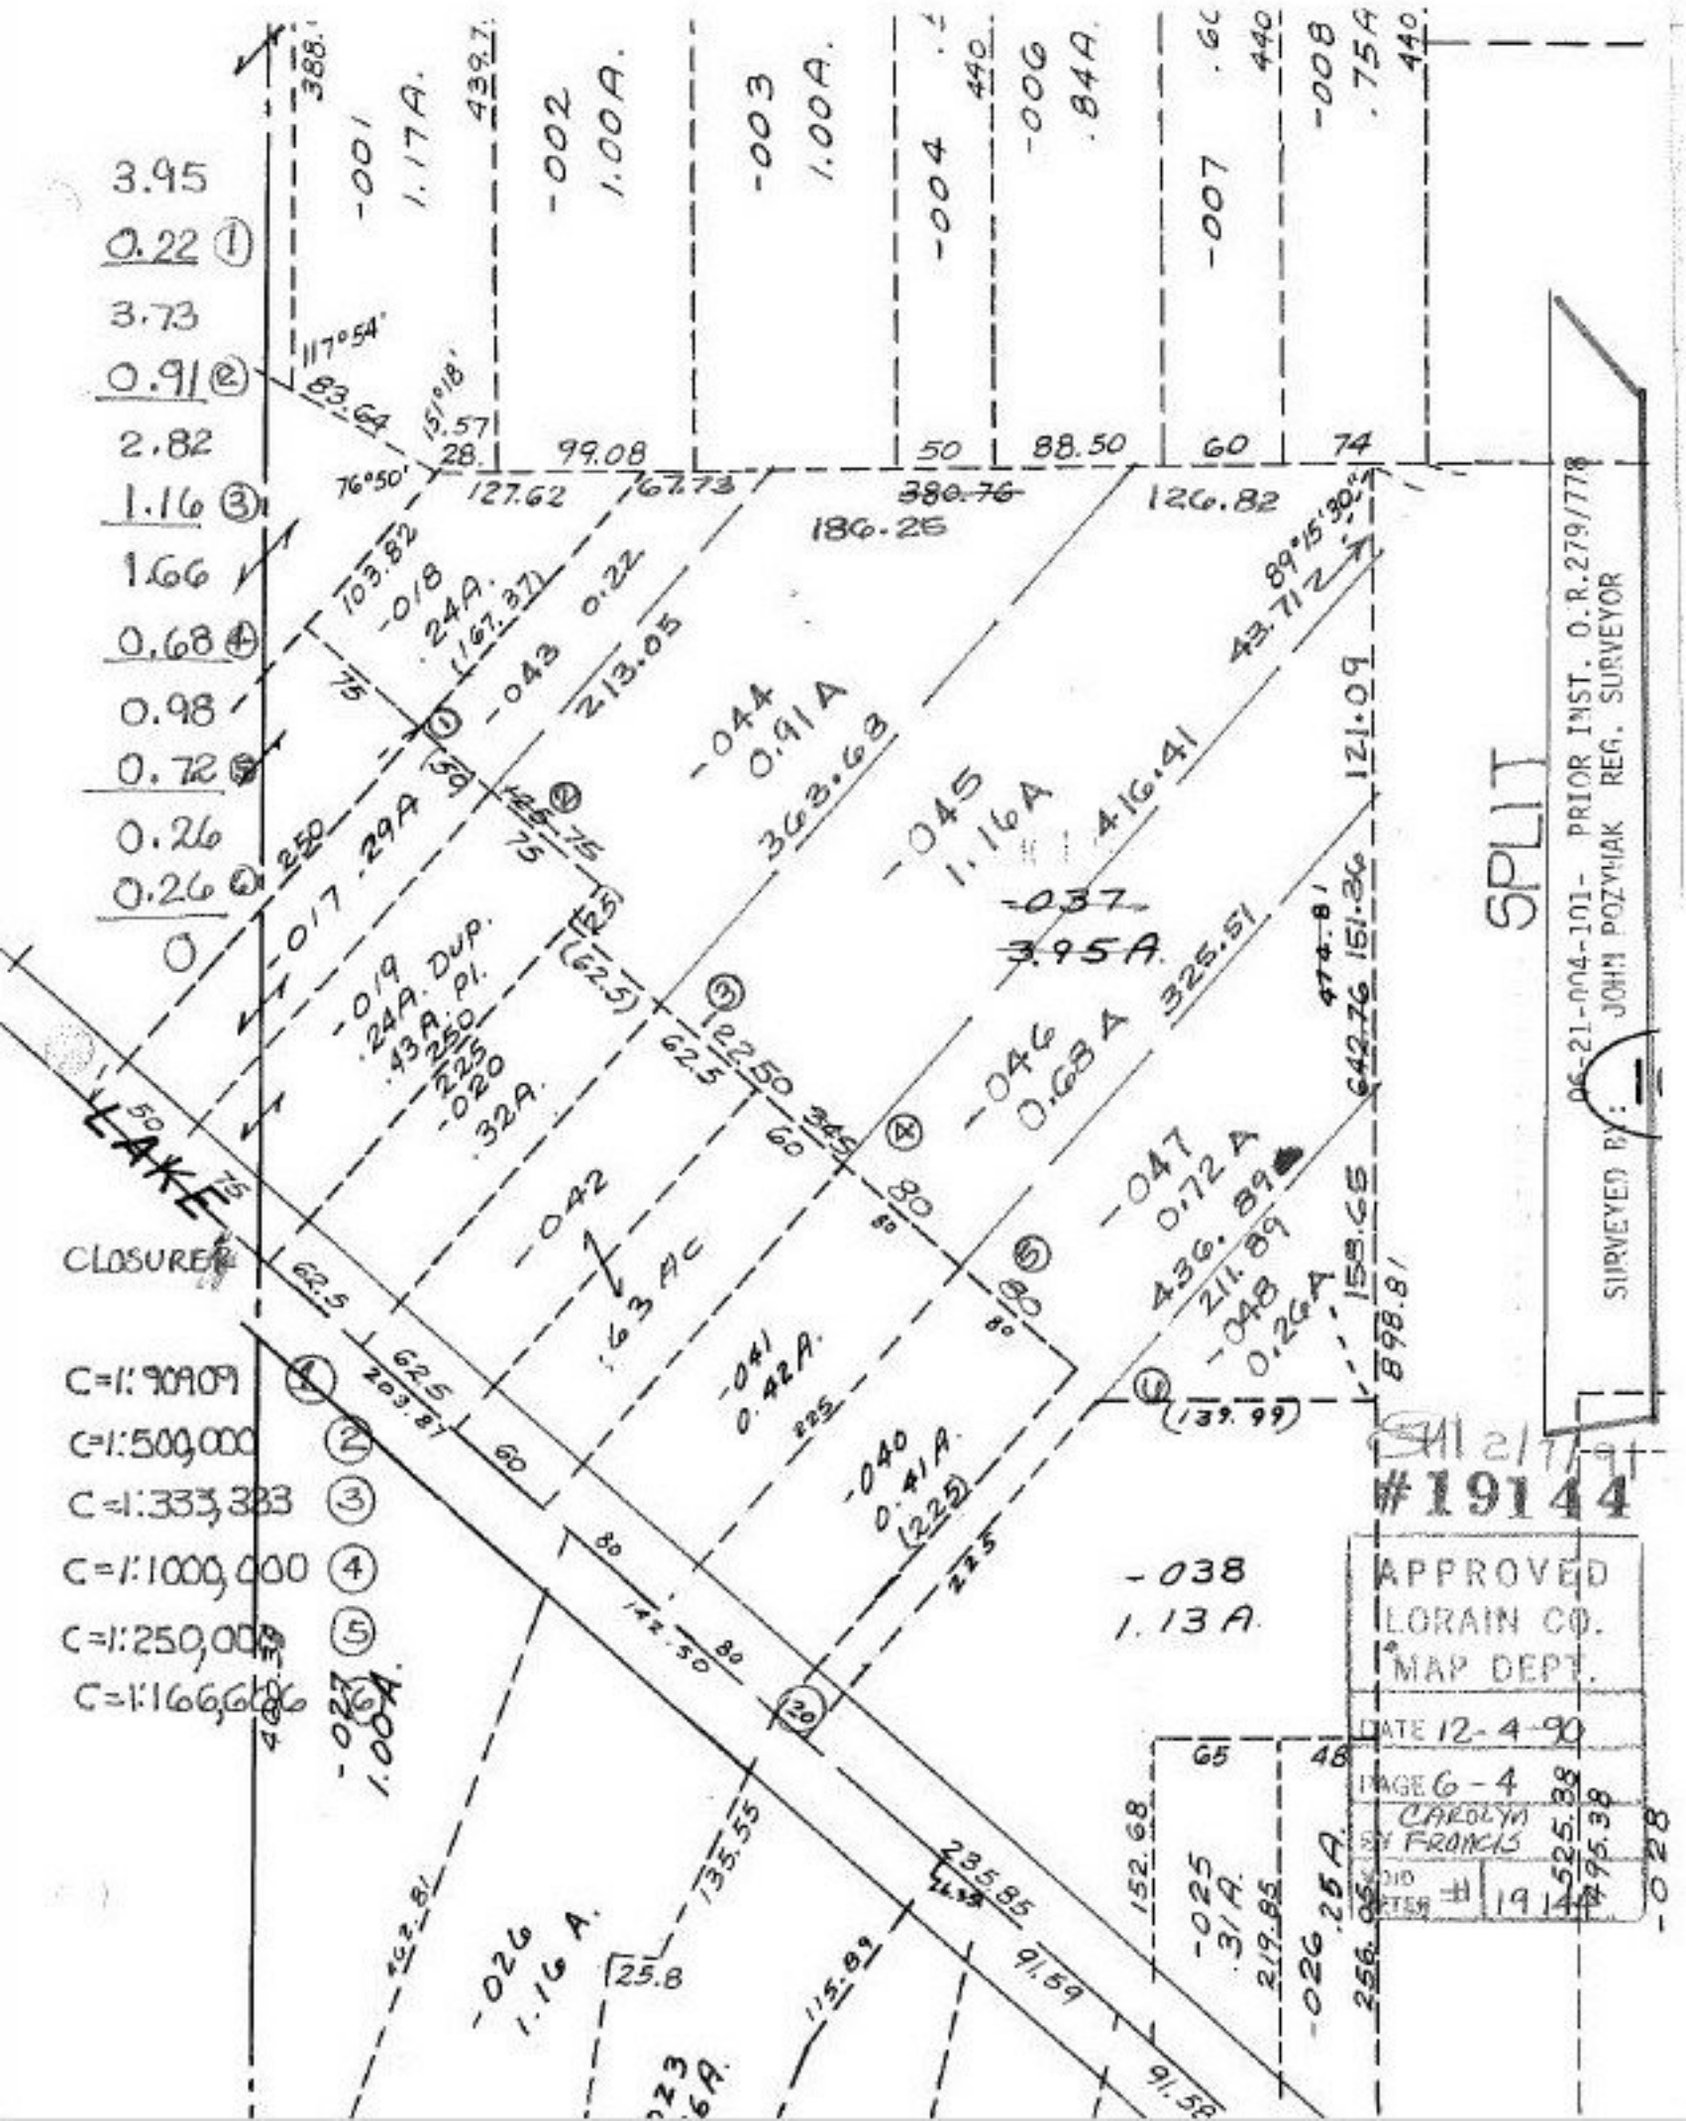
SPLIT
06-21-004-101- PRIOR INST. O.R.279/778
JOHN POZYMAK REG. SURVEYOR
SURVEYED BY:
LAKE
CLOSURE
C=1:90909
C=1:500,000
C=1:333,333
C=1:1000,000
C=1:250,000
C=1:166,666
-001 1.17A.
-002 1.00A.
-003 1.00A.
-004
-006 .84A.
-007
-008 .75A
-018 .24A.
-019 .24A. DUP. .43A. PL. .020 .32A.
-017 .29A
-043 0.22
-044 0.91A
-045 1.16A
-037 3.95A.
-046 0.68A
-047 0.72A
-048 0.26A
-042 .63 AC
-041 0.42A.
-040 0.41A.
-038 1.13A.
-026 1.16A.
-025 .31A.
-027 1.00A.
-023 .26A.
#19144
APPROVED
LORAIN CO.
MAP DEPT.
DATE 12-4-90
PAGE 6-4
BY CAROLYN FRANCIS
MAP NO. #19144