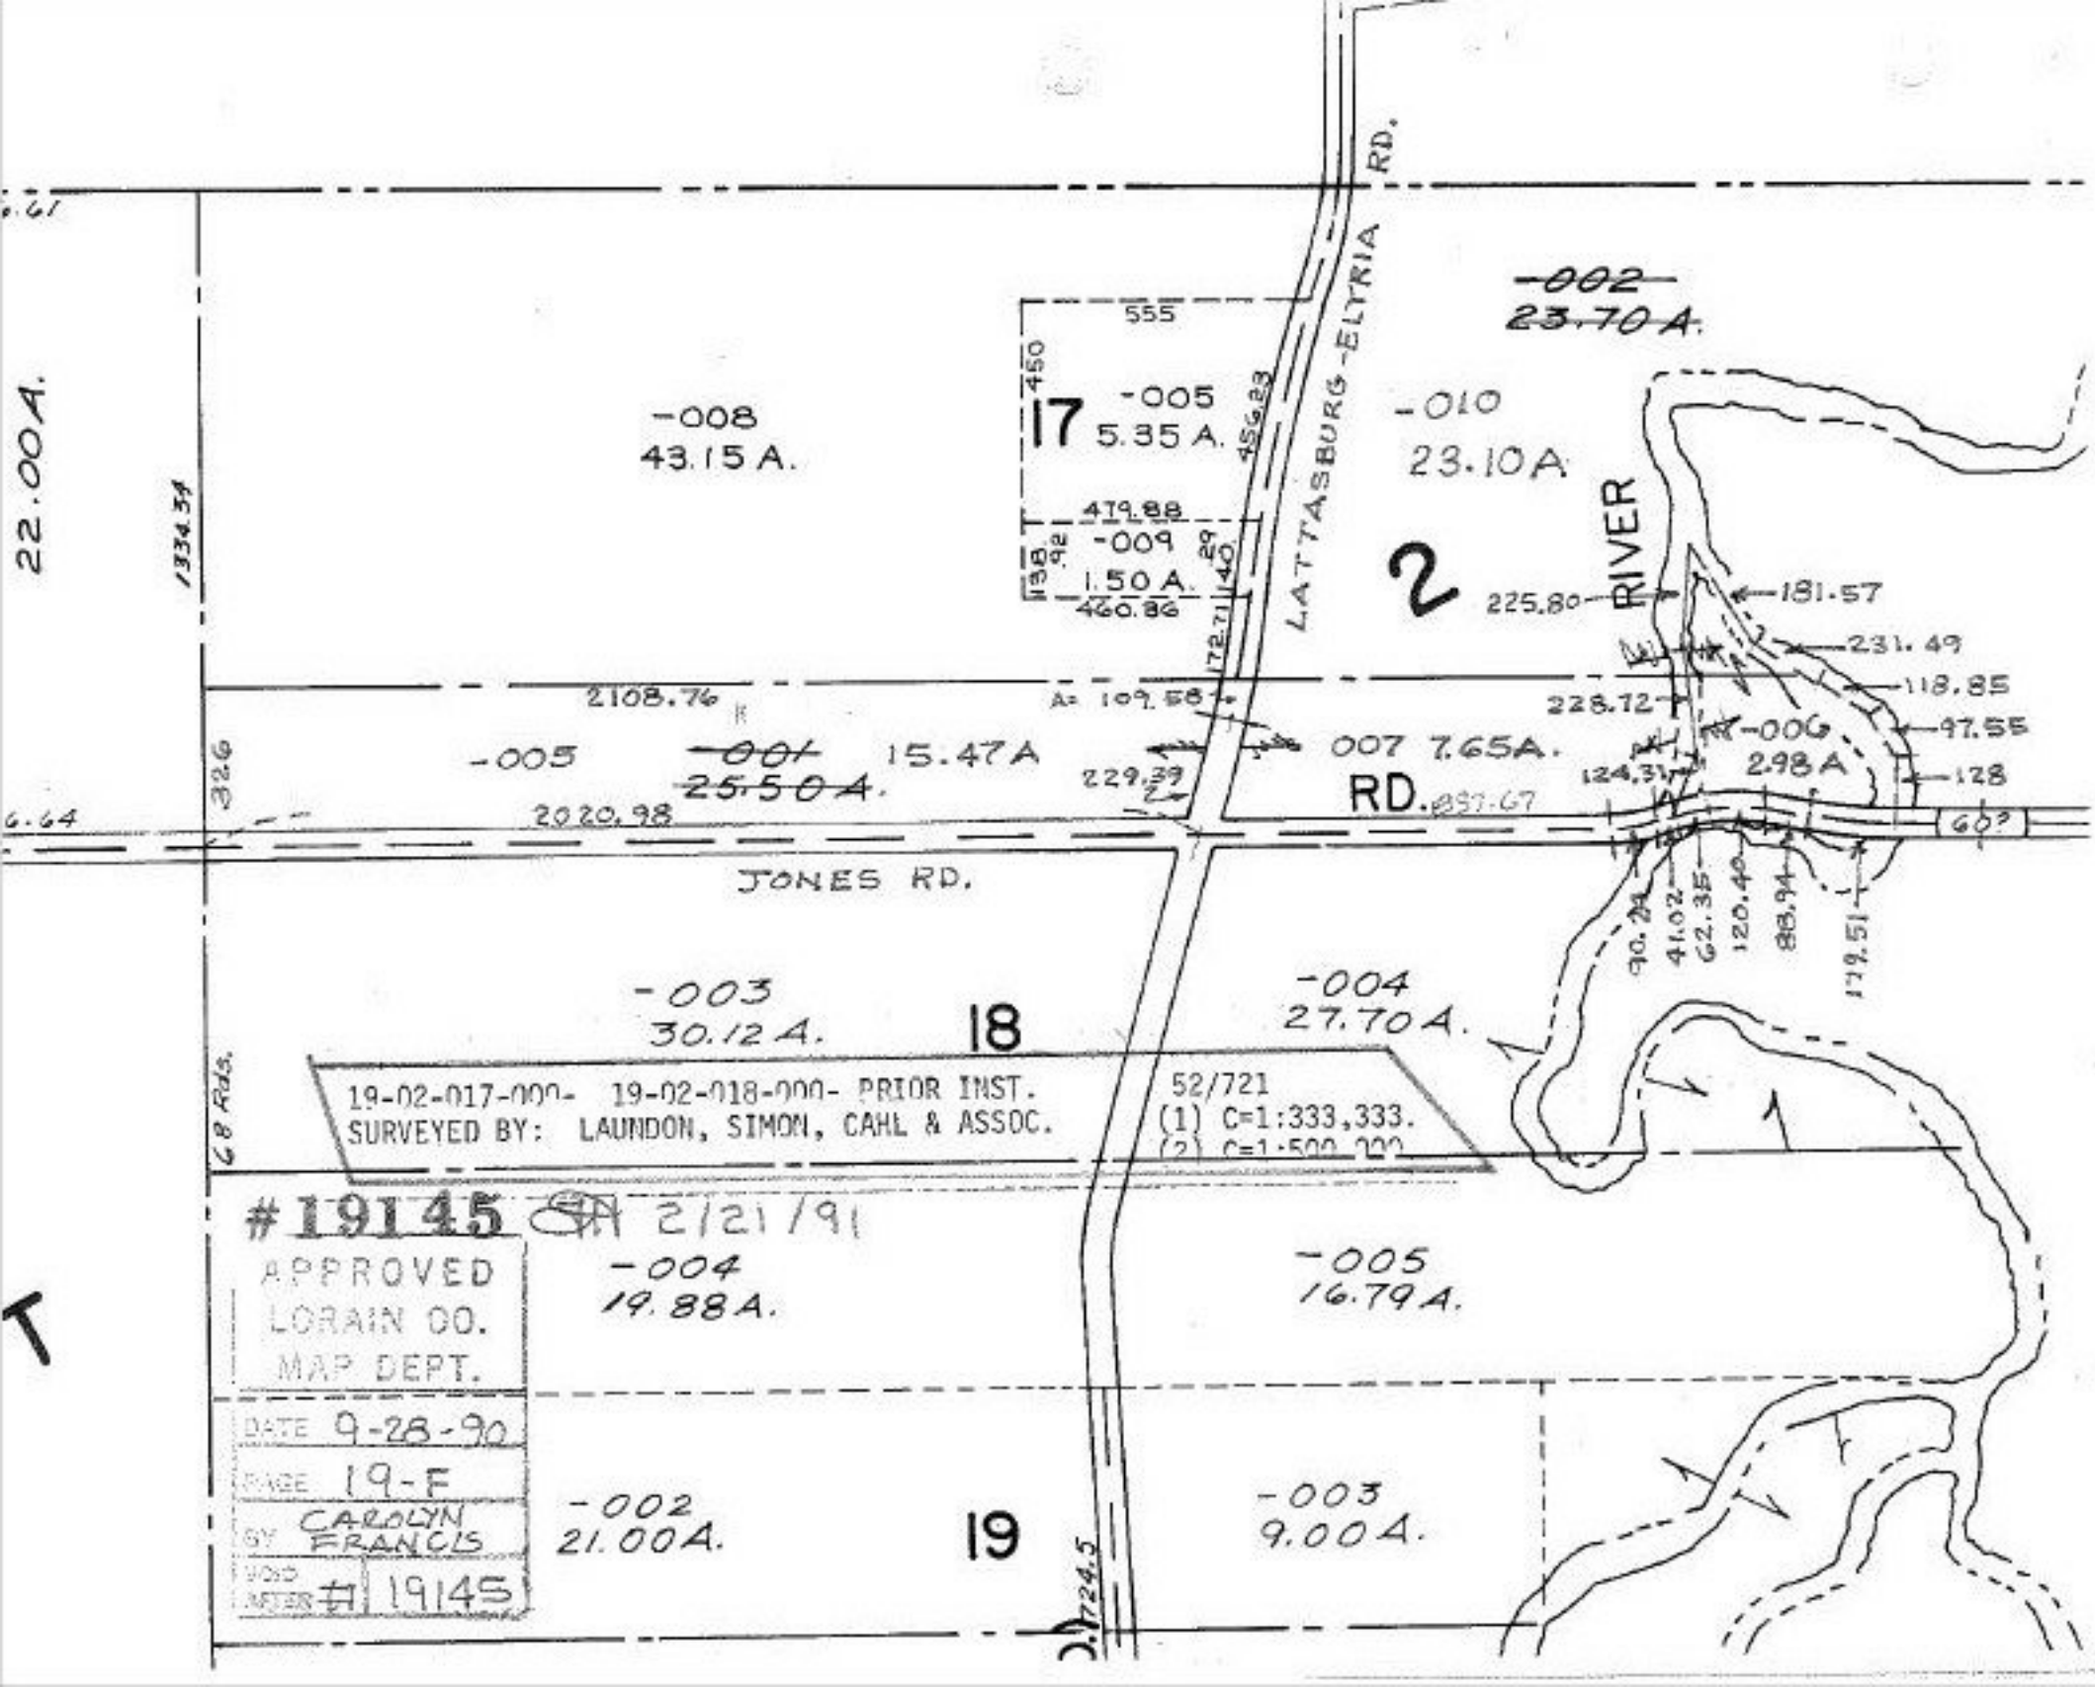
22.00A.
1334.54
-008
43.15 A.
555
17
-005
5.35 A.
450
456.83
419.88
-009
1.50 A.
460.86
138.92
29
40
172.71
-010
23.10A
-002
23.70 A.
LATTASBURG-ELYRIA RD.
RIVER
225.80
181.57
231.49
118.85
97.55
128
228.72
-006
2.98 A
124.31
2108.76
A= 109.58
229.39
-005
-001
25.50A.
15.47A
007 7.65A.
RD. 057-67
2020.98
JONES RD.
60'
90.24
41.02
62.35
120.40
88.94
179.51
326
-003
30.12 A.
18
-004
27.70 A.
68 Rds.
19-02-017-000- 19-02-018-000- PRIOR INST.
SURVEYED BY: LAUNDON, SIMON, CAHL & ASSOC.
52/721
(1) C=1:333,333.
(2) C=1:500,000
#19145 2/21/91
APPROVED
LORAIN CO.
MAP DEPT.
DATE 9-28-90
PAGE 19-F
BY CAROLYN FRANCIS
-004
19.88A.
-005
16.79A.
-002
21.00A.
19
-003
9.00A.
1724.5