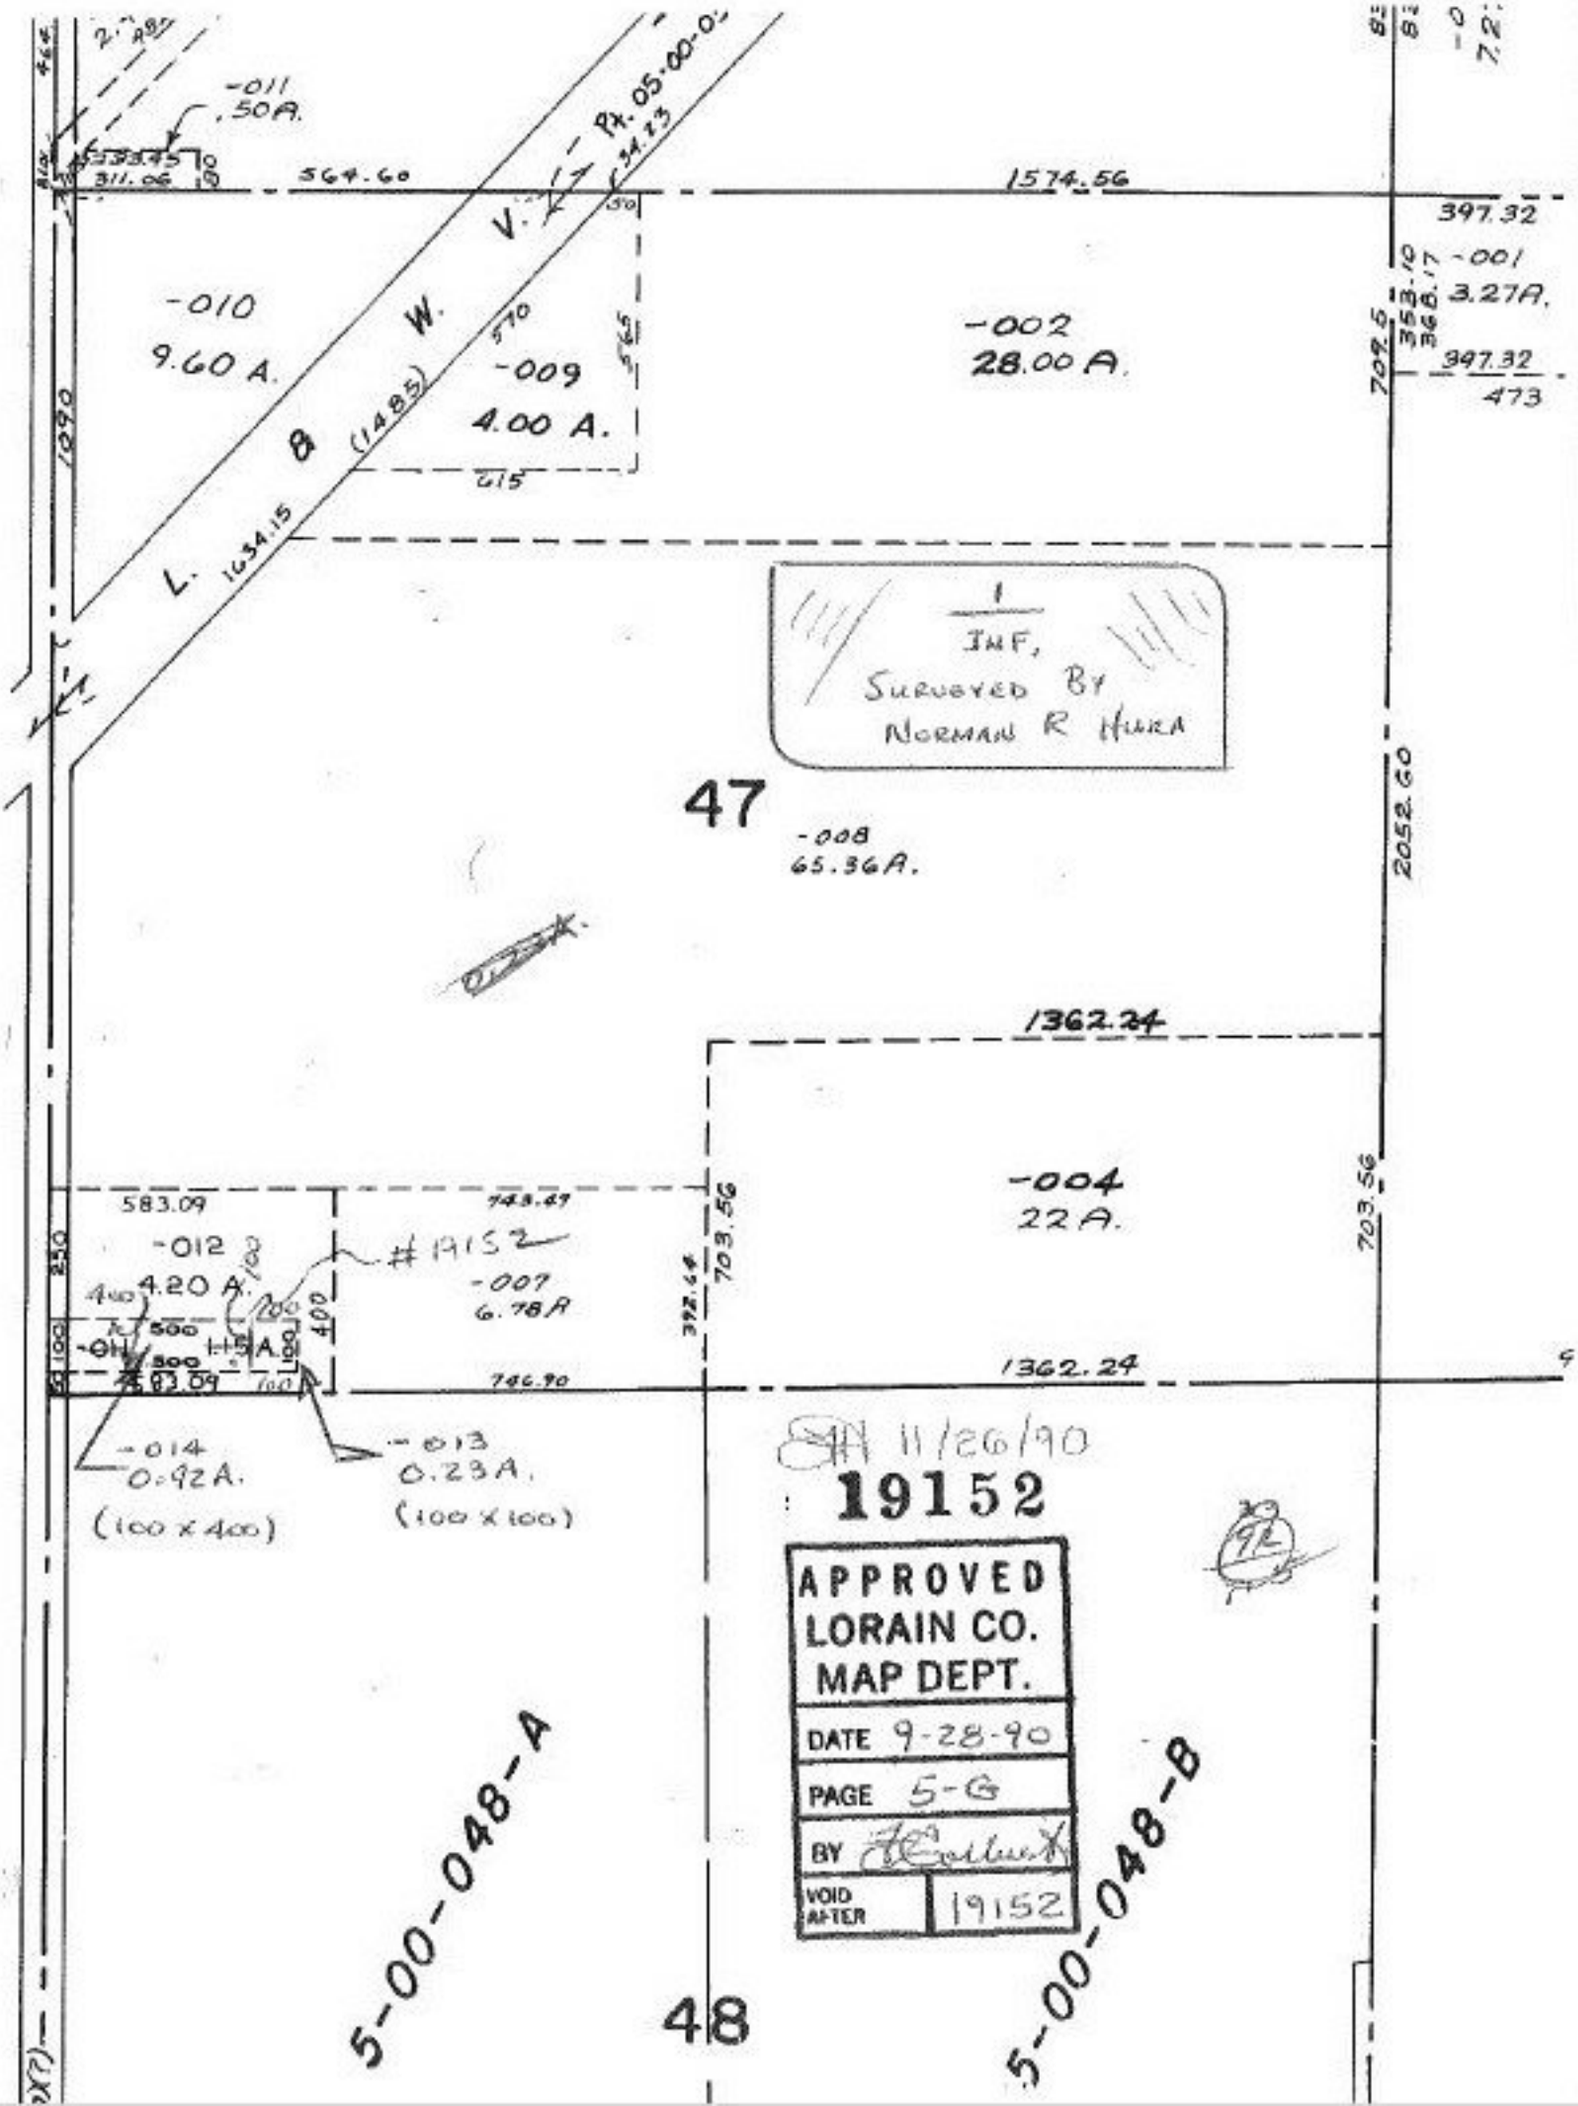
-011
.50A.
564.60
1574.56
397.32
-001
3.27A.
-010
9.60 A.
-009
4.00 A.
-002
28.00 A.
1090
L. 1634.15
(1485)
Pt. 05-00-0-
34.13
1
IMF,
SURVEYED BY
NORMAN R HURA
47
-008
65.36A.
2052.60
1362.24
-004
22A.
703.56
583.09
-012
4.20 A.
#19152
-007
6.78A
-014
0.92A.
(100 x 400)
-013
0.23A.
(100 x 100)
11/26/90
19152
APPROVED
LORAIN CO.
MAP DEPT.
DATE 9-28-90
PAGE 5-G
BY
VOID AFTER 19152
5-00-048-A
48
5-00-048-B