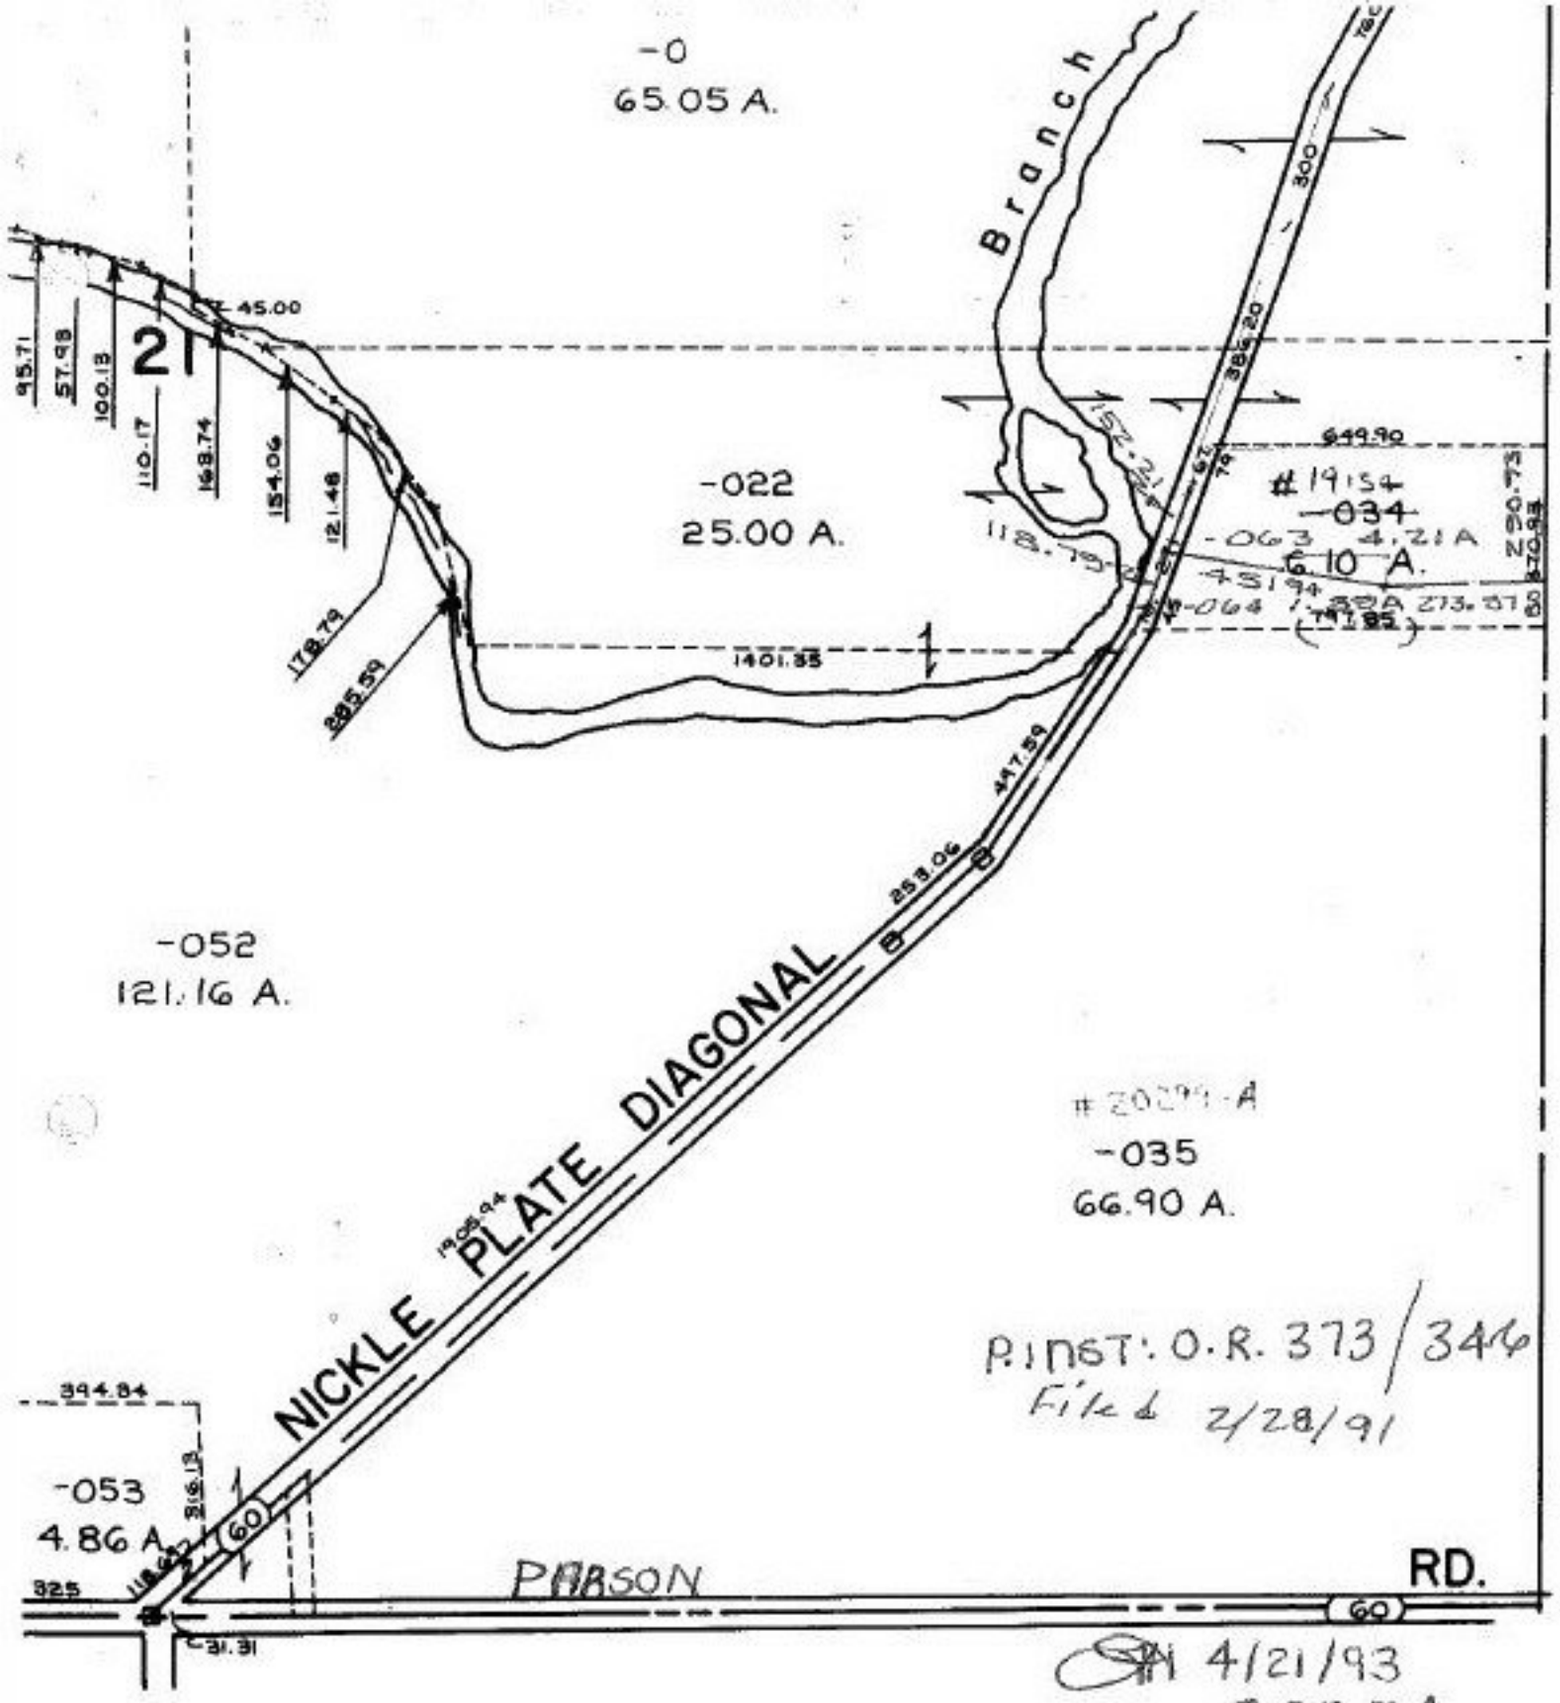
-0
65.05 A.
Branch
Pt. 10-00-022-0
Pt. 11.65 A.
45.00
2
95.71
57.98
100.13
110.17
168.74
154.06
121.48
178.79
285.59
1401.85
-022
25.00 A.
152.24
118.79
649.90
#19154
-034
-063 4.21 A
6.10 A.
45194
-064 1.89A 273.57
(74185)
290.73
370.93
447.59
253.06
1906.94
-052
121.16 A.
#20291-A
-035
66.90 A.
NICKLE PLATE DIAGONAL
P.INST: O.R. 373/346
Filed 2/28/91
394.84
-053
4.86 A
316.13
118.62
60
325
PARSON
RD.
31.31
4/21/93
19154
APPROVED
LORAIN CO.
MAP DEPT.
DATE 10-1-90
PAGE 10-E
BY CAROLYN FRANCIS
VOID AFTER # 19154