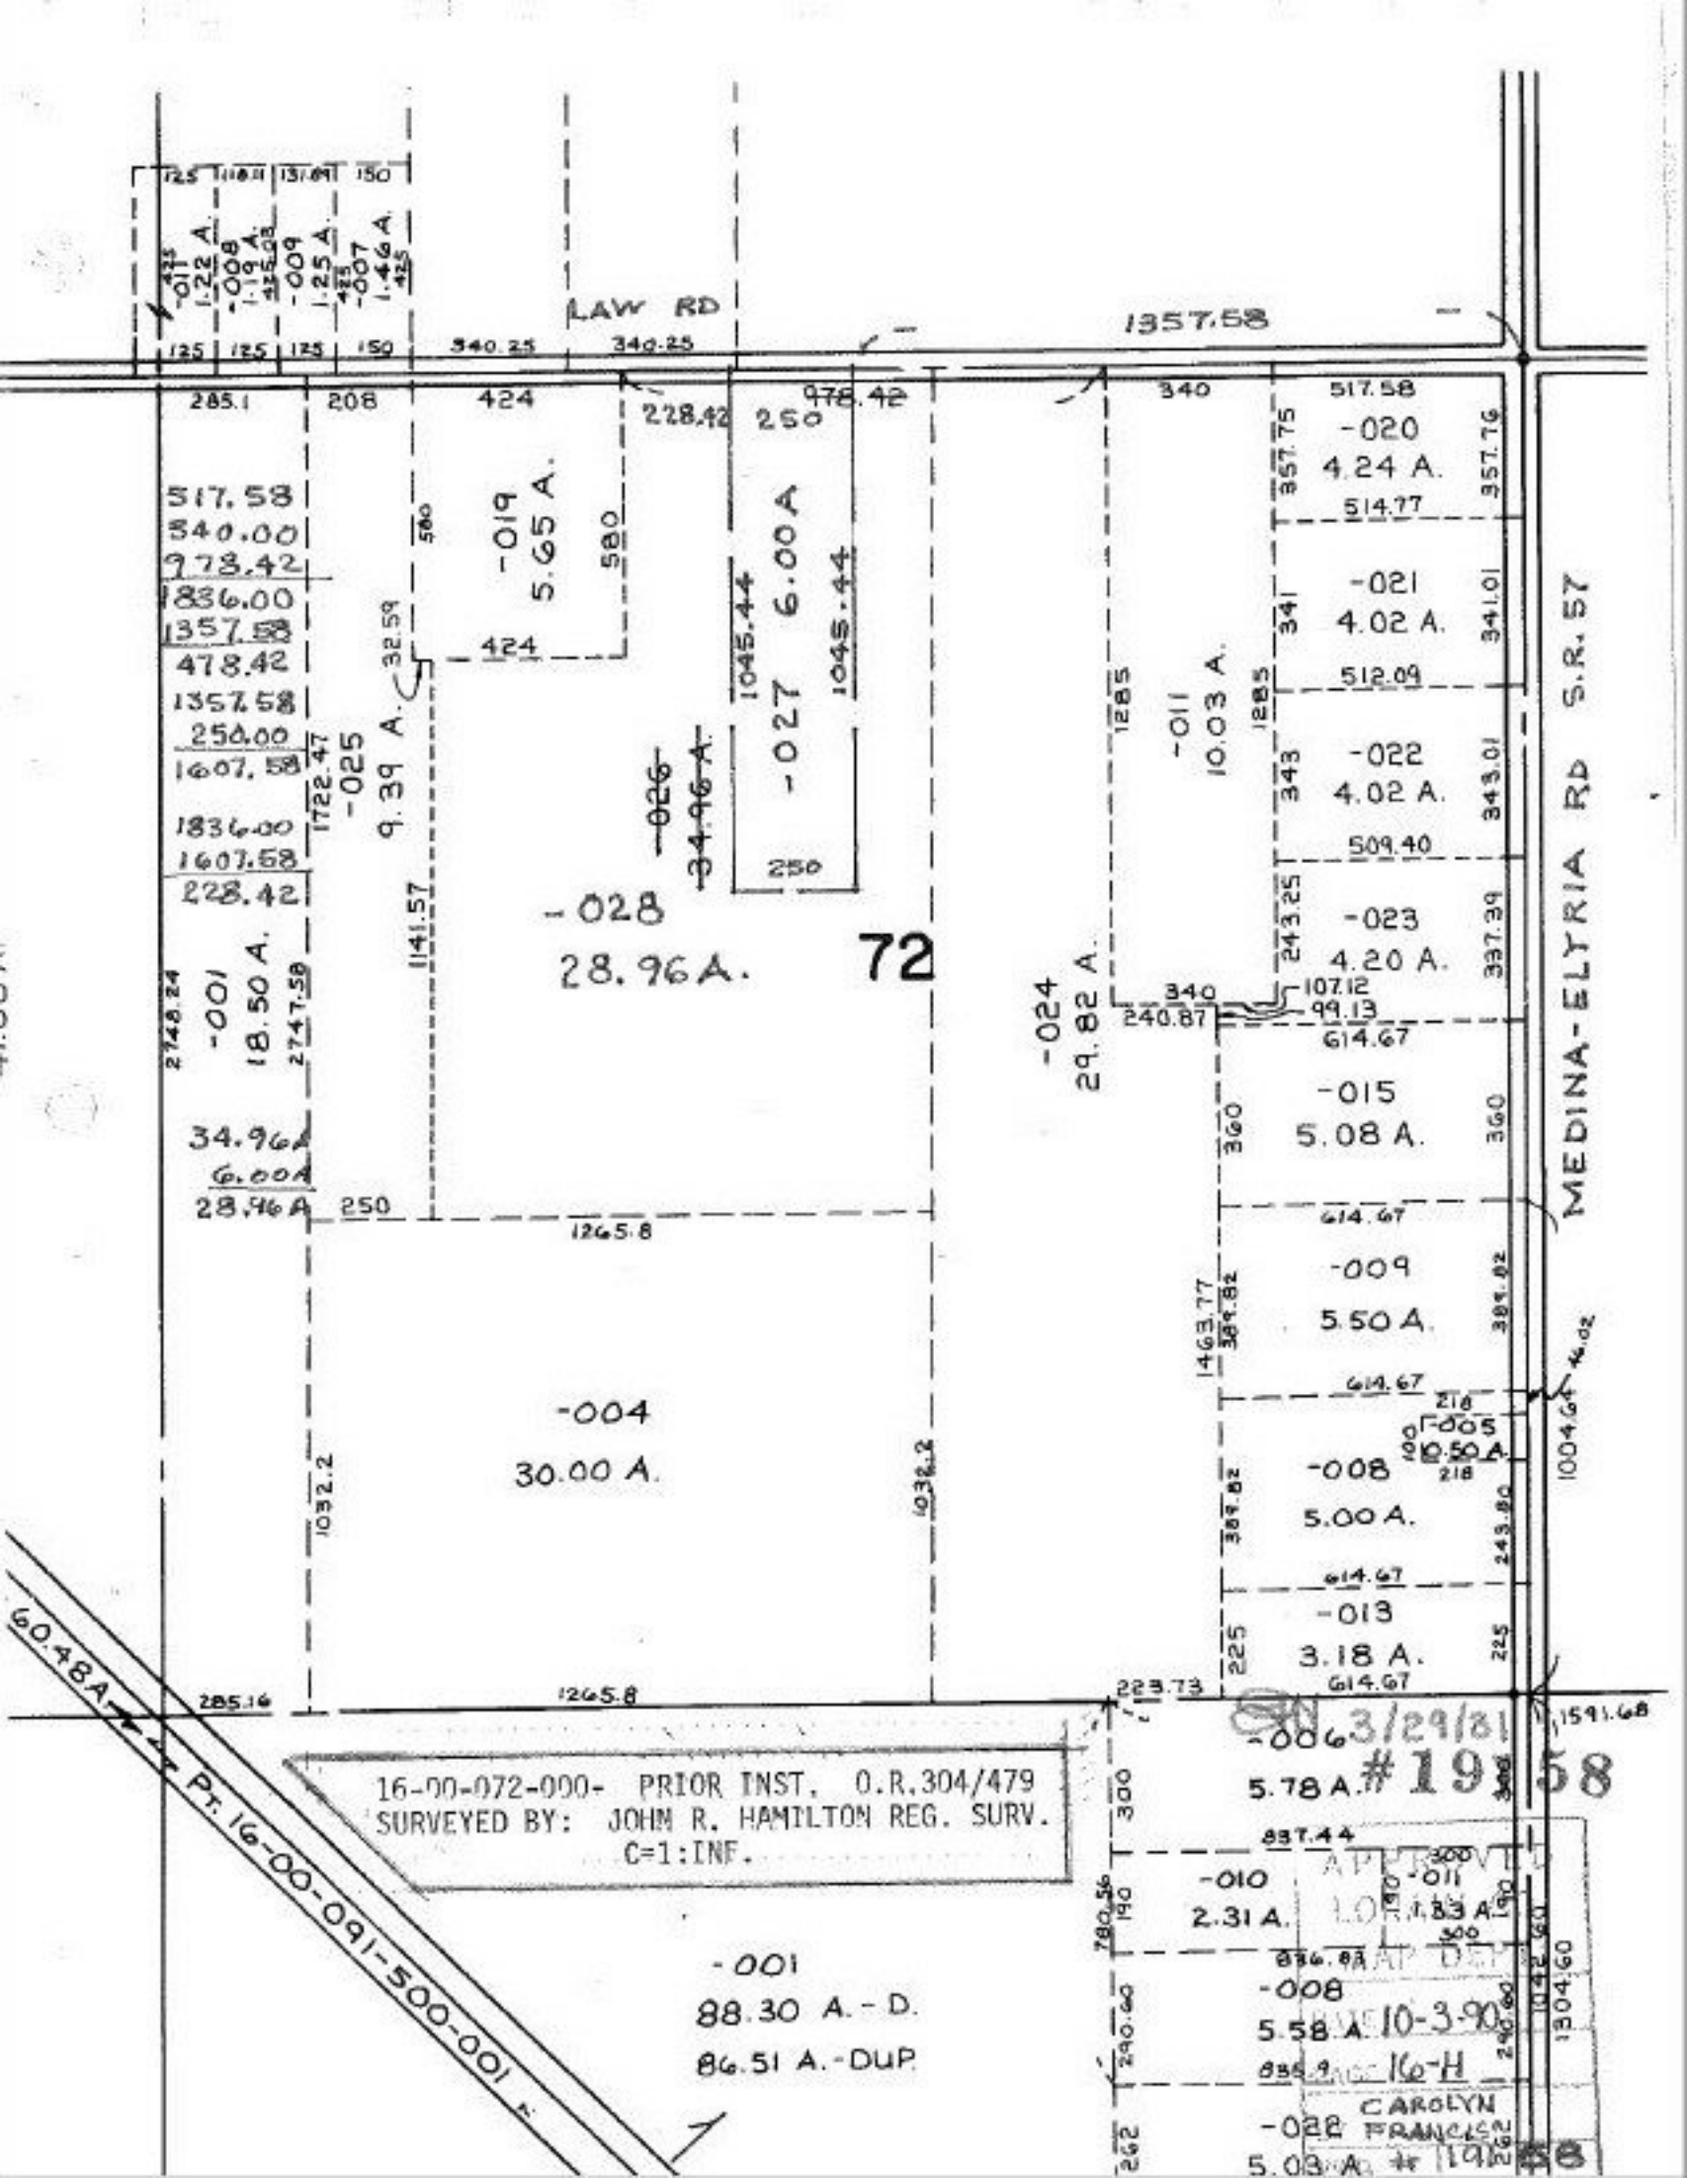
LAW RD
1357.58
MEDINA-ELYRIA RD S.R. 57
-011 1.22 A.
-008 1.19 A.
-009 1.25 A.
-007 1.46 A.
-019 5.65 A.
-027 6.00 A.
-026 34.96 A.
-025 9.39 A.
-028 28.96 A.
72
-001 18.50 A.
-024 29.82 A.
-011 10.03 A.
-020 4.24 A.
-021 4.02 A.
-022 4.02 A.
-023 4.20 A.
-015 5.08 A.
-009 5.50 A.
-004 30.00 A.
-008 5.00 A.
-013 3.18 A.
-006 5.78 A.
-010 2.31 A.
-011 1.83 A.
-008 5.58 A.
-001 88.30 A. - D.
86.51 A. - DUP
60.48 A.
Pt. 16-00-091-500-001
16-00-072-000- PRIOR INST. O.R.304/479
SURVEYED BY: JOHN R. HAMILTON REG. SURV.
C=1:INF.
3/29/81
#19
APPROVED
10-3-90
16-H
CAROLYN FRANCES