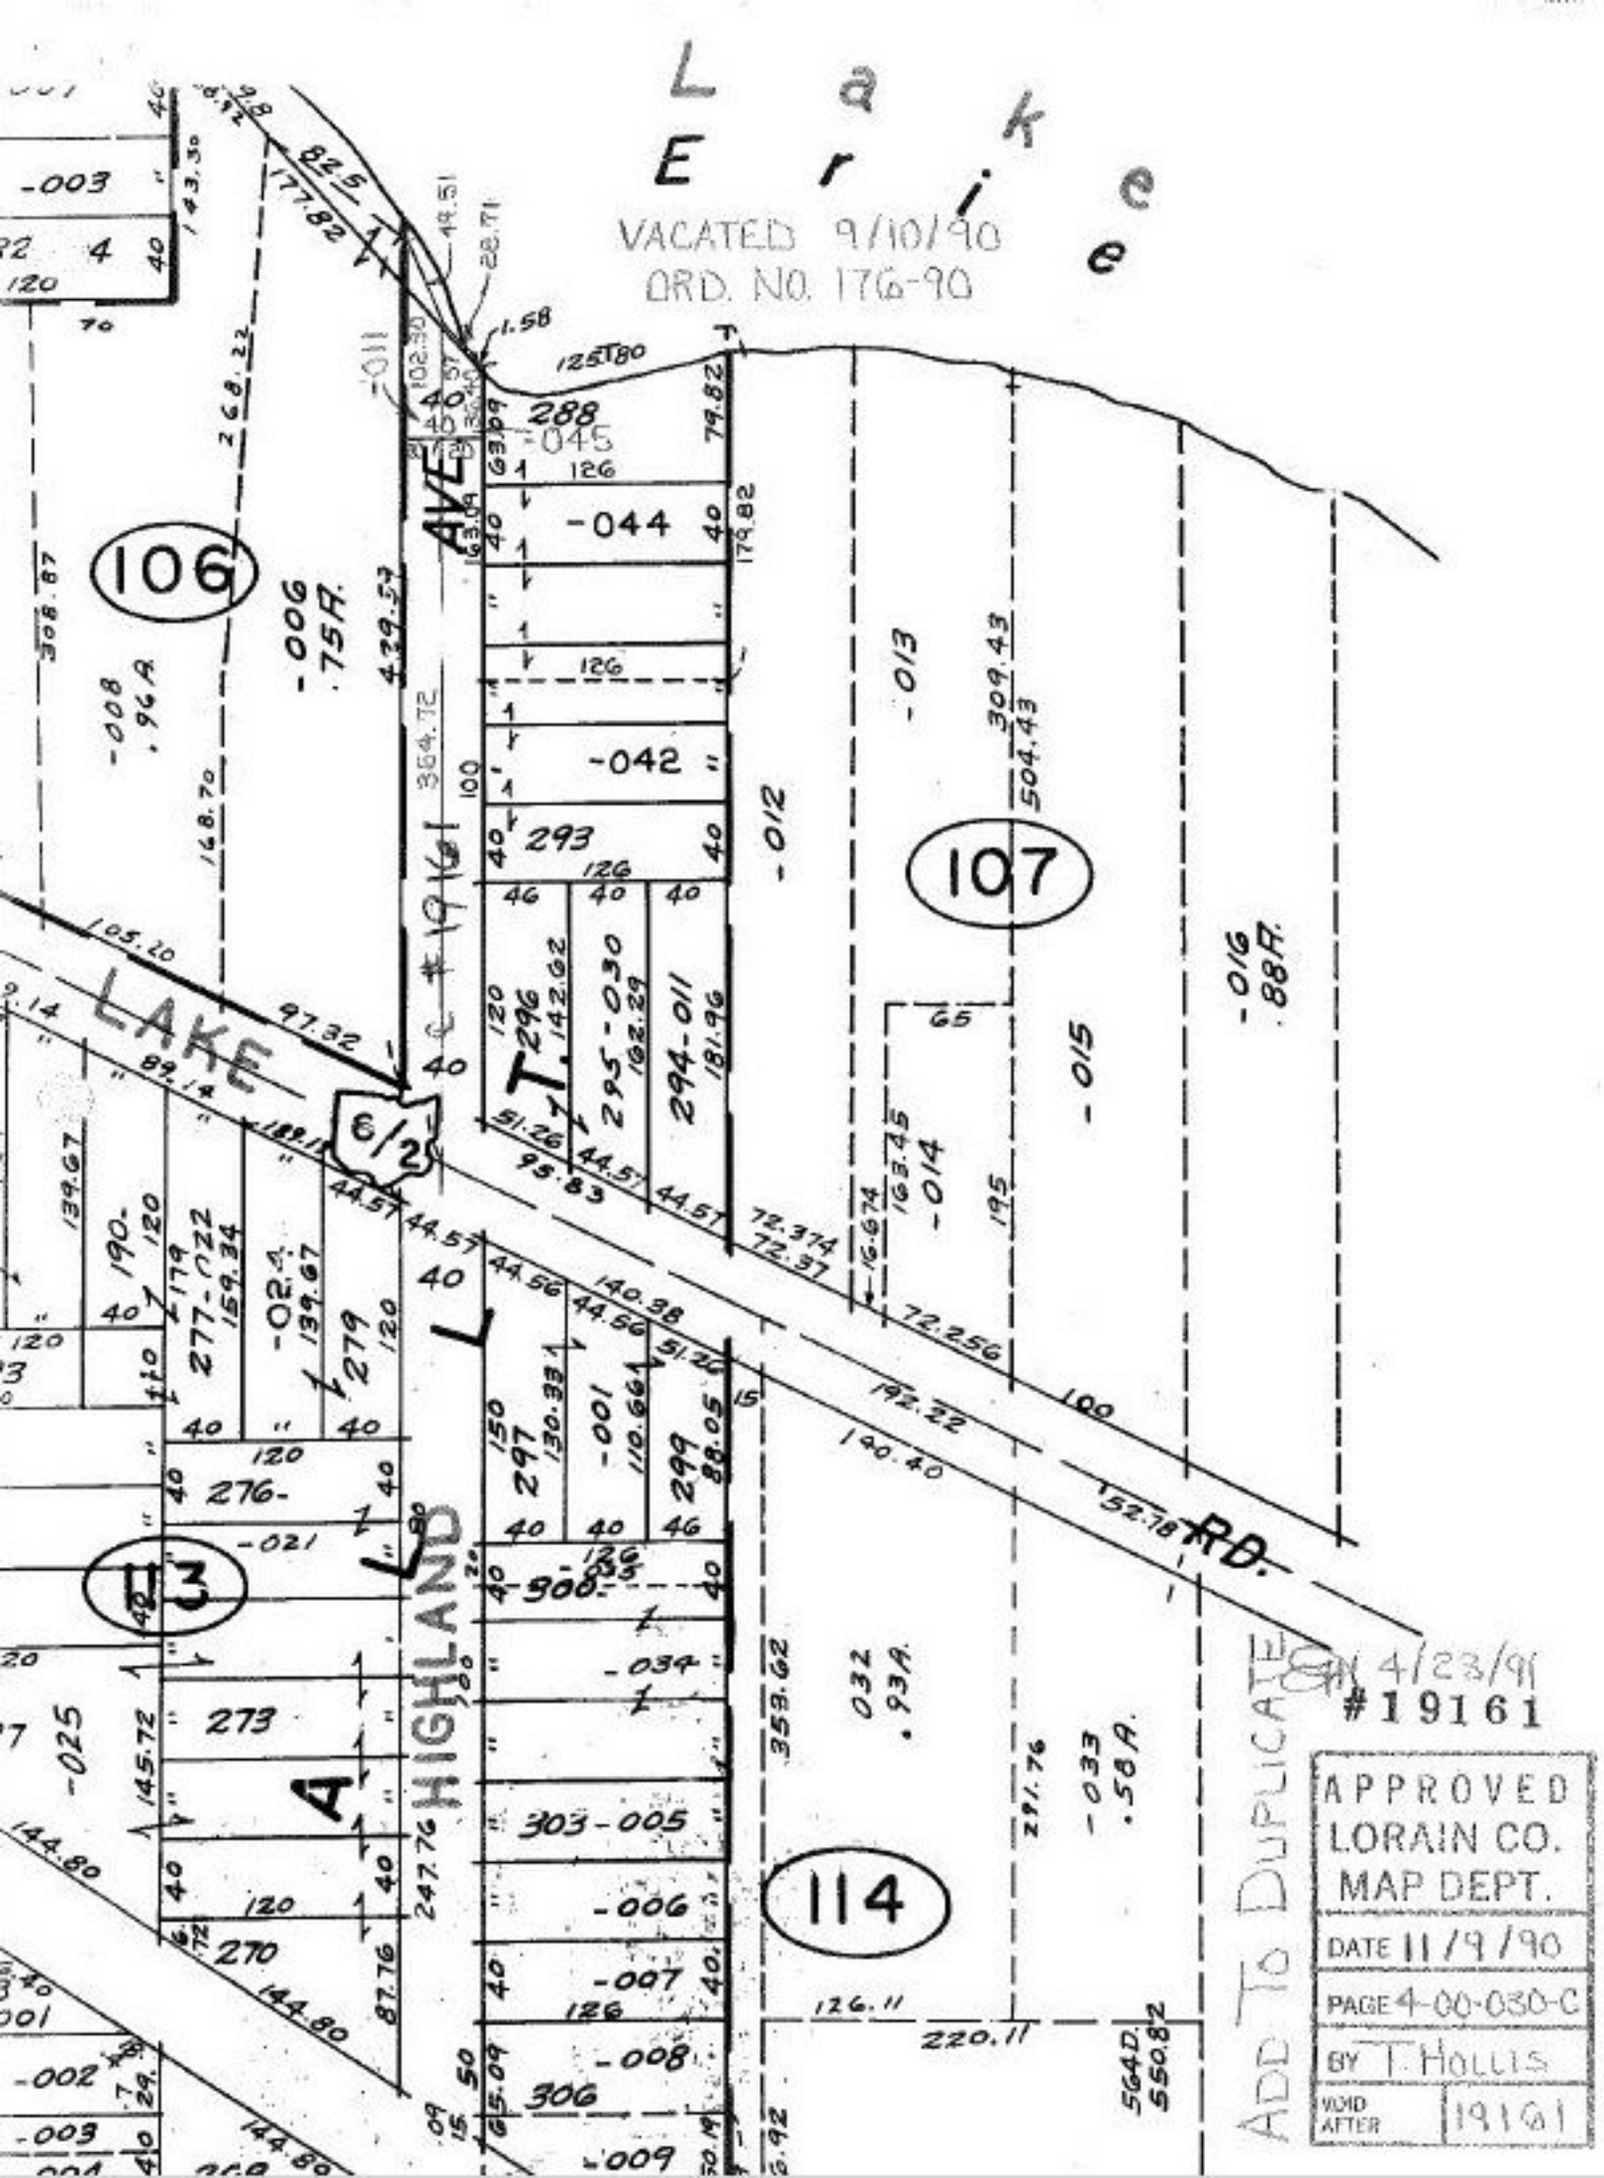
Lake Erie
VACATED 9/10/90
ORD. NO. 176-90
106
107
114
113
LAKE
HIGHLAND
AVE
RD.
#19161
ADD TO DUPLICATE
4/23/91
#19161
APPROVED
LORAIN CO.
MAP DEPT.
DATE 11/9/90
PAGE 4-00-030-C
BY T. HOLLIS
VOID AFTER 19161