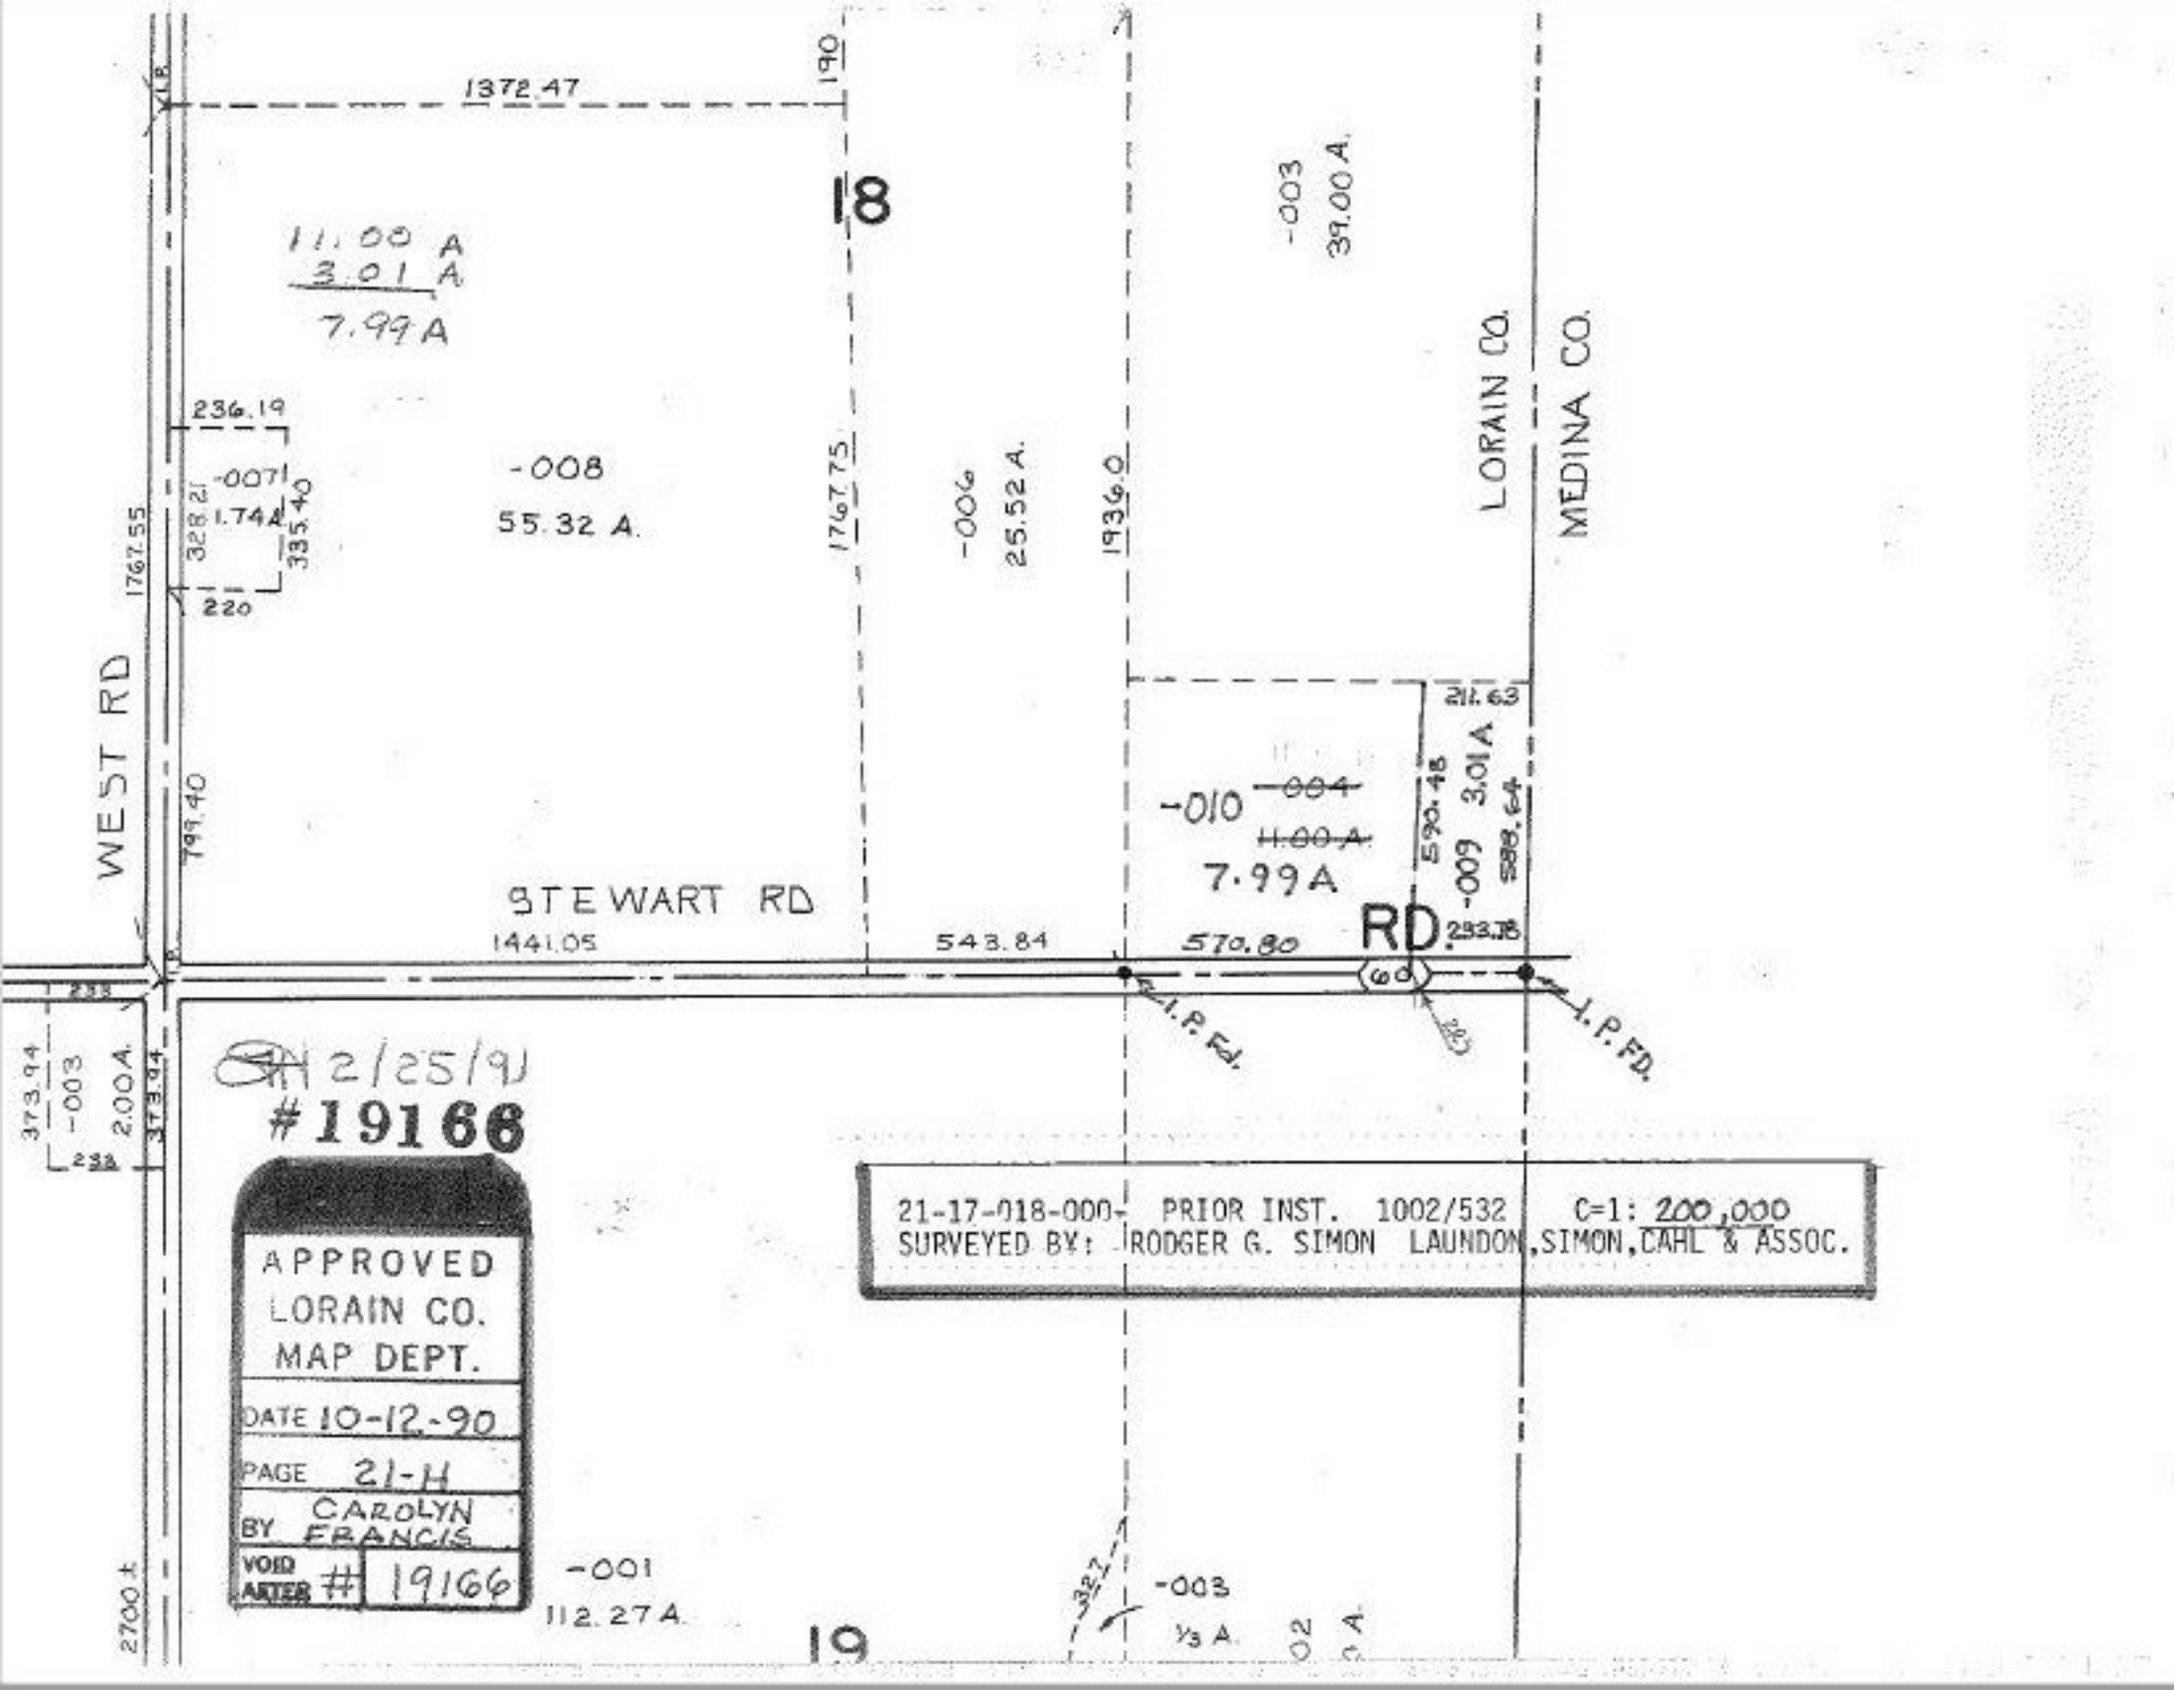
1372.47
18
11.00 A
3.01 A
7.99 A
-003
39.00 A.
LORAIN CO.
MEDINA CO.
236.19
-007
1.74 A
328.21
335.40
220
-008
55.32 A.
1767.55
1767.75
-006
25.52 A.
1939.0
WEST RD
799.40
-010
-004
11.00 A.
7.99 A
211.63
590.48
3.01 A
-009
538.64
STEWART RD
1441.05
543.84
570.80
RD.
253.18
60
I.P. FD.
I.P. FD.
373.94
-003
2.00 A.
232
373.94
2700 ±
2/25/91
#19166
APPROVED
LORAIN CO.
MAP DEPT.
DATE 10-12-90
PAGE 21-H
BY CAROLYN FRANCIS
VOID AFTER # 19166
-001
112.27 A.
19
327
-003
1/3 A.
02
A.
21-17-018-000- PRIOR INST. 1002/532 C=1: 200,000
SURVEYED BY: RODGER G. SIMON LAUNDON, SIMON, CAHL & ASSOC.