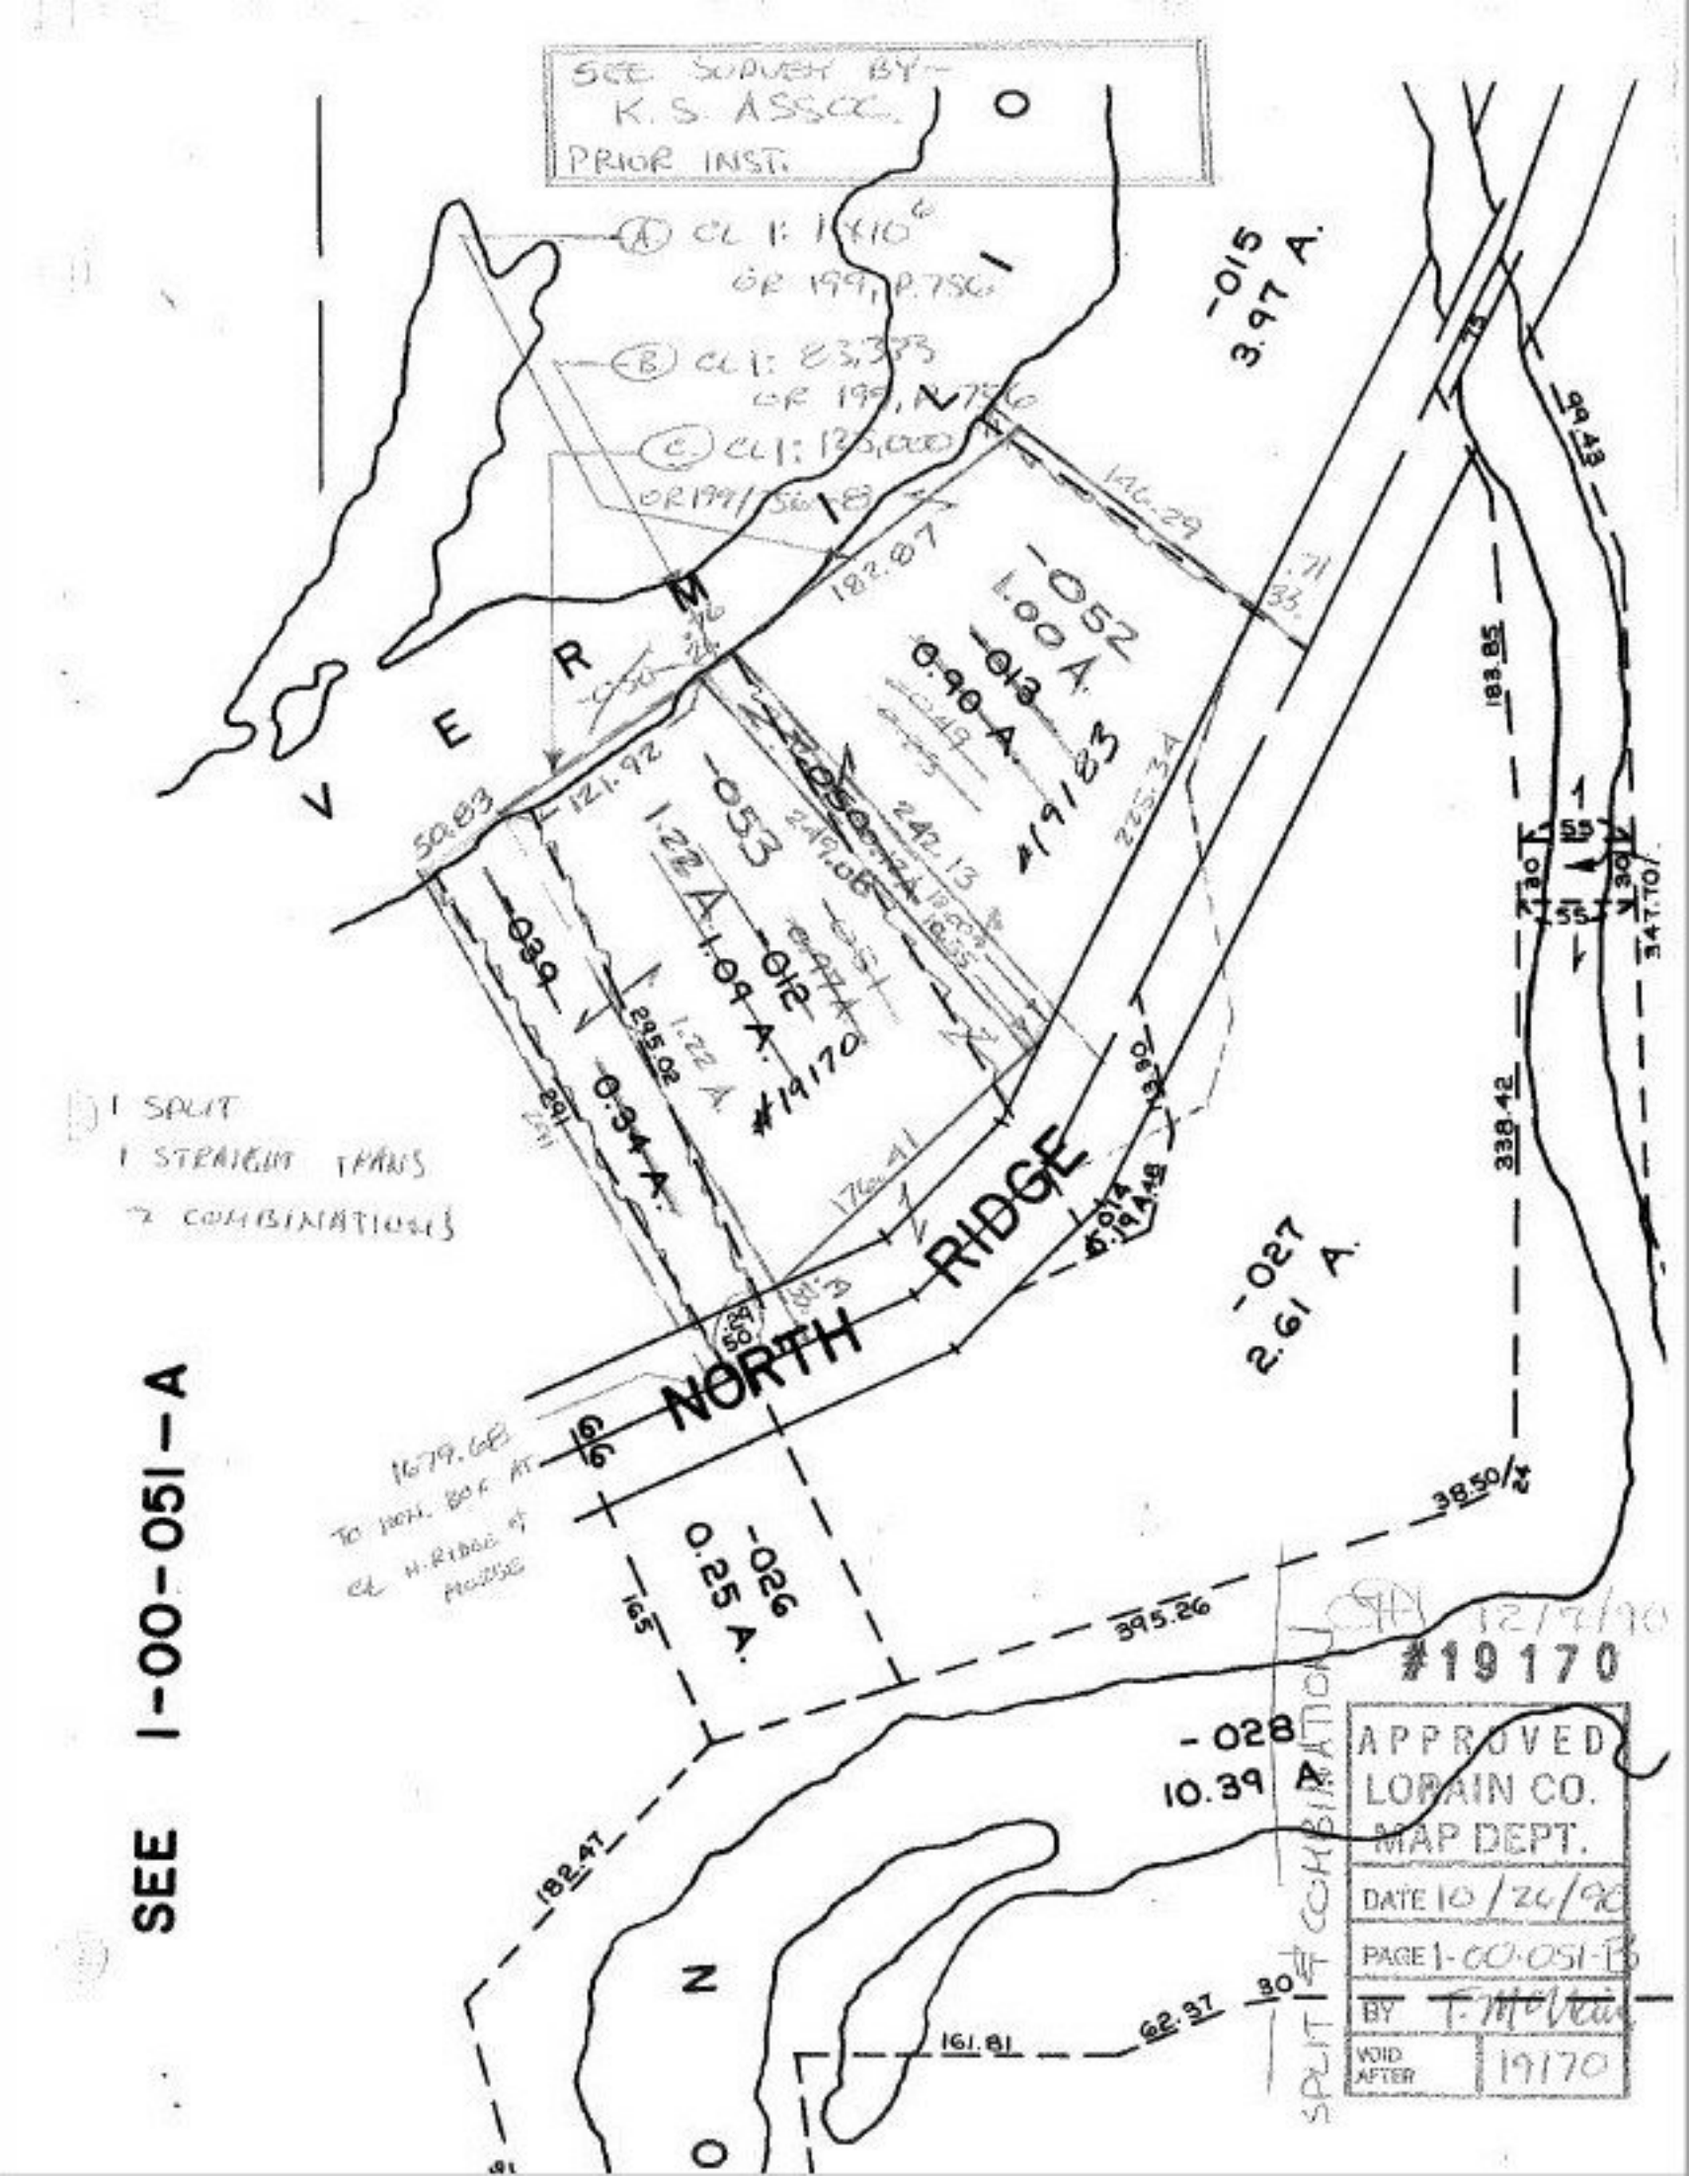
SEE SURVEY BY -
K. S. ASSOC.
PRIOR INST.
A CL 1: 1X10
OR 199, P. 750
B CL 1: E3,333
OR 199, P. 750
C CL 1: 125,000
OR 199, P. 750
-015
3.97 A.
-052
1.00 A.
-013
0.90 A.
#19183
-053
1.22 A.
-012
1.09 A.
#19170
-039
0.94 A.
-027
2.61 A.
-026
0.25 A.
-028
10.39 A.
NORTH RIDGE
NORTH
1679.68
TO INTR. BOF AT
CL N. RIDGE &
HOUSE
1 SPLIT
1 STRAIGHT TRANS
2 COMBINATIONS
SEE 1-00-051-A
12/7/90
#19170
APPROVED
LORAIN CO.
MAP DEPT.
DATE 10/26/90
PAGE 1-00-051-B
BY T. McVeigh
VOID AFTER 19170