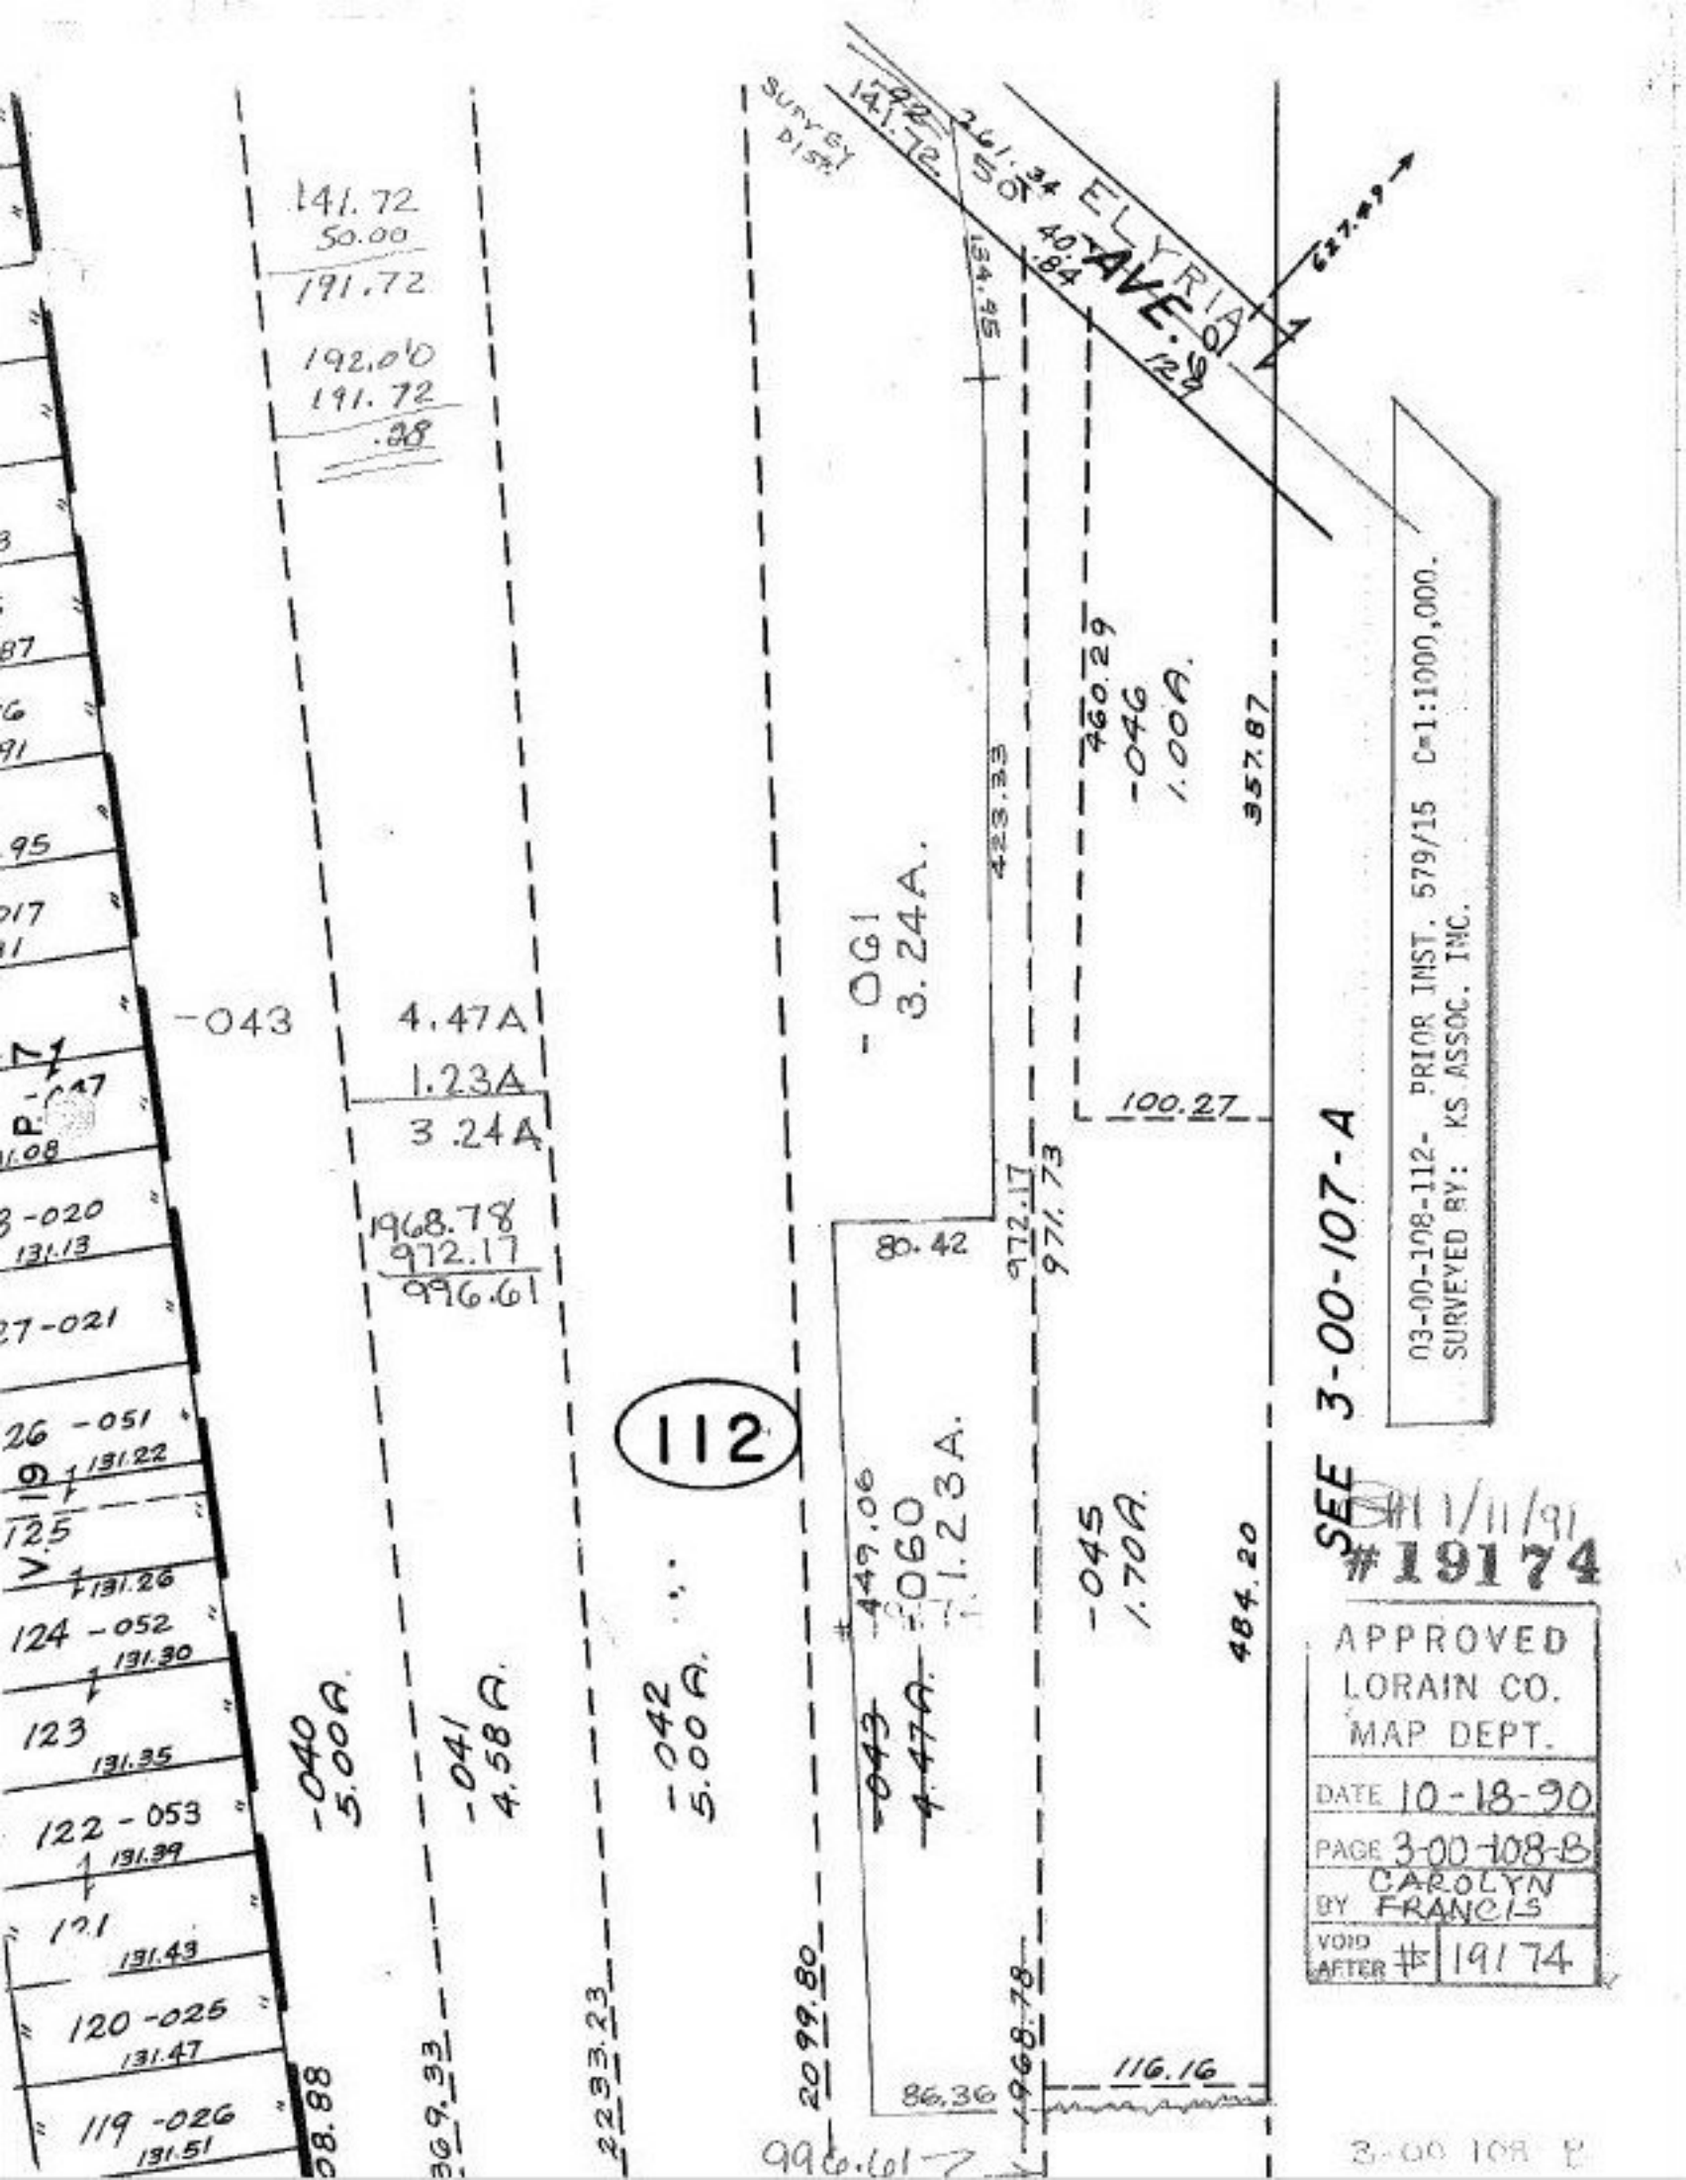

141.72
50.00
191.72
192.00
191.72
.28
SURVEY DISP.
141.72
261.34
ELYRIA
AVE.
627.49
134.95
423.33
460.29
-046
1.00A.
357.87
-043
4.47A
1.23A
3.24A
-061
3.24A.
100.27
1968.78
972.17
996.61
80.42
972.17
971.73
112
-060
1.23A.
449.06
-045
1.70A.
484.20
-040
5.00A.
-041
4.58A.
-042
5.00A.
-043
4.47A.
2099.80
1968.78
116.16
86.36
996.61
2233.23
369.33
-020
131.13
27-021
26-051
131.22
125
131.26
124-052
131.30
123
131.35
122-053
131.39
121
131.43
120-025
131.47
119-026
131.51
03-00-108-112- PRIOR INST. 579/15 C=1:1000,000.
SURVEYED BY: KS ASSOC. INC.
SEE 3-00-107-A
1/11/91
#19174
APPROVED
LORAIN CO.
MAP DEPT.
DATE 10-18-90
PAGE 3-00-108-B
BY CAROLYN FRANCIS
VOID AFTER # 19174
3-00-108-B