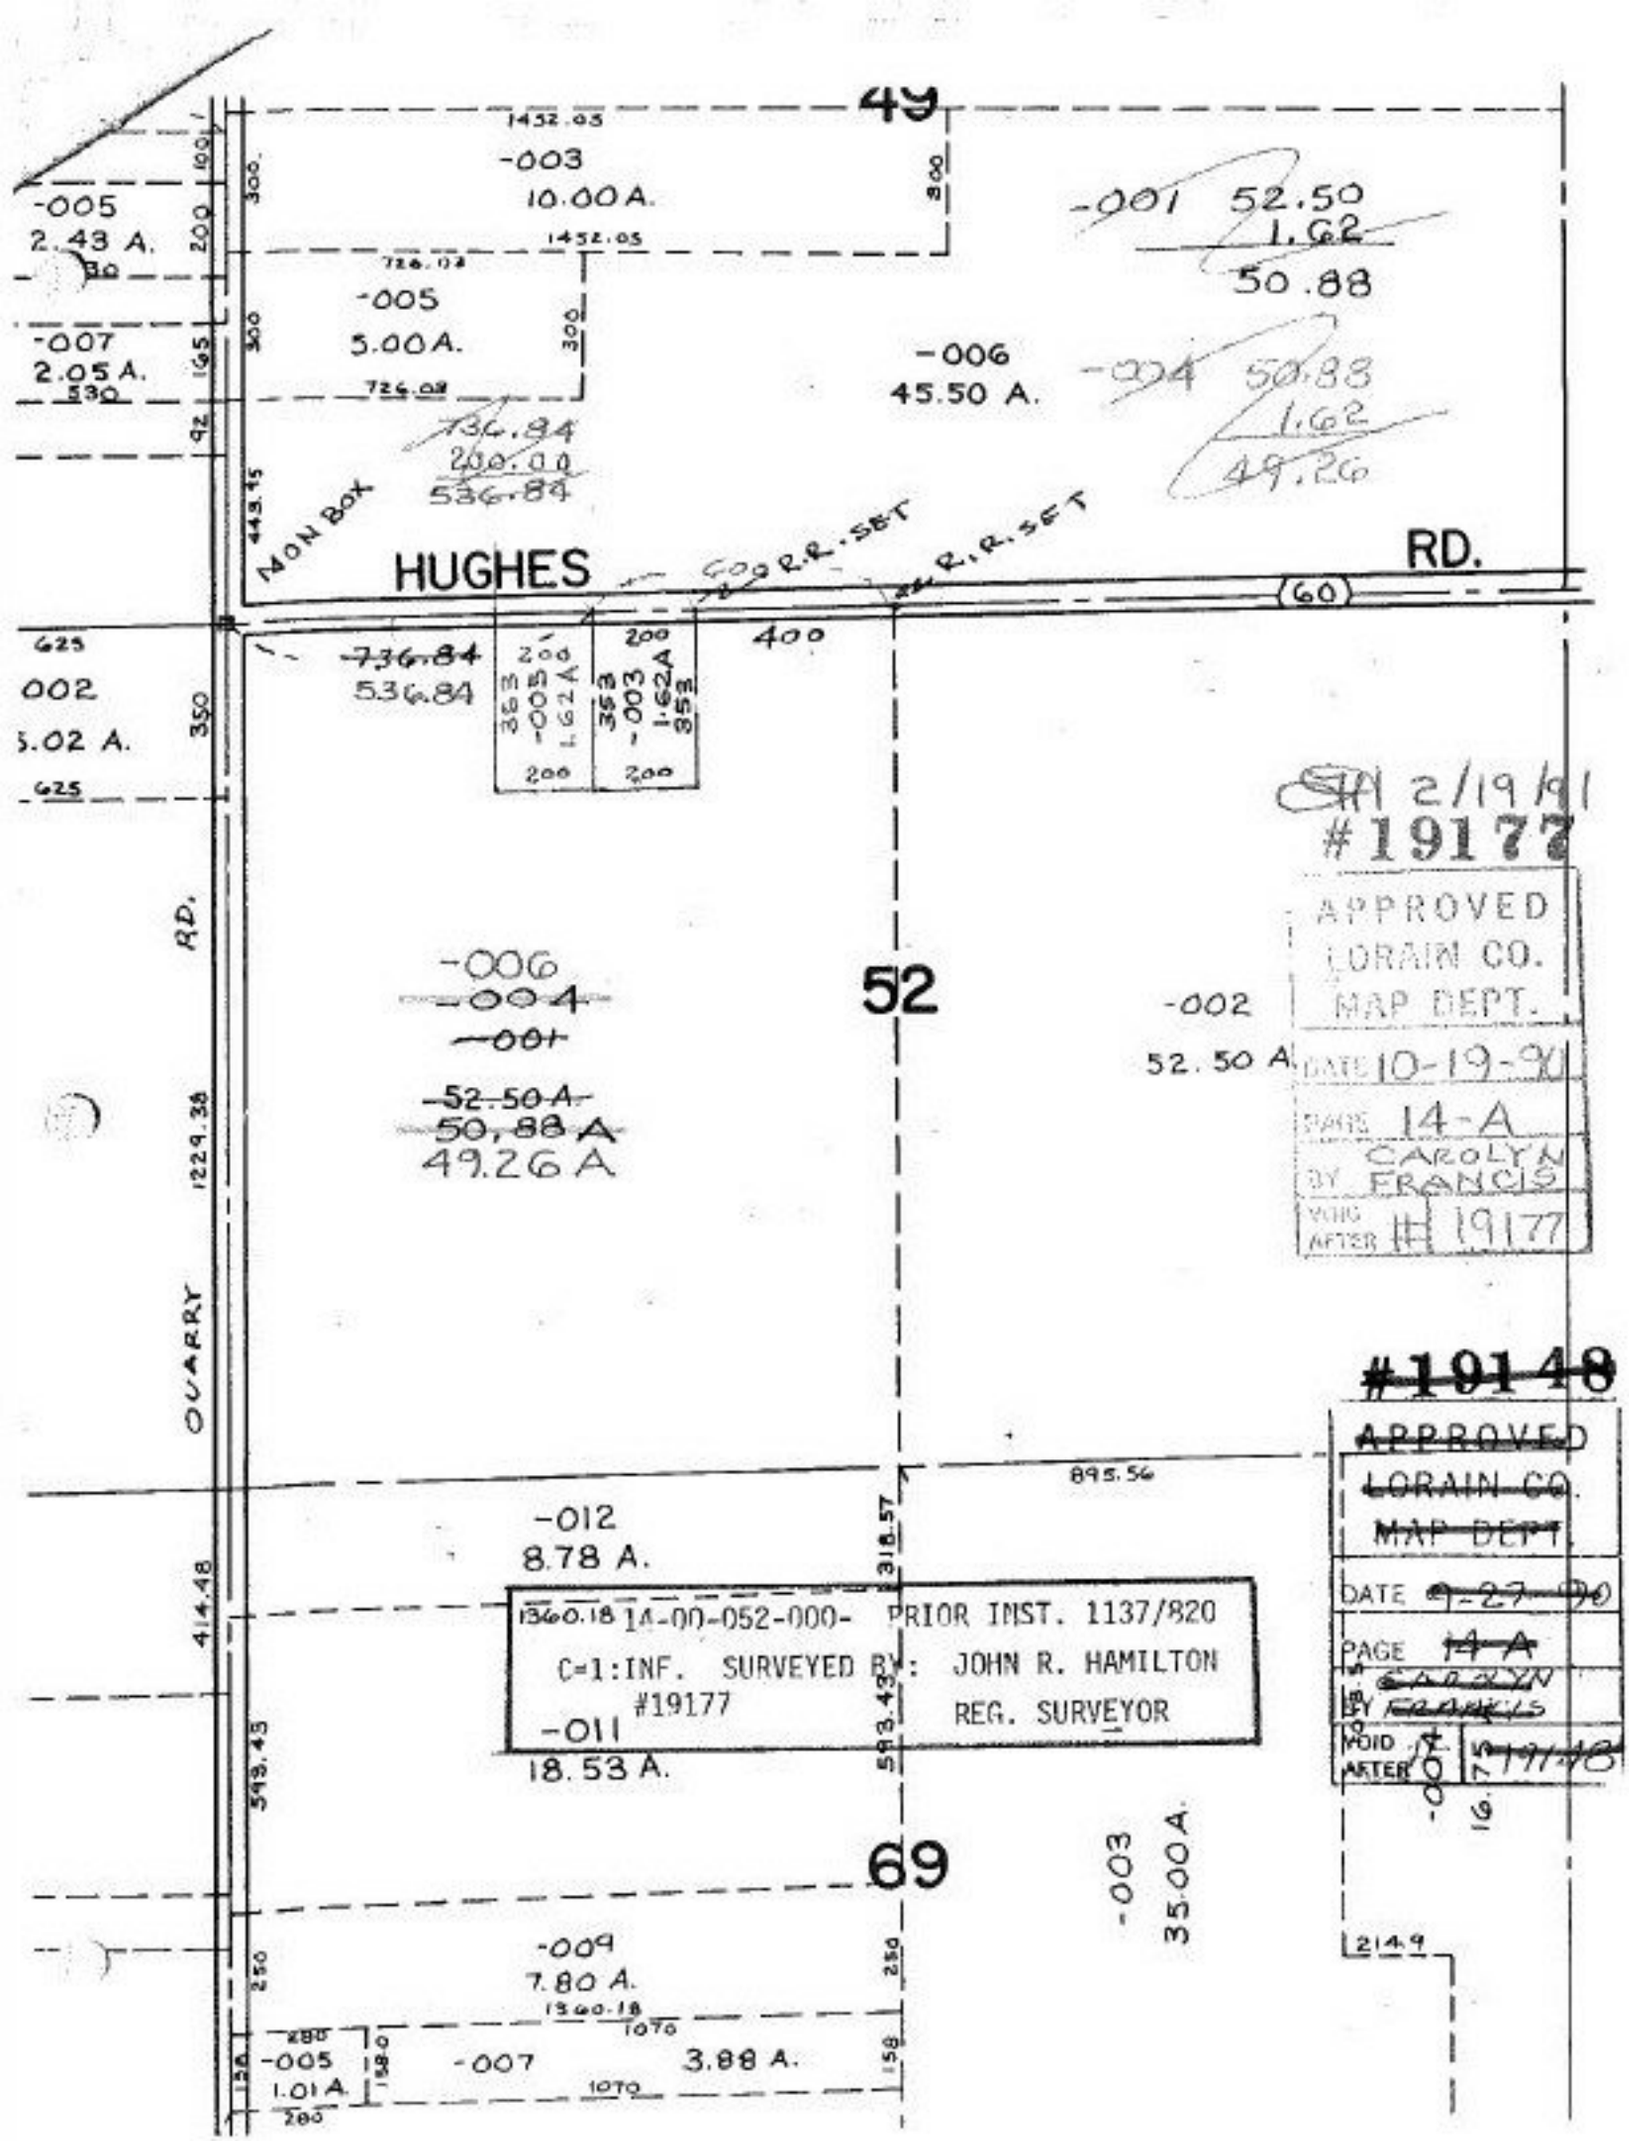
49
1452.05
-003
10.00A.
-005
2.43 A.
-007
2.05A.
-001 52.50
1.62
50.88
-004 50.88
1.62
49.26
-006
45.50 A.
726.03
-005
5.00A.
736.84
200.00
536.84
NON BOX
HUGHES
500 R.R. SET
400 R.R. SET
RD.
60
736.84
536.84
400
002
5.02 A.
RD.
2/19/91
#19177
APPROVED
LORAIN CO.
MAP DEPT.
DATE 10-19-90
PAGE 14-A
BY CAROLYN FRANCIS
VOID AFTER # 19177
-006
-004
-001
52.50A
50,88A
49.26A
52
-002
52.50 A
#19148
APPROVED
LORAIN CO.
MAP DEPT.
DATE 9-27-90
PAGE 14A
BY CAROLYN FRANCIS
VOID AFTER # 19148
OUARRY
1229.38
895.56
-012
8.78 A.
414.48
318.57
1360.18 14-00-052-000- PRIOR INST. 1137/820
C=1:INF. SURVEYED BY: JOHN R. HAMILTON
#19177 REG. SURVEYOR
-011
18.53 A.
593.43
549.45
69
-003
35.00A.
-009
7.80 A.
1360.18
1070
-005
1.01 A.
-007
3.88 A.
1070
2149