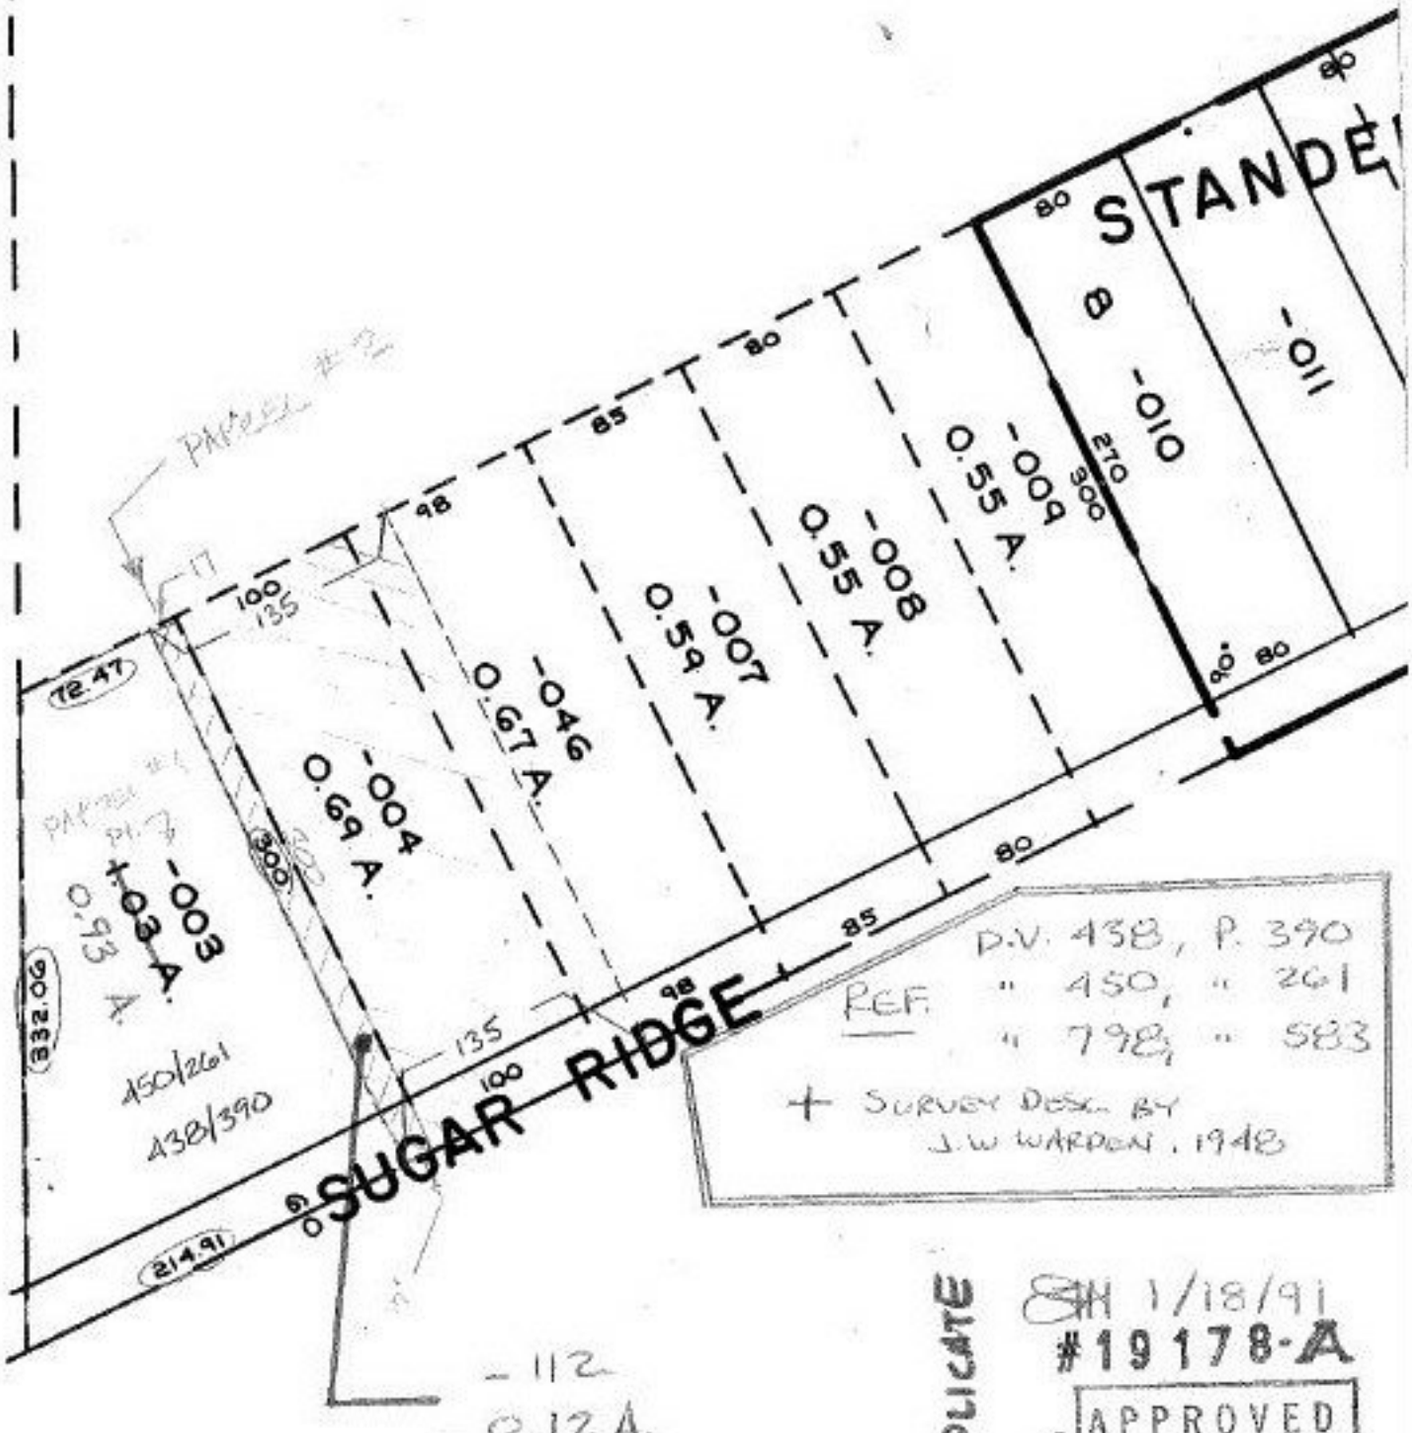

ADD TO DUPLICATE
ACRE. CORR.

SH 1/18/91
#19178-A

APPROVED LORAIN CO. MAP DEPT.
DATE 10/17/90
PAGE 7-00-038-B
BY T. McMain
VOID AFTER 19178-A