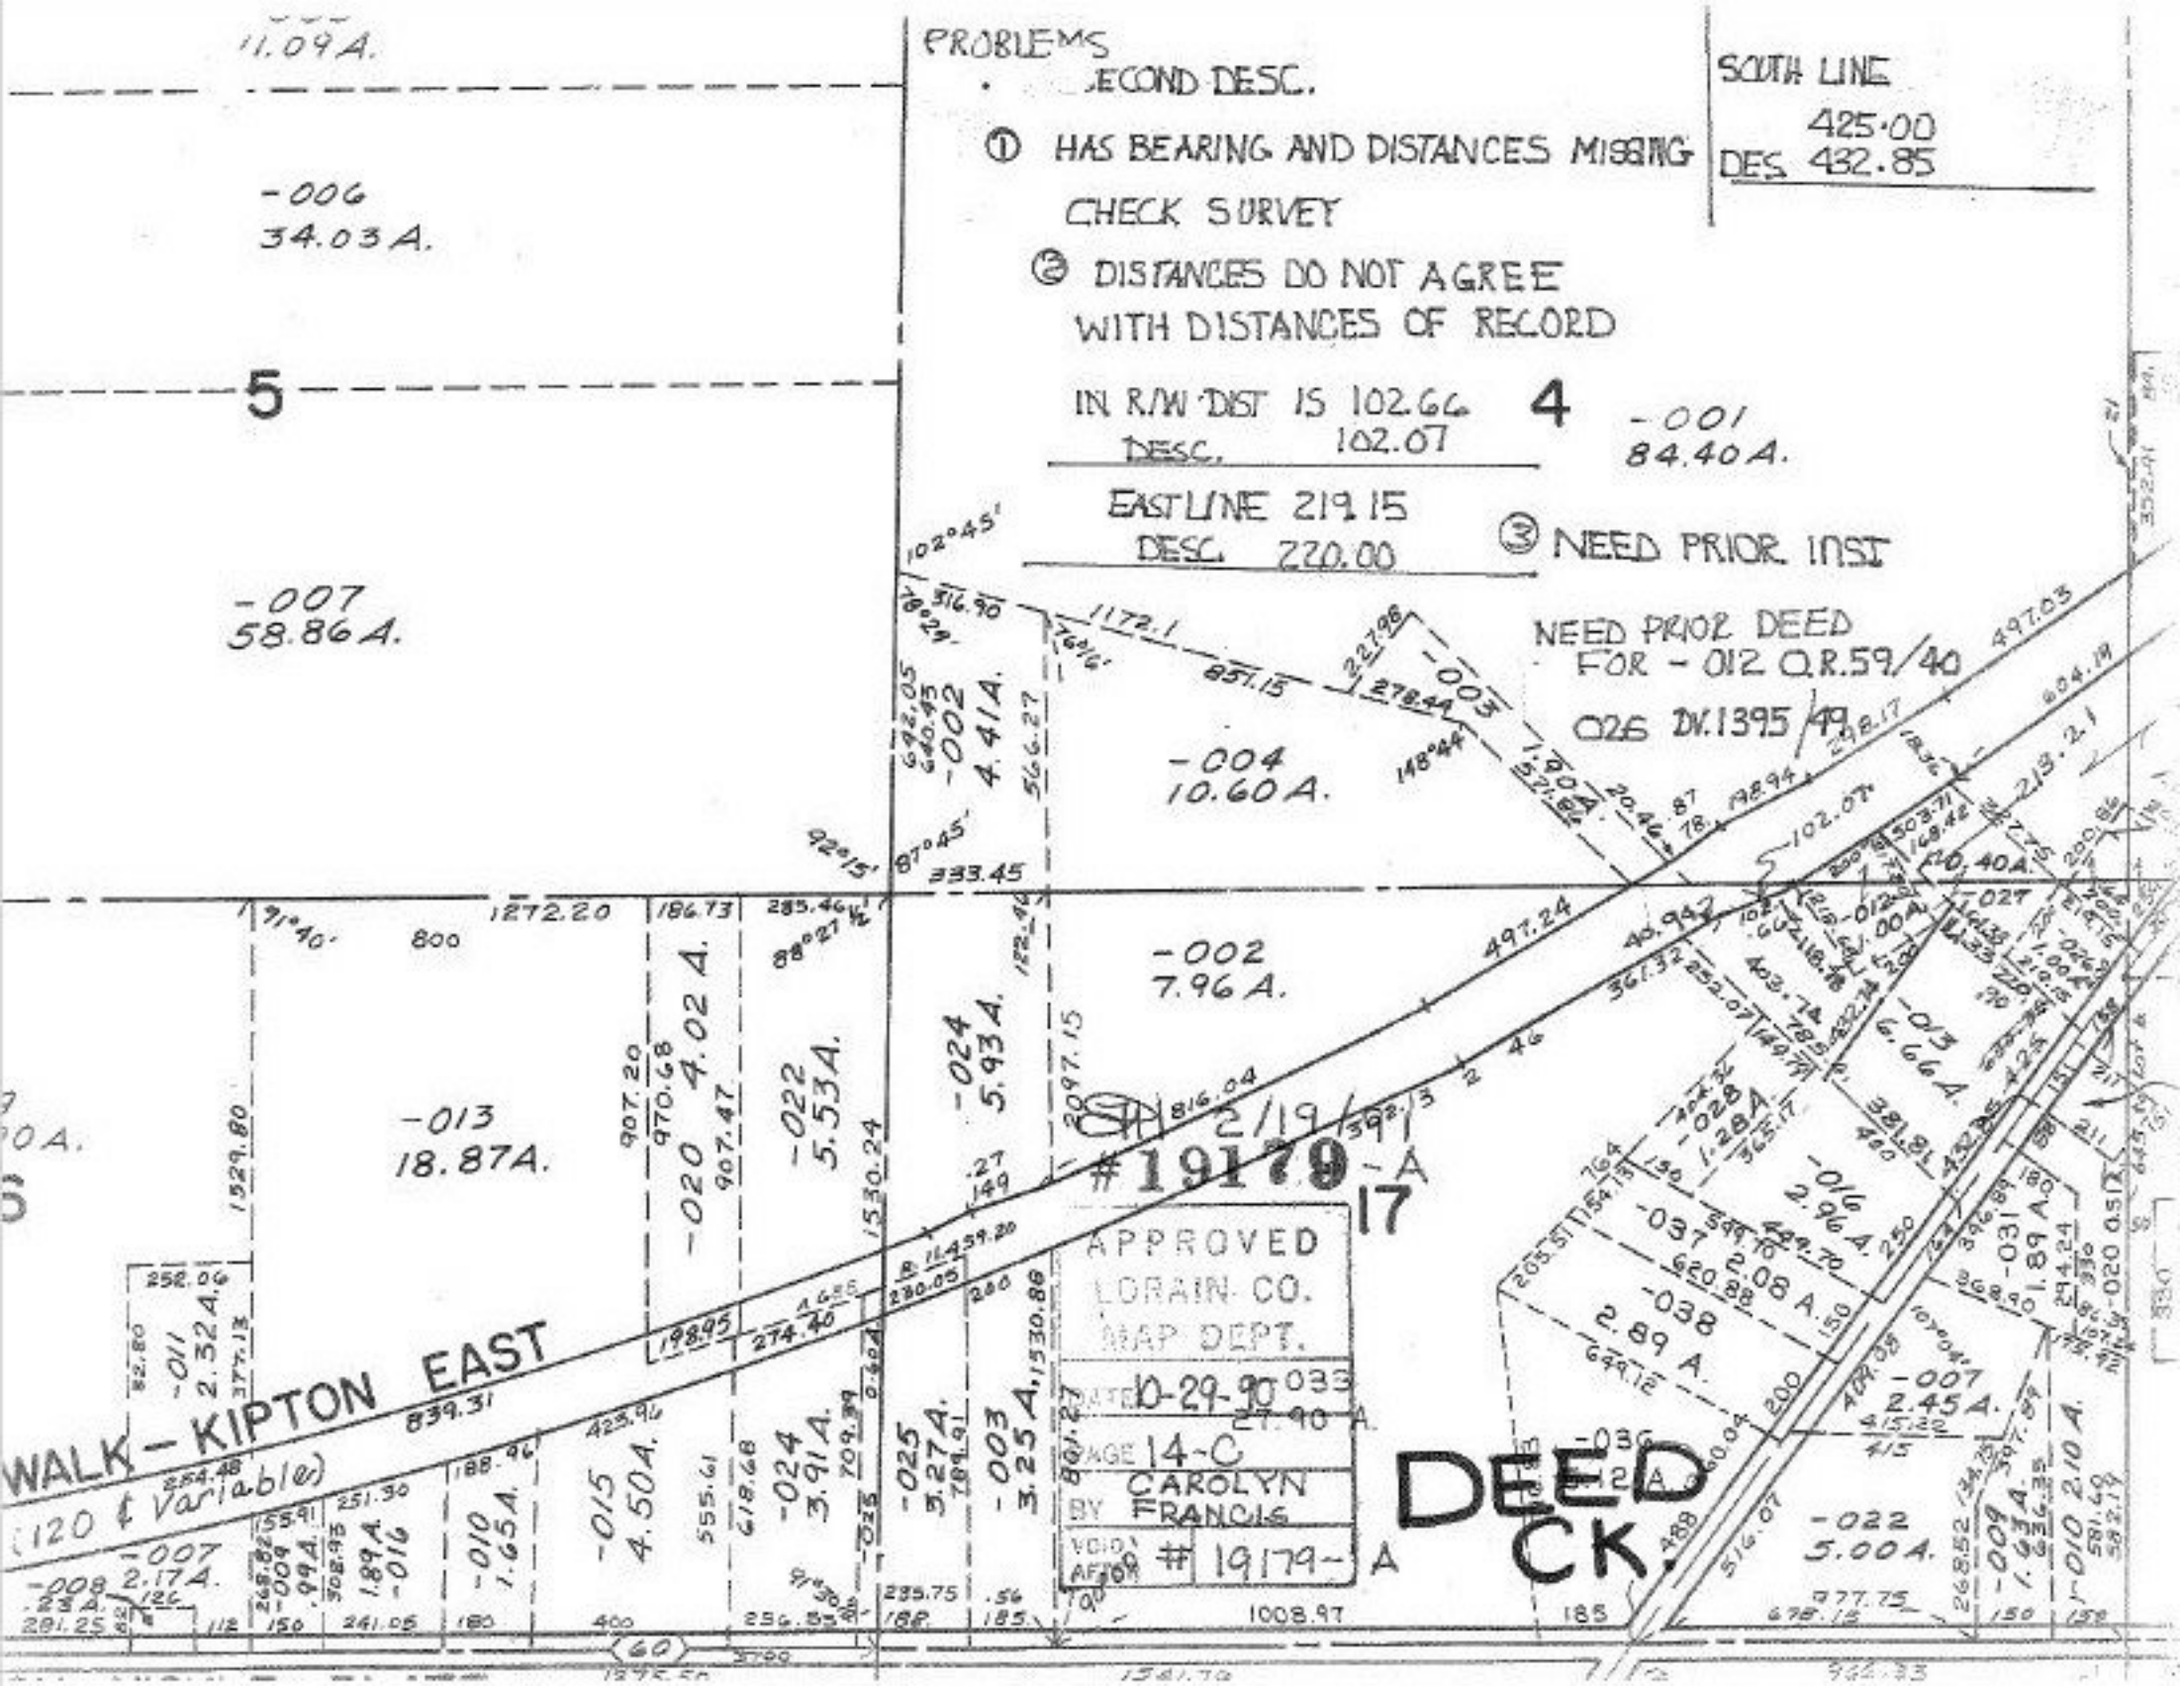
11.09A.
PROBLEMS
SECOND DESC.
① HAS BEARING AND DISTANCES MISSING
CHECK SURVEY
② DISTANCES DO NOT AGREE
WITH DISTANCES OF RECORD
IN R/W DIST IS 102.66
DESC. 102.07
EAST LINE 219.15
DESC. 220.00
SOUTH LINE
425.00
DES. 432.85
③ NEED PRIOR INST
NEED PRIOR DEED
FOR - 012 O.R. 59/40
026 DV. 1395/49
-006
34.03A.
-007
58.86A.
5
4
-001
84.40A.
-004
10.60A.
-002
4.414A.
-002
7.96A.
-013
18.87A.
-020 4.02A.
-022
5.534A.
-024
5.93A.
-024
3.91A.
-025
3.274A.
-003
3.254A.
-015
4.50A.
-010
1.65A.
-016
1.89A.
-011
2.324A.
-007
2.17A.
-012 Q.R. 59/40
-013
6.66A.
-016
2.96A.
-037
2.08A.
-038
2.89A.
-028
1.28A.
-031
1.89A.
-007
2.45A.
-022
5.00A.
-010
2.10A.
-009
1.93A.
-027
1.00A.
-026
1.00A.
10.40A.
#19179-A
APPROVED
LORAIN CO.
MAP DEPT.
DATE 10-29-90
PAGE 14-C
BY CAROLYN FRANCIS
VOID AFTER
#19179-A
DEED
CK.
WALK-KIPTON EAST
(120 ± Variable)
497.24
497.03
839.31
1272.20
1529.80
1530.24
1008.97
1895.50
1241.79
962.33
60
800
400
185
180
150
112
126
82
330
211
215
220
245
249
250
260
264
268
270
275
