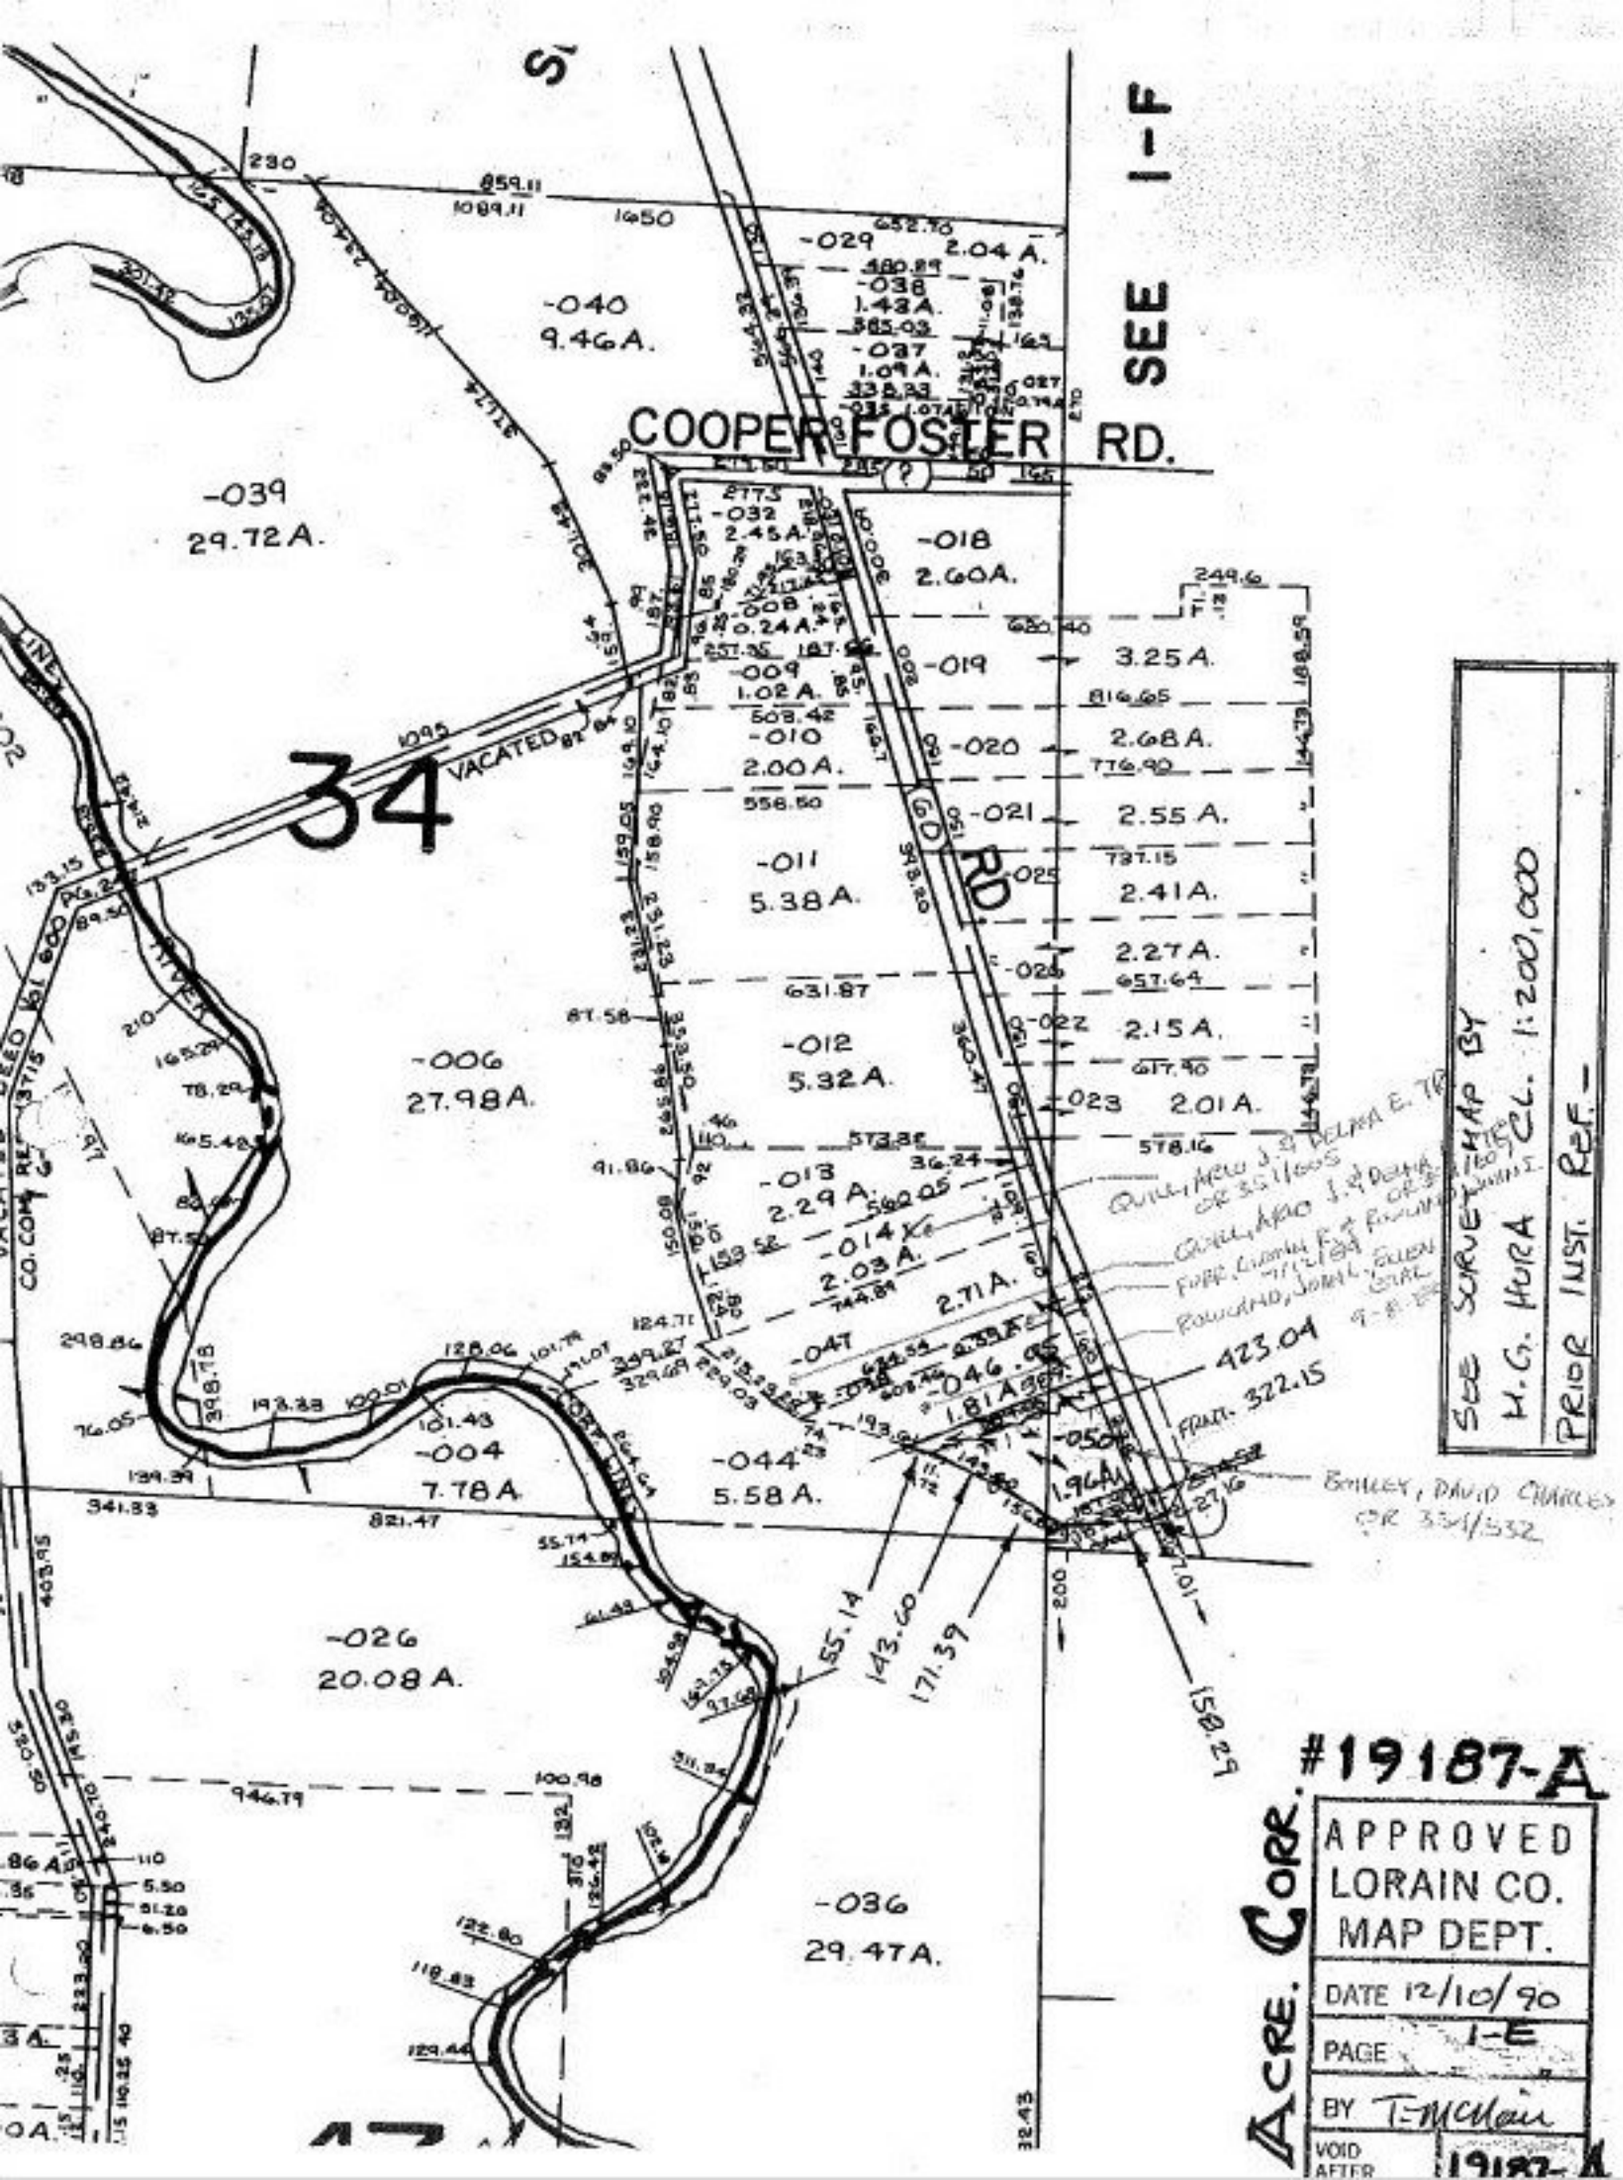

SEE I-F
COOPER FOSTER RD.
34
VACATED
RD.
-040
9.46 A.
-039
29.72 A.
-029
2.04 A.
-038
1.43 A.
-037
1.09 A.
-032
2.45 A.
-018
2.60 A.
-008
0.24 A.
-009
1.02 A.
-019
3.25 A.
-010
2.00 A.
-020
2.68 A.
-021
2.55 A.
-011
5.38 A.
-025
2.41 A.
2.27 A.
-026
-022
2.15 A.
-006
27.98 A.
-012
5.32 A.
-023
2.01 A.
-013
2.29 A.
-014
2.03 A.
2.71 A.
-047
-046
1.81 A.
-004
7.78 A.
-044
5.58 A.
-026
20.08 A.
-036
29.47 A.
423.04
322.15
55.14
143.60
171.39
158.29
BOILLEY, DAVID CHARLES OR 334/532
SEE SURVEY MAP BY
H.G. HURA CL. 1:200,000
PRIOR INST. REF.
#19187-A
ACRE CORR.
APPROVED
LORAIN CO.
MAP DEPT.
DATE 12/10/90
PAGE 1-E
BY T. McNair
VOID AFTER 19187-A