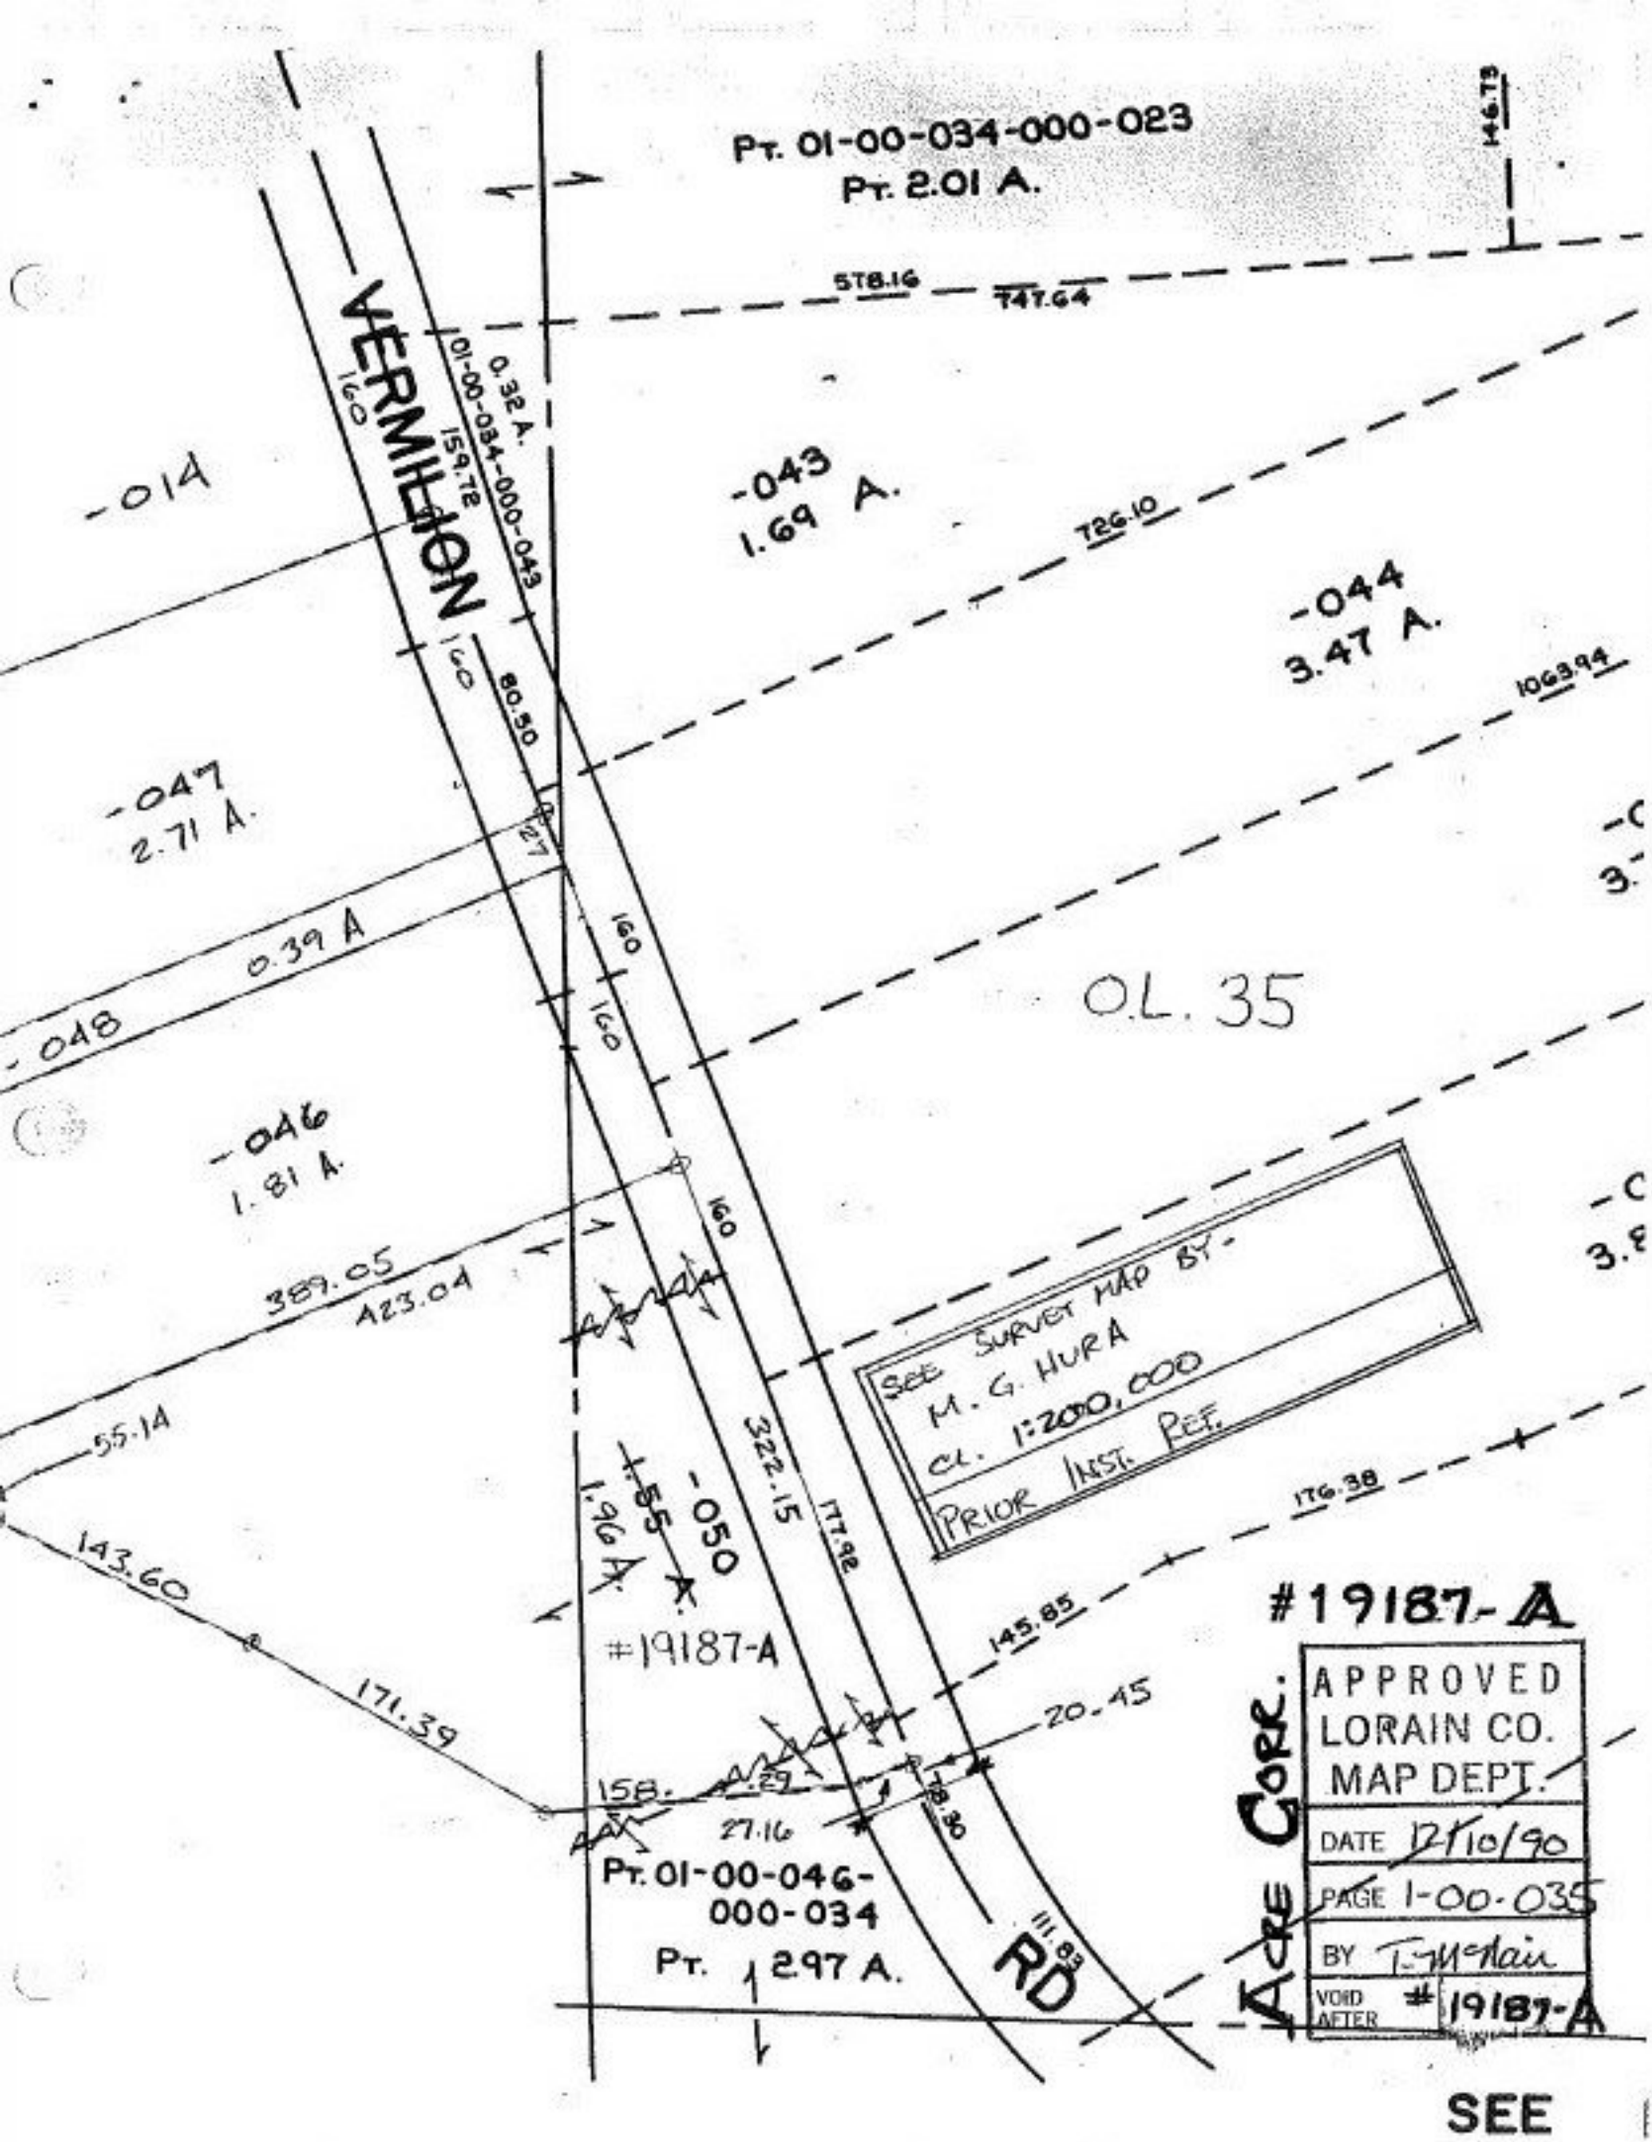
Pt. 01-00-034-000-023
Pt. 2.01 A.
146.73
578.16
747.64
VERMILION
160
0.32 A.
01-00-034-000-043
159.72
-014
-043
1.69 A.
726.10
-044
3.47 A.
1063.94
80.50
-047
2.71 A.
0.39 A
-048
160
160
O.L. 35
-046
1.81 A.
160
389.05
423.04
55.14
143.60
171.39
322.15
177.92
1.55 A.
1.96 A.
-050
#19187-A
176.38
145.85
20.45
158.29
27.16
18.80
Pt. 01-00-046-000-034
Pt. 2.97 A.
111.83
RD
See Survey Map by
M. G. Hura
Cl. 1:200,000
Prior Inst. Ref.
#19187-A
Acre Corr.
APPROVED
LORAIN CO.
MAP DEPT.
DATE 12/10/90
PAGE 1-00-035
BY T. McClain
VOID AFTER # 19187-A
SEE