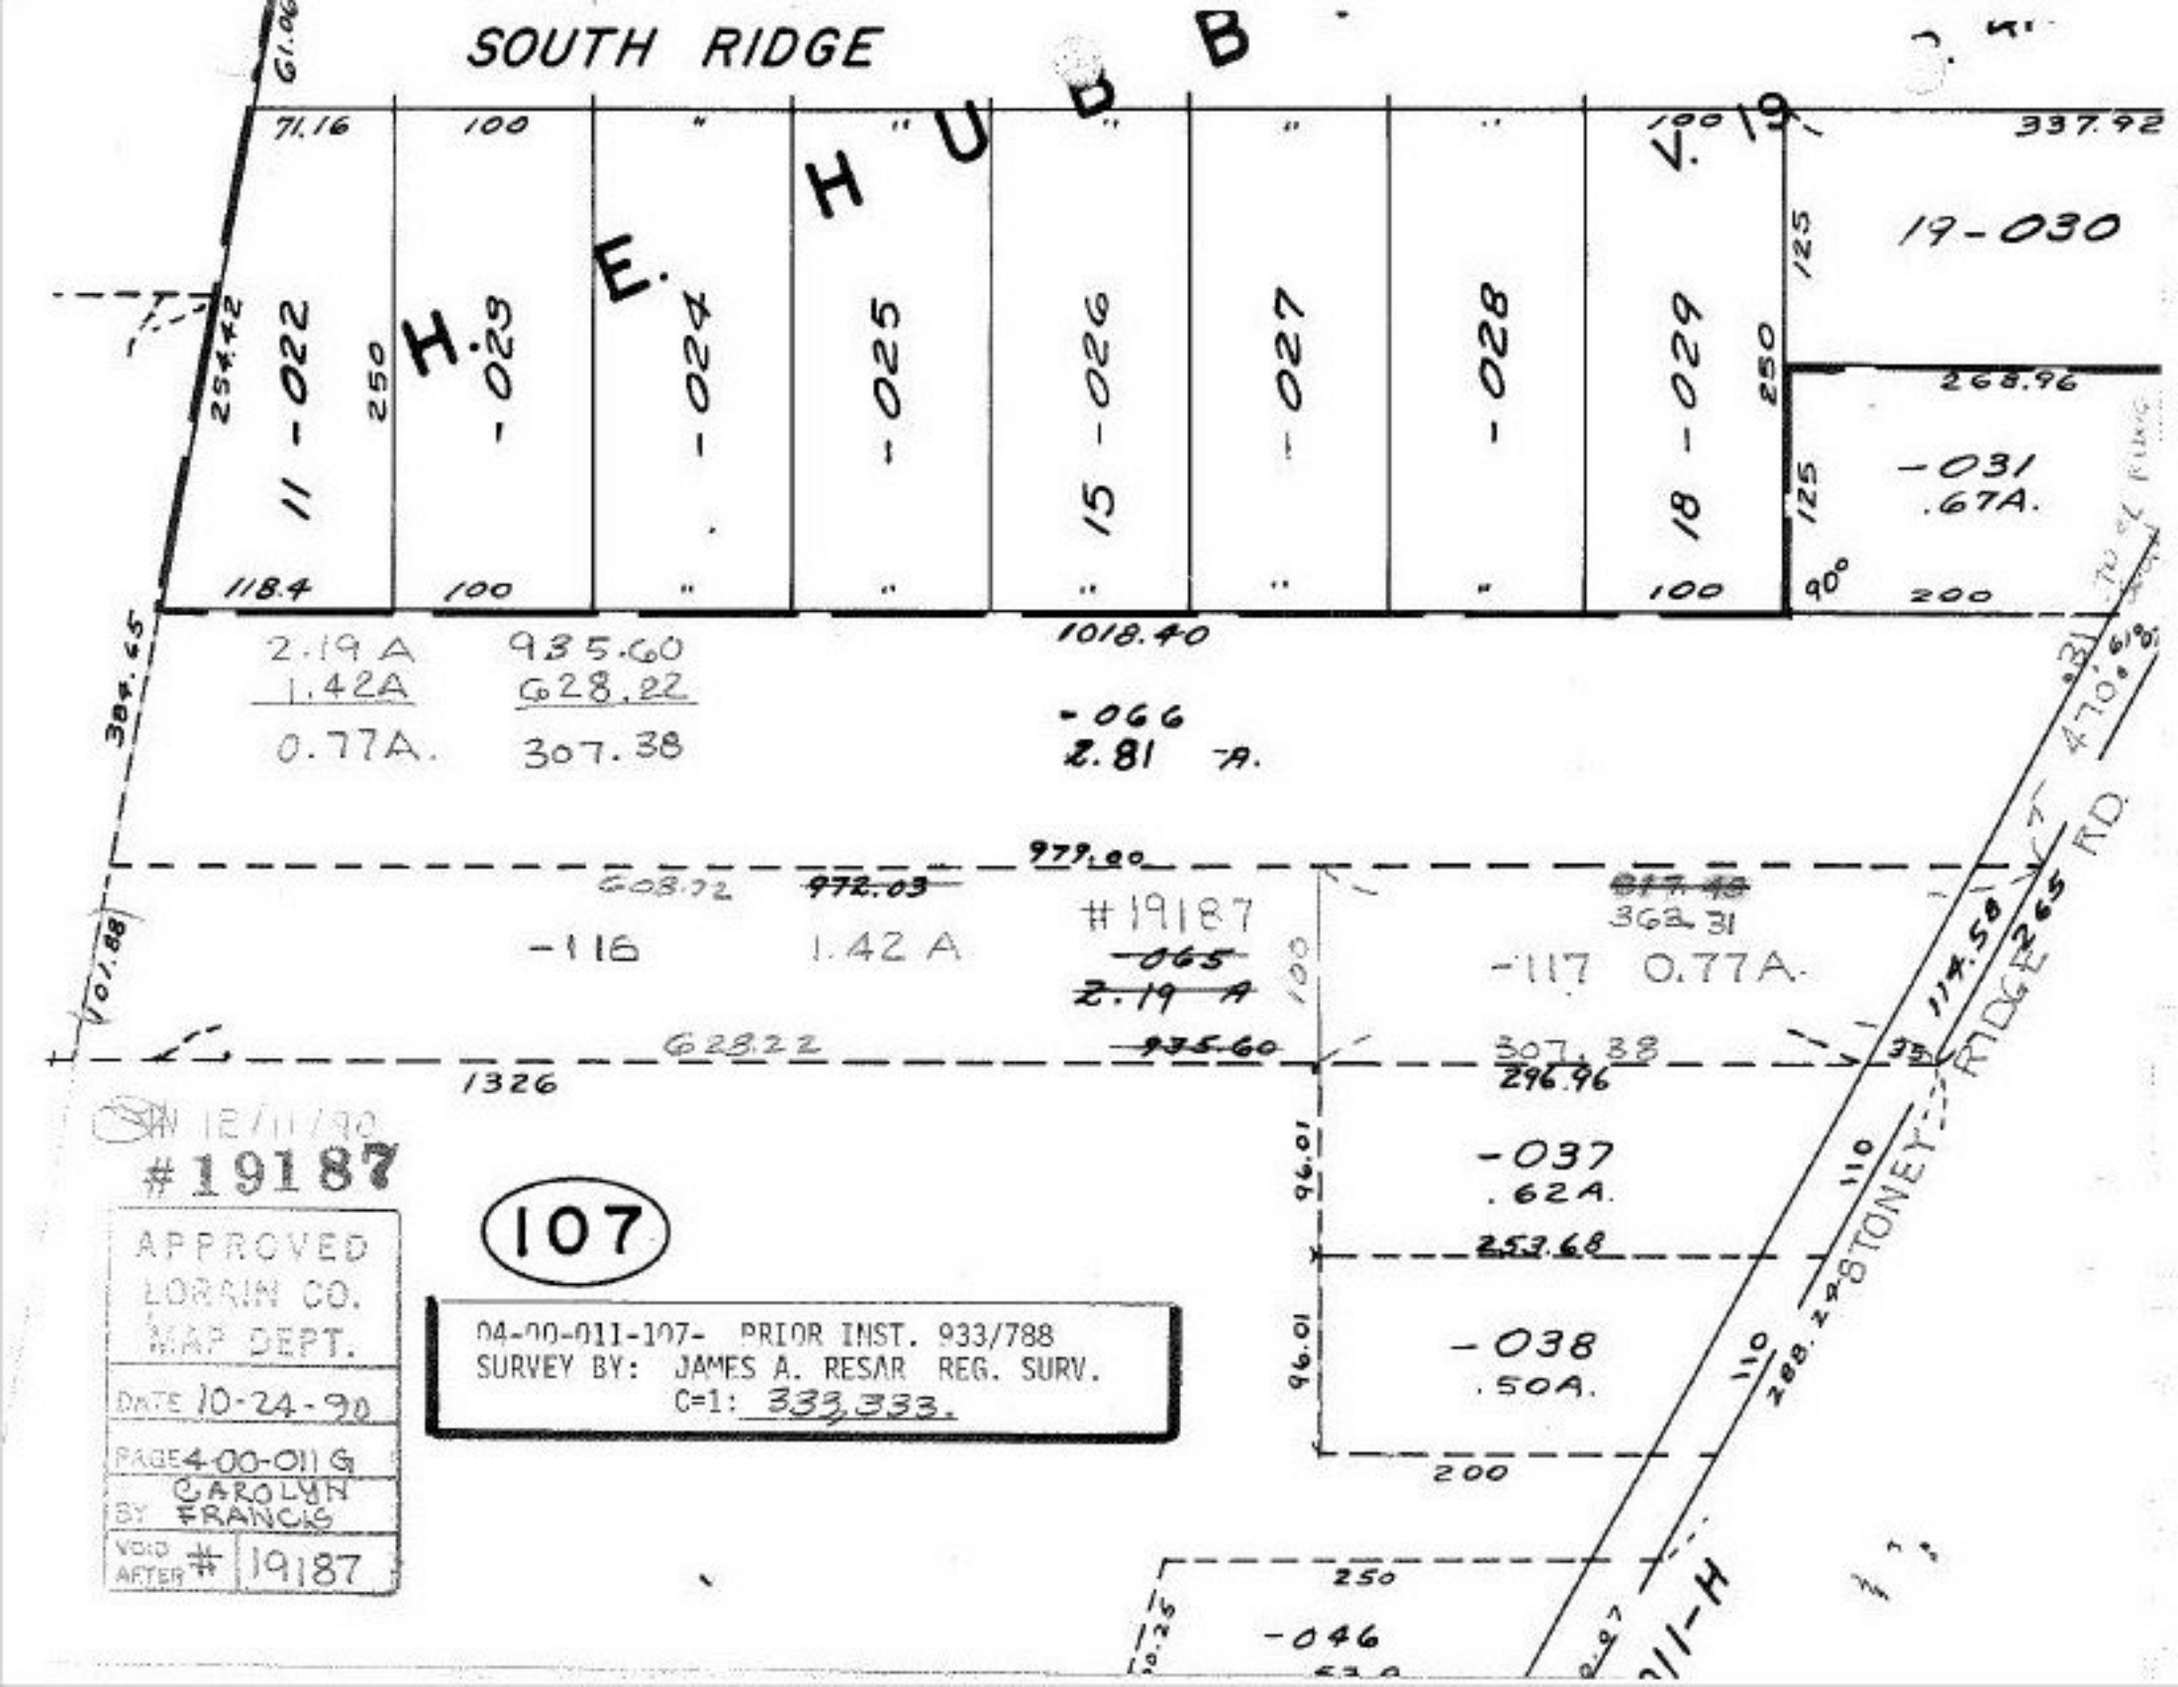
SOUTH RIDGE
H. E. HUBB
71.16
100
100
100
100
100
100
100
337.92
11-022
-023
-024
-025
15-026
-027
-028
18-029
19-030
254.42
250
125
250
268.96
-031
.67A.
125
118.4
100
90°
200
2.19 A
1.42A
0.77A.
935.60
628.22
307.38
1018.40
-066
2.81 A.
384.65
979.00
608.72
972.03
#19187
-065
2.19 A
935.60
-116
1.42 A
-117 0.77A.
362.31
307.38
296.96
628.22
1326
101.88
100
114.50
35
-037
.62A.
96.01
253.68
-038
.50A.
96.01
110
200
250
-046
STONEY RIDGE RD.
470.61
288.29
265
911-H
12/11/90
#19187
APPROVED
LORAIN CO.
MAP DEPT.
DATE 10-24-90
PAGE 4-00-011 G
BY CAROLYN FRANCIS
VOID AFTER # 19187
107
04-00-011-107- PRIOR INST. 933/788
SURVEY BY: JAMES A. RESAR REG. SURV.
C=1: 333,333.