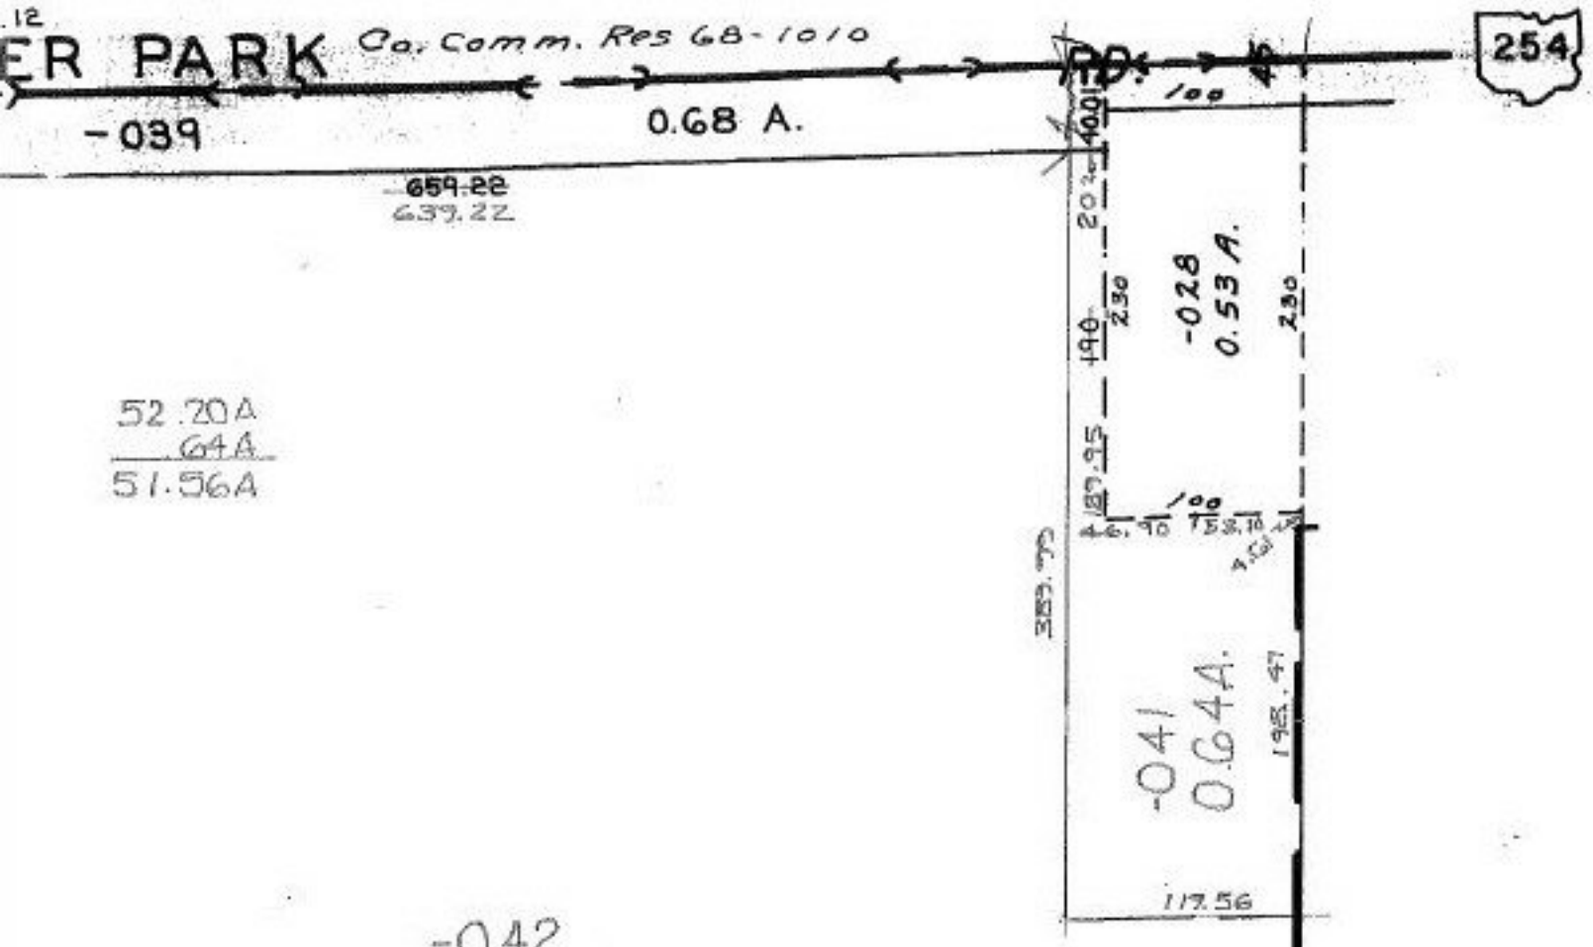

05-00-060-101- PRIOR INST. 99/39 C=1: 250,000
SURVEYED BY: NORMAN R. HURA & SSOC.

4/8/92
19199

APPROVED
LORAIN CO.
MAP DEPT.
DATE 11-5-91
PAGE 5-00-060- A
BY CAROLYN FRANCIS
VOID METES # 19199