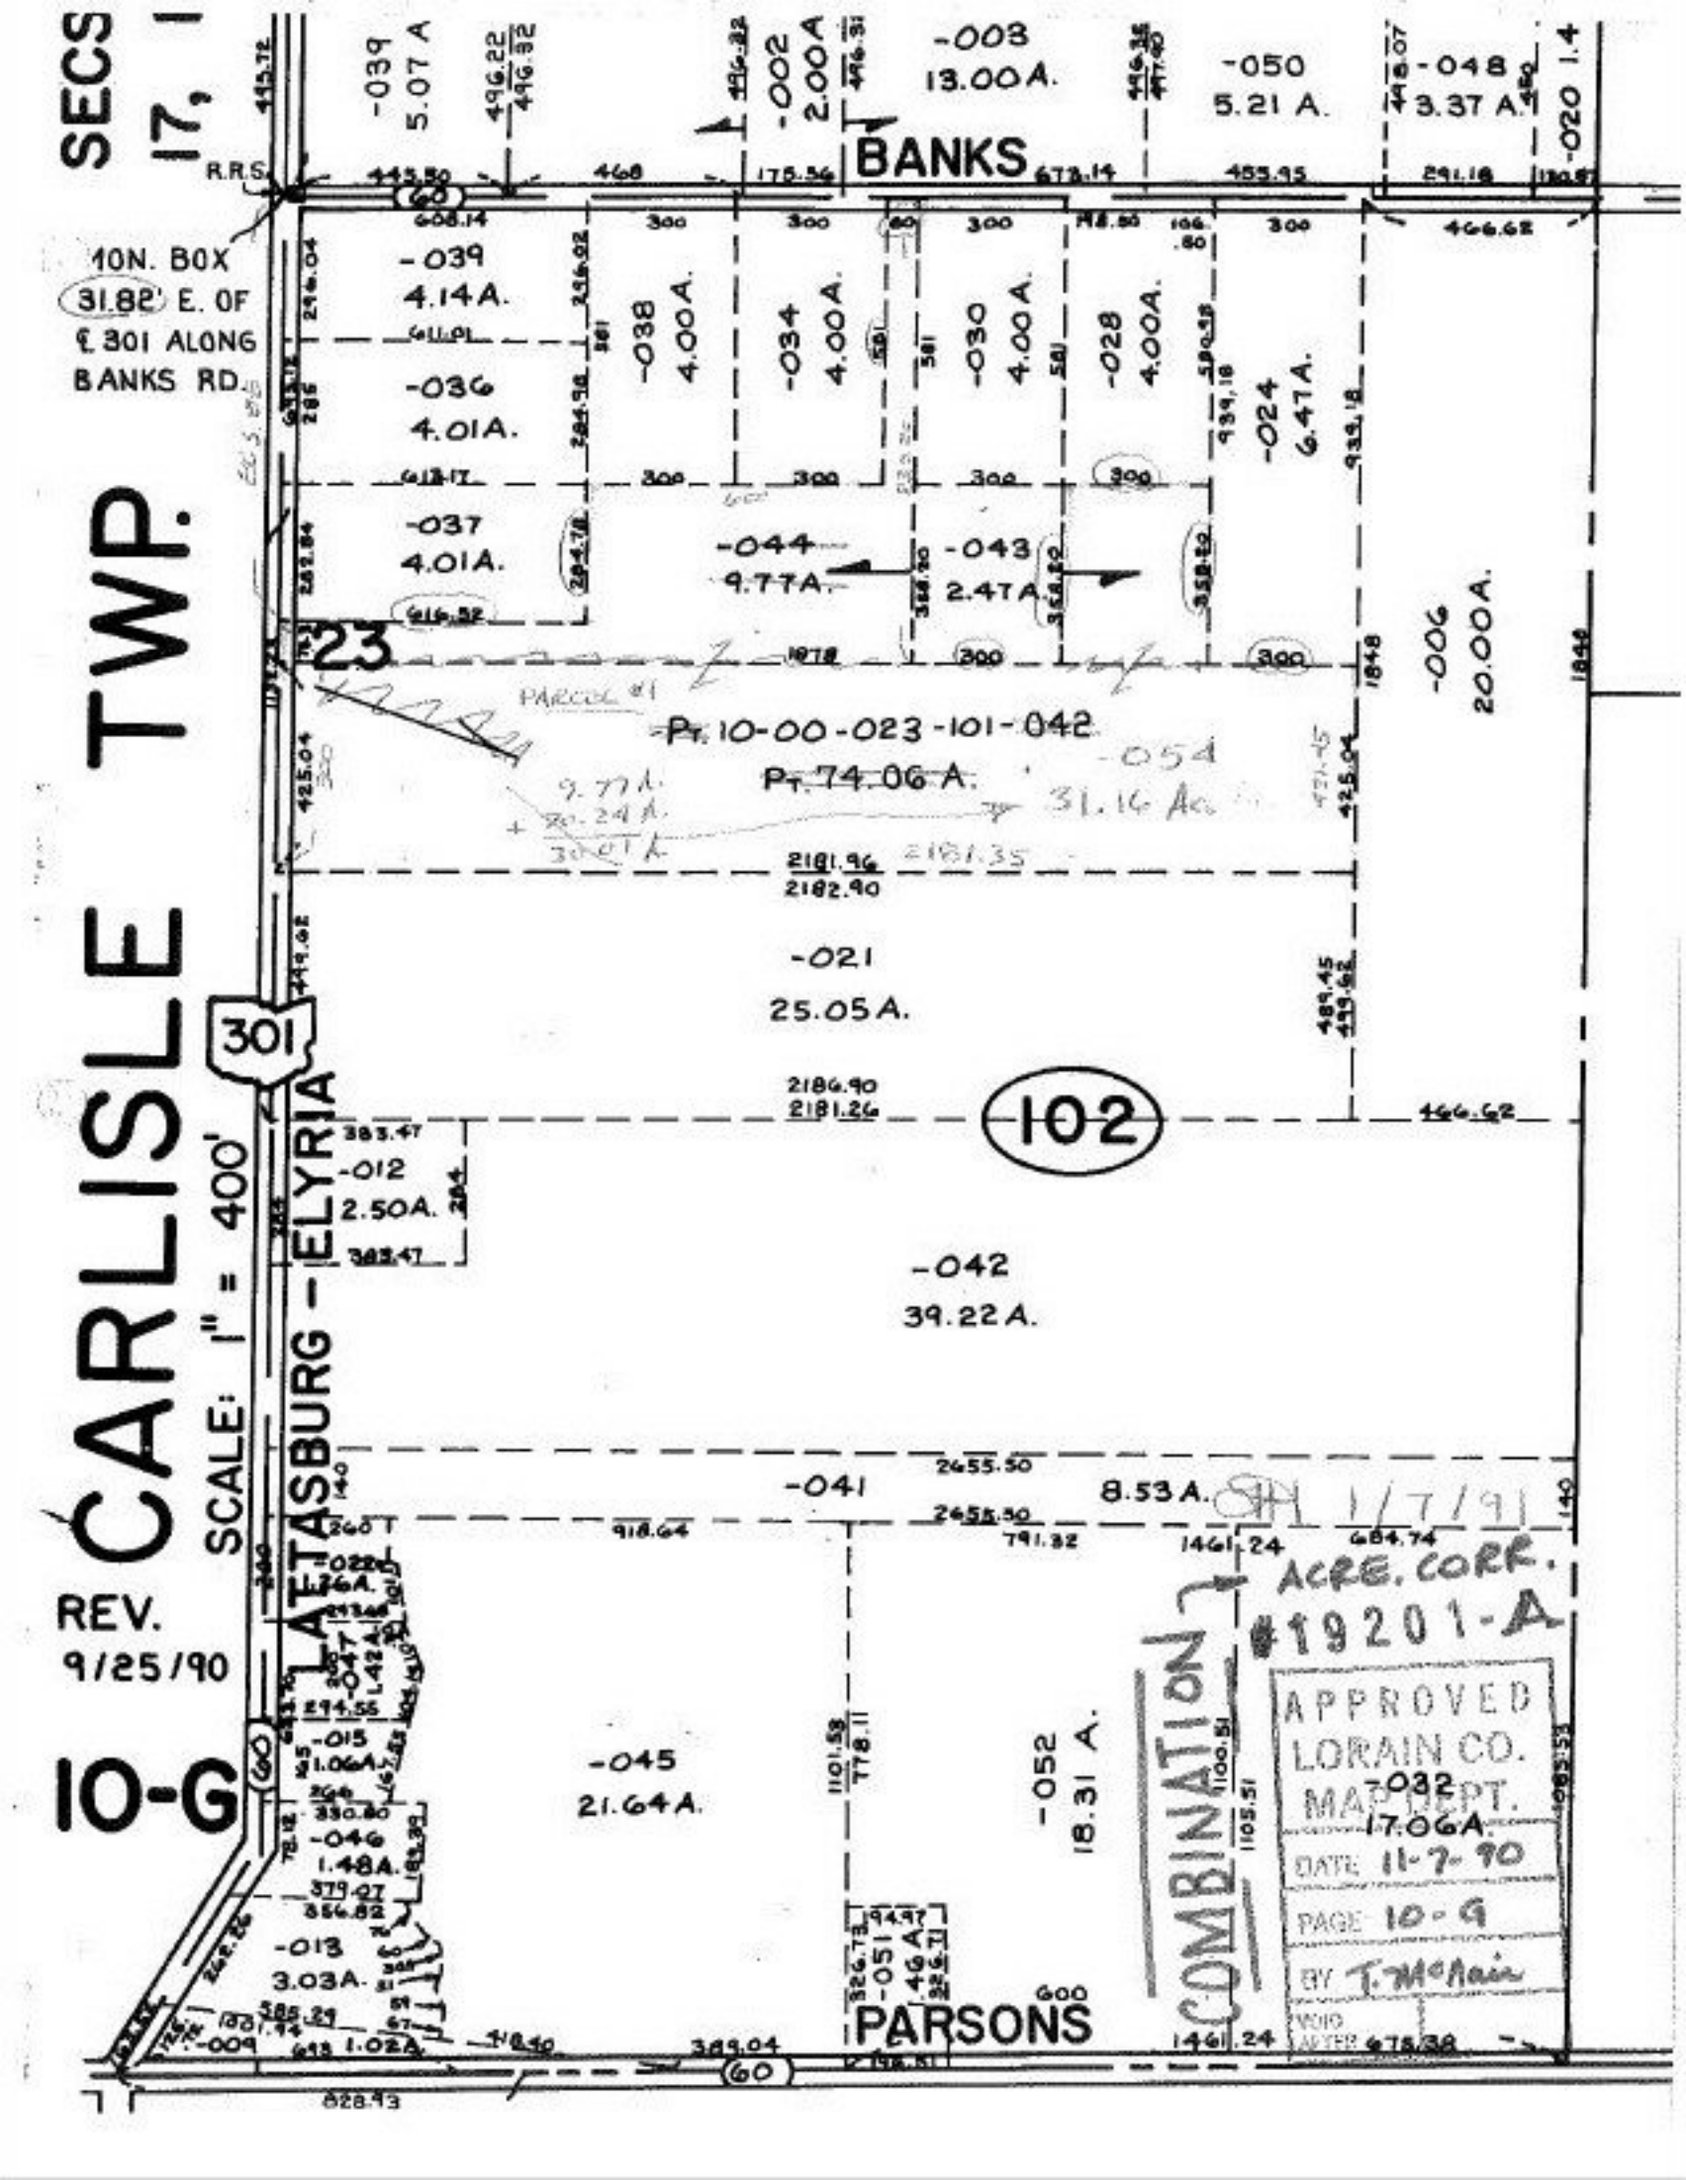
SECS 17, 1
CARLISLE TWP.
SCALE: 1" = 400'
REV. 9/25/90
10-G
BANKS
LATASBURG - ELYRIA
PARSONS
10N. BOX
31.82' E. OF
℄ 301 ALONG
BANKS RD.
-039 5.07 A
-002 2.00A
-003 13.00A.
-050 5.21 A.
-048 3.37 A.
-020 1.4
-039 4.14A.
-036 4.01A.
-037 4.01A.
-038 4.00A.
-034 4.00A.
-030 4.00A.
-028 4.00A.
-024 6.47A.
-044 9.77A.
-043 2.47A.
-006 20.00A.
23
PARCEL #1
Pt. 10-00-023-101-042
Pt. 74.06 A.
-054
31.16 Ac.
9.77 A.
+ 20.29 A.
30.06 A.
-021
25.05A.
102
-012 2.50A.
-042 39.22A.
-041 8.53A.
-022 .36A.
-047 1.42A.
-015 1.06A.
-045 21.64A.
-046 1.48A.
-013 3.03A.
-009 1.02A.
-052 18.31 A.
-051 .46A.
-032 17.06A.
COMBINATION
ACRE. CORR. #19201-A
APPROVED
LORAIN CO.
MAP DEPT.
DATE 11-7-90
PAGE 10-9
BY T. McNair
VOID AFTER 6-15-98
1/7/91