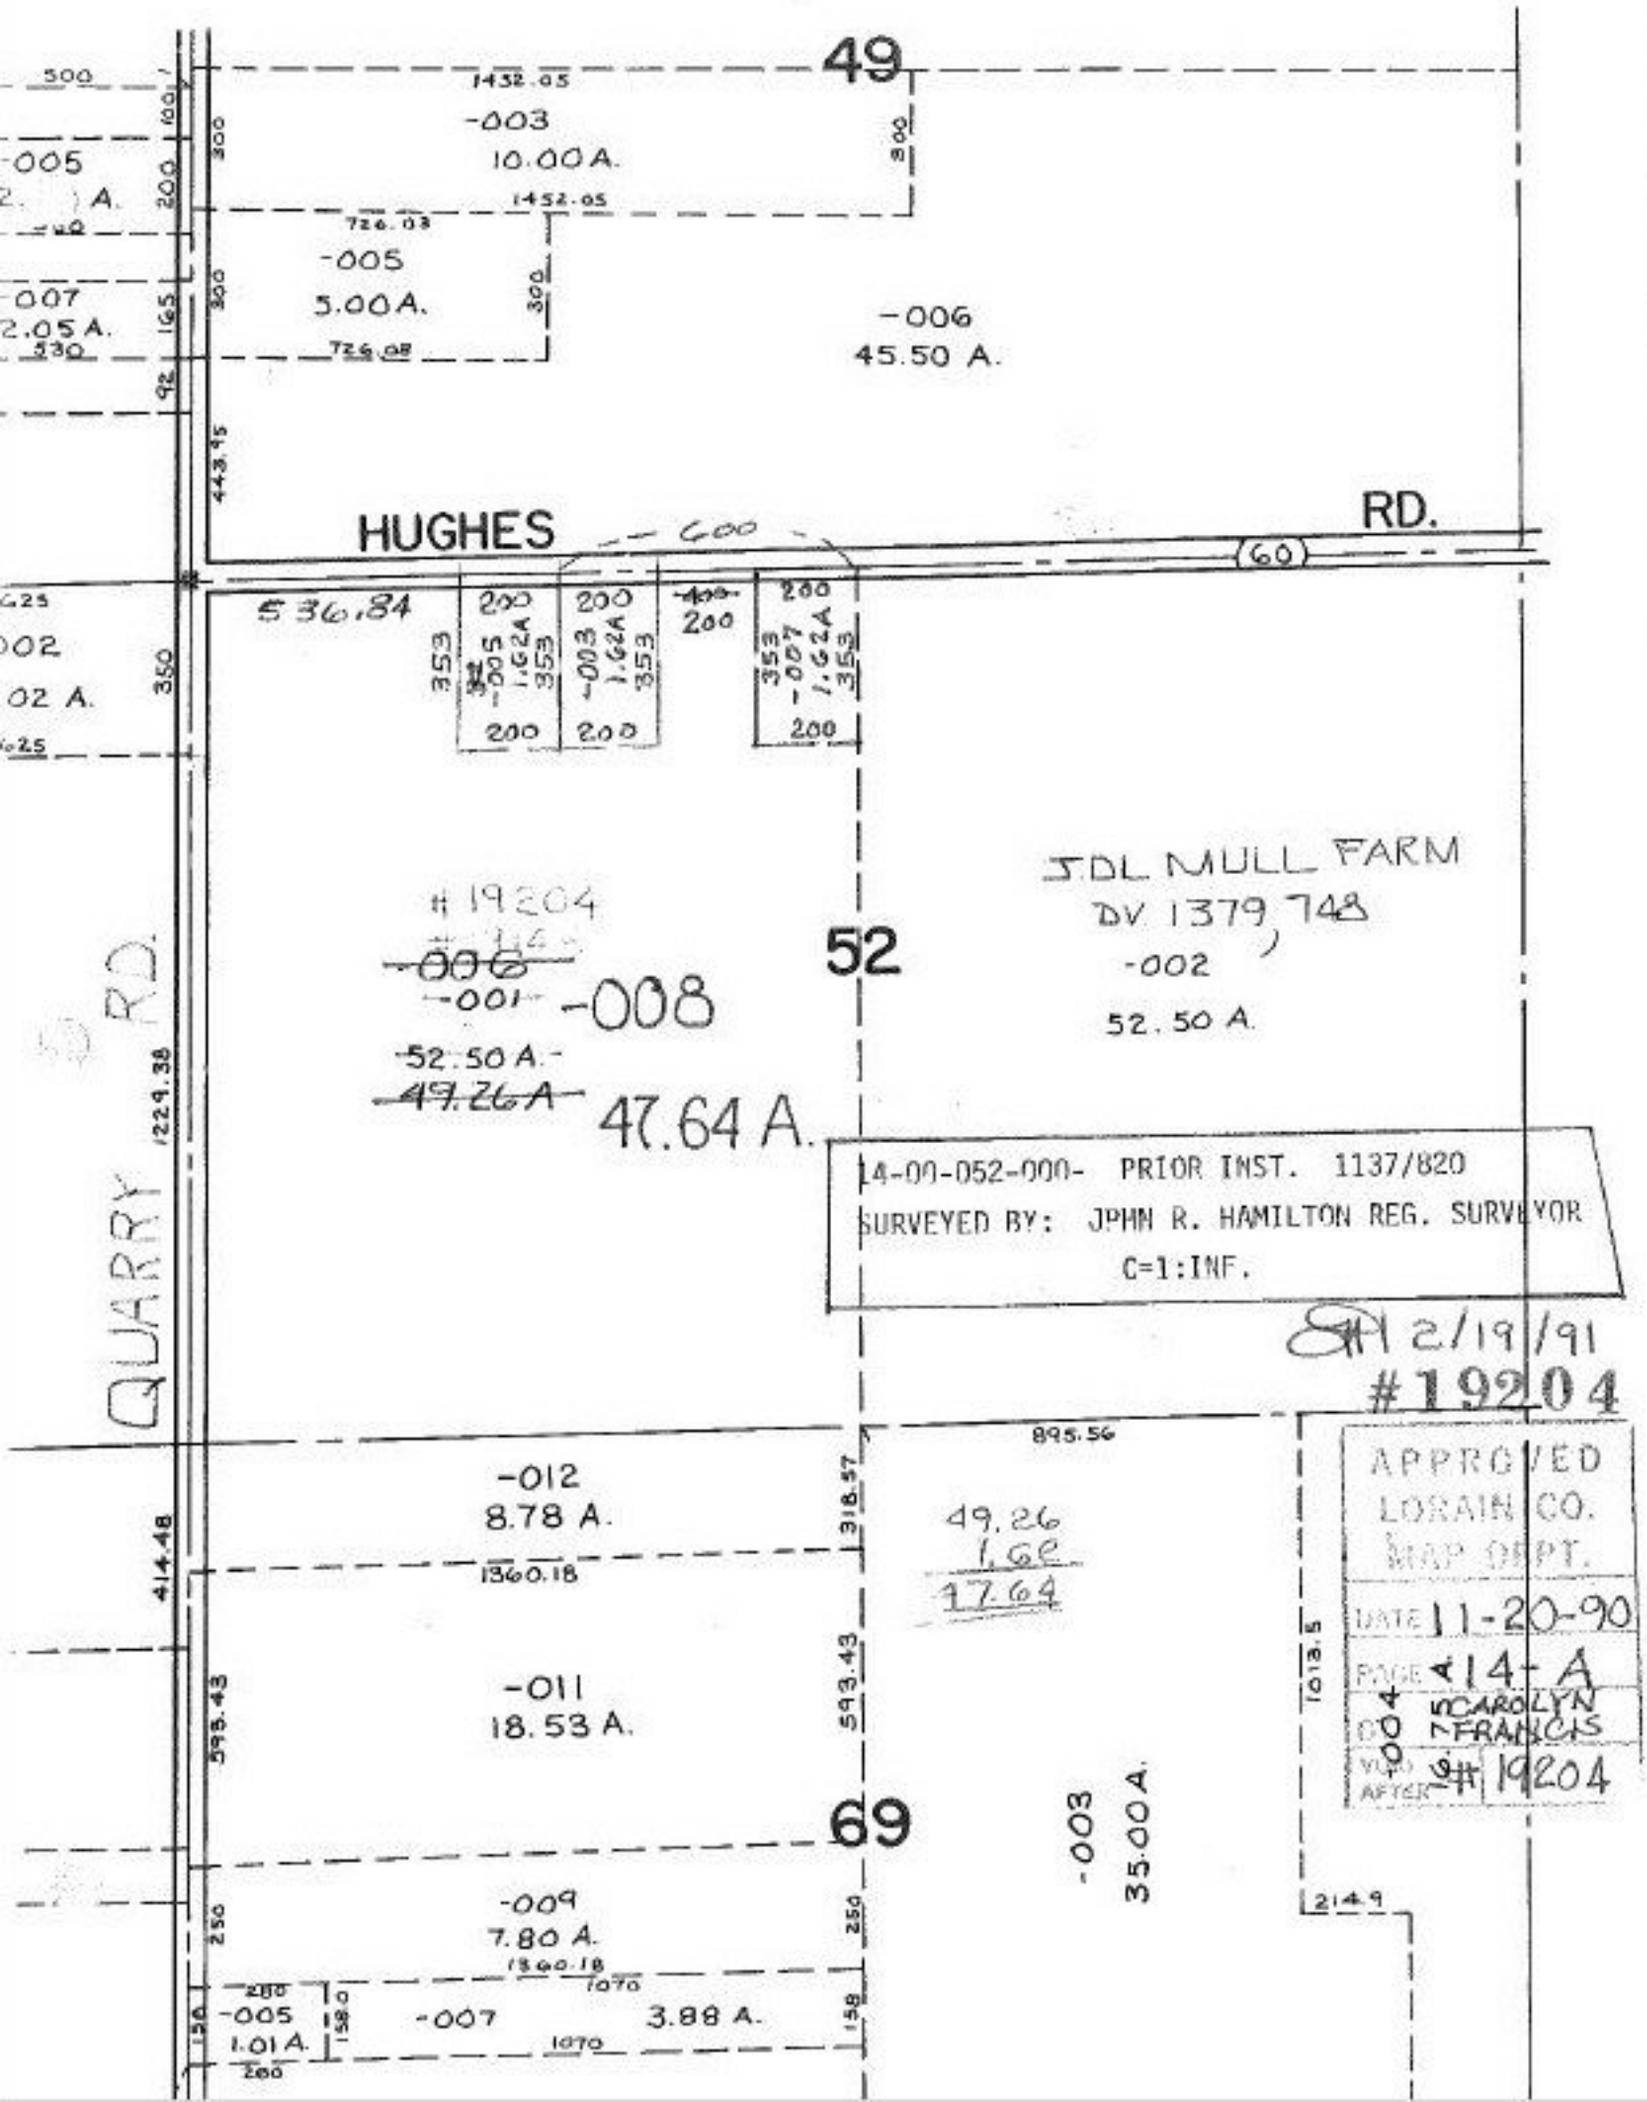
49
1432.05
-003
10.00 A.
1452.05
726.03
-005
5.00 A.
726.08
-006
45.50 A.
HUGHES
RD.
60
600
$36.84
-005
1.62A
-003
1.62A
-007
1.62A
52
#19204
-008
-001
52.50 A.
47.26A
47.64 A.
J.DL MULL FARM
DV 1379, 748
-002
52.50 A.
QUARRY RD.
1229.38
14-00-052-000- PRIOR INST. 1137/820
SURVEYED BY: JPHN R. HAMILTON REG. SURVEYOR
C=1:INF.
2/19/91
#19204
APPROVED
LORAIN CO.
MAP DEPT.
DATE 11-20-90
PAGE 14-A
CAROLYN FRANCIS
895.56
-012
8.78 A.
1360.18
414.48
318.57
49.26
1.62
47.64
-011
18.53 A.
598.43
593.43
1013.5
69
-003
35.00 A.
-009
7.80 A.
1360.18
1070
250
-005
1.01 A.
-007
3.88 A.
1070
158
214.9