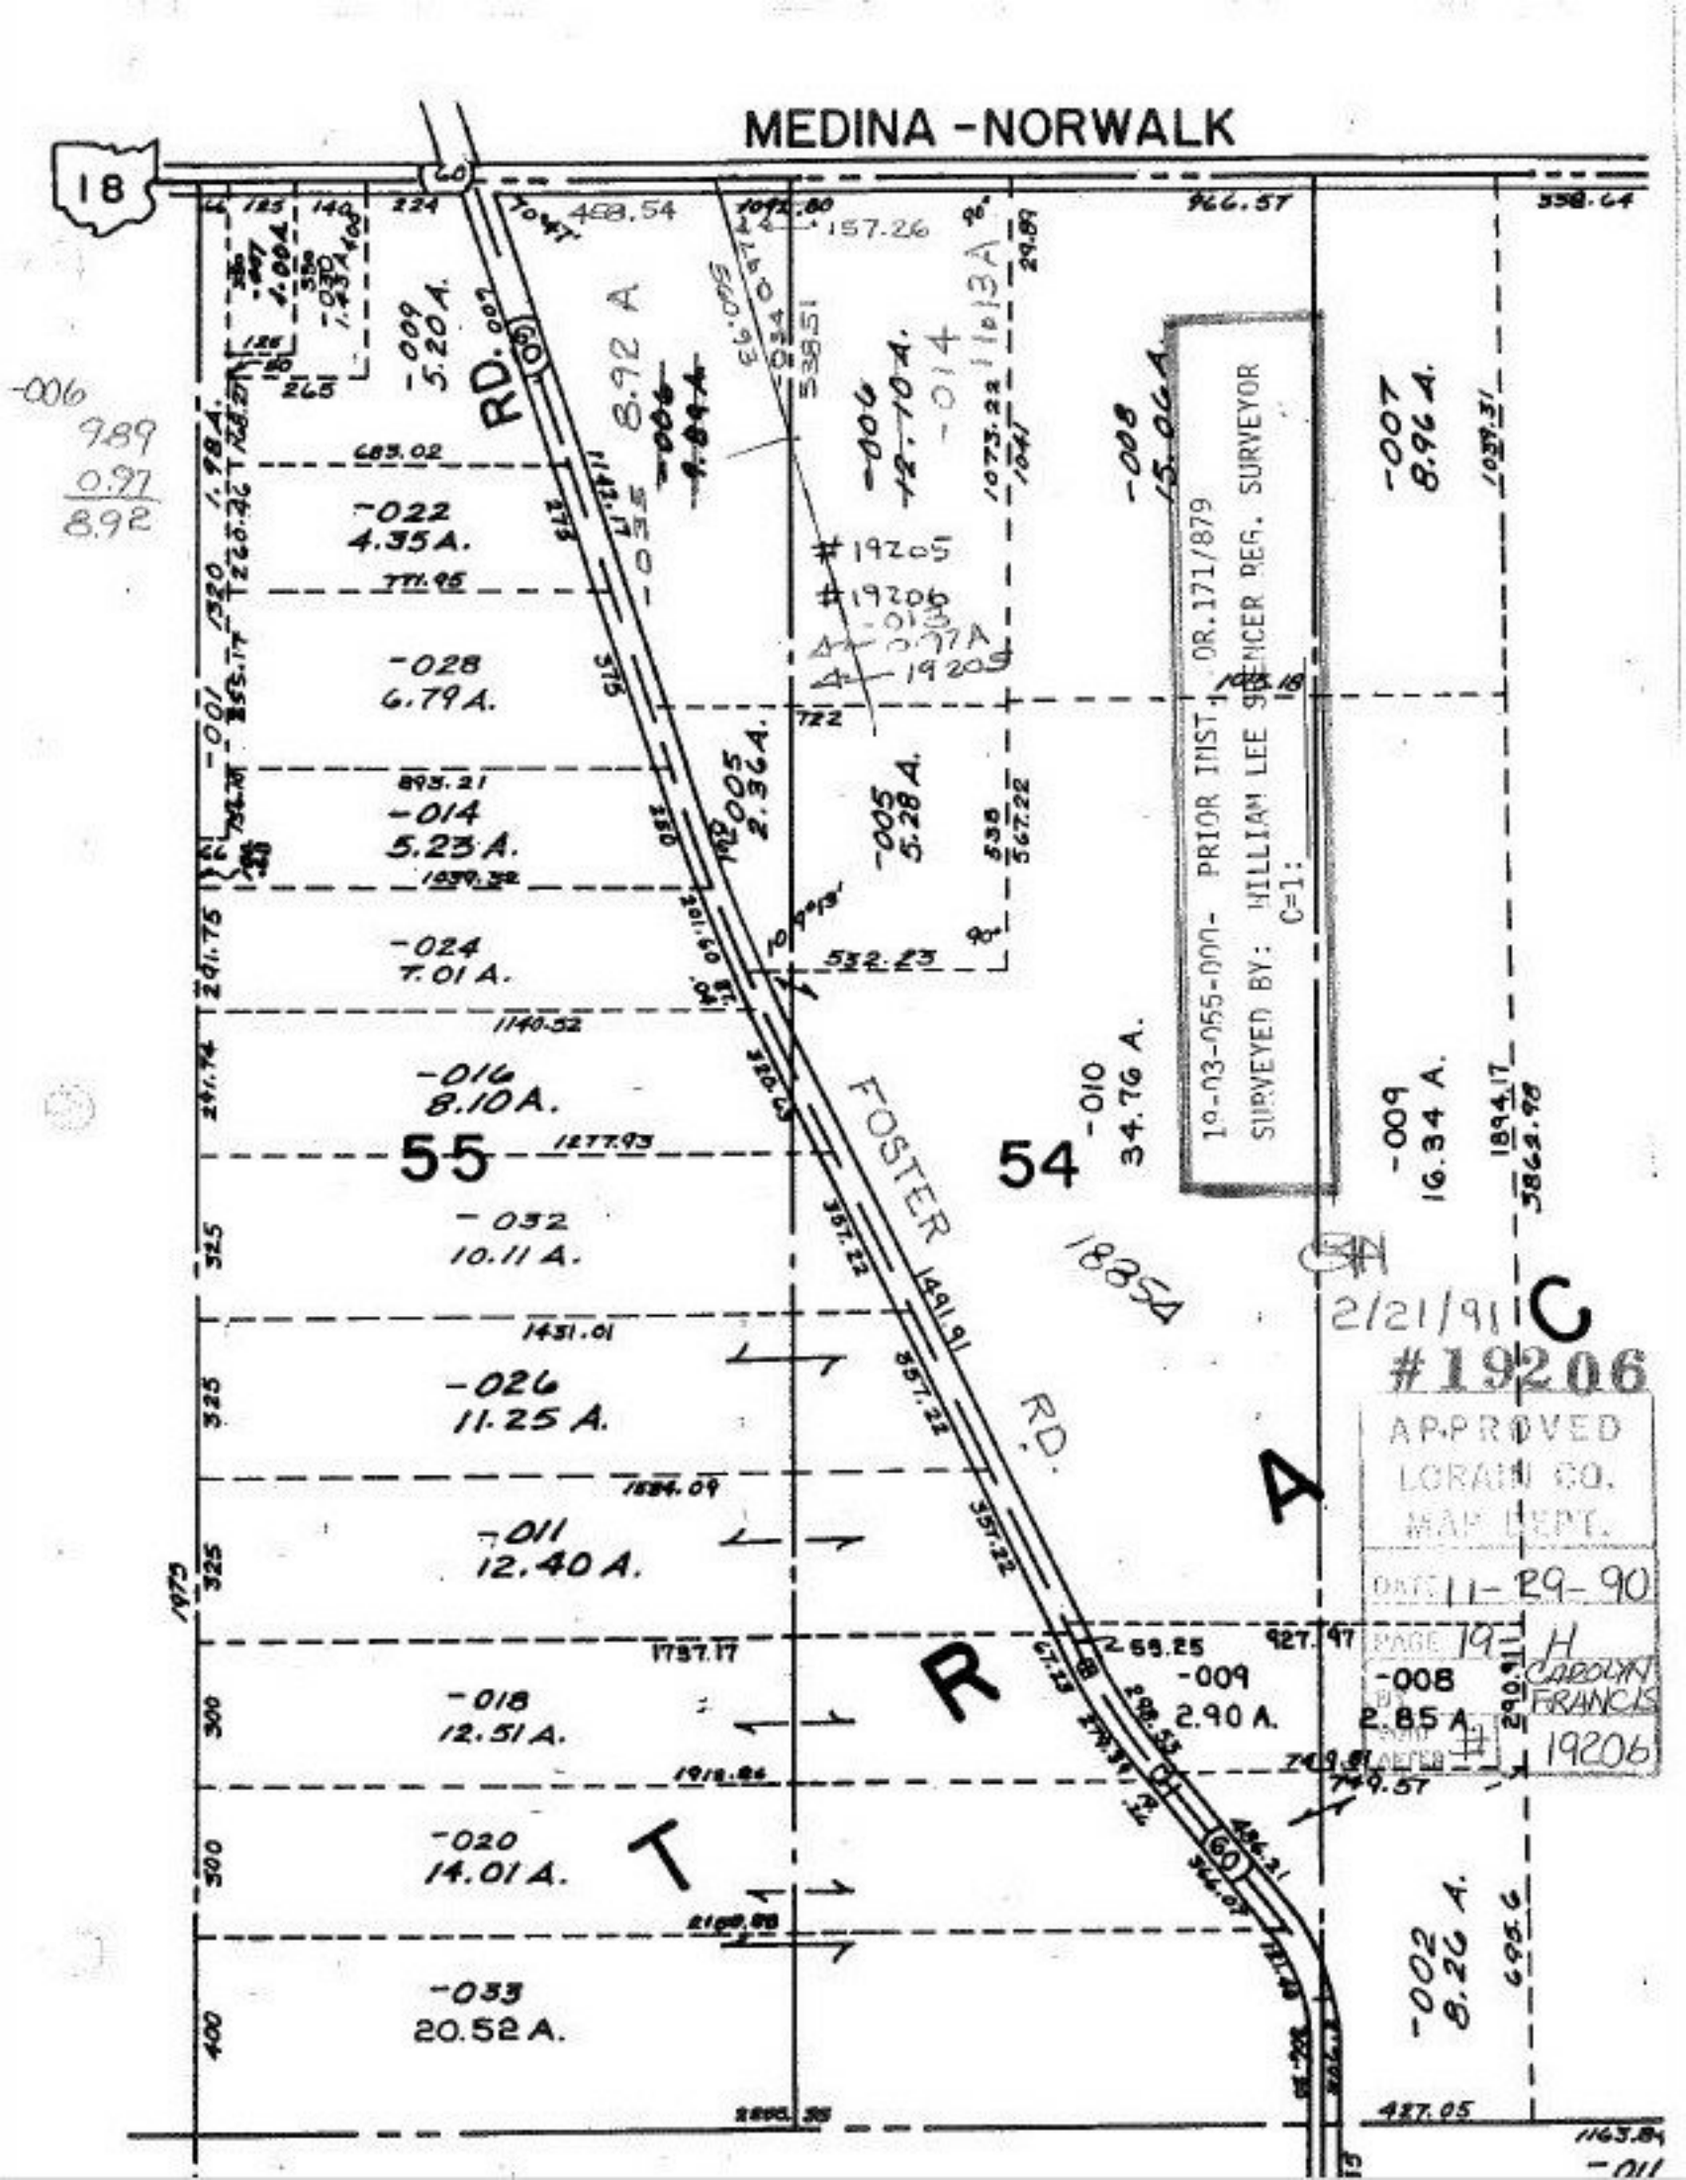
MEDINA - NORWALK
18
RD.
FOSTER RD.
55
54
T R A C
-022 4.35 A.
-028 6.79 A.
-014 5.23 A.
-024 7.01 A.
-016 8.10 A.
-032 10.11 A.
-026 11.25 A.
-011 12.40 A.
-018 12.51 A.
-020 14.01 A.
-033 20.52 A.
-009 5.20 A.
-005 2.36 A.
-005 5.28 A.
-006 12.10 A.
-008 15.06 A.
-007 8.96 A.
-010 34.76 A.
-009 16.34 A.
-009 2.90 A.
-008 2.85 A.
-002 8.26 A.
#19205
#19206
19-03-055-000- PRIOR INST. OR.171/879
SURVEYED BY: WILLIAM LEE SPENCER REG. SURVEYOR
C=1:
2/21/91
#19206
APPROVED
LORAIN CO.
MAP DEPT.
DATE 11-29-90
PAGE 19-H
CAROLYN FRANCIS
19206