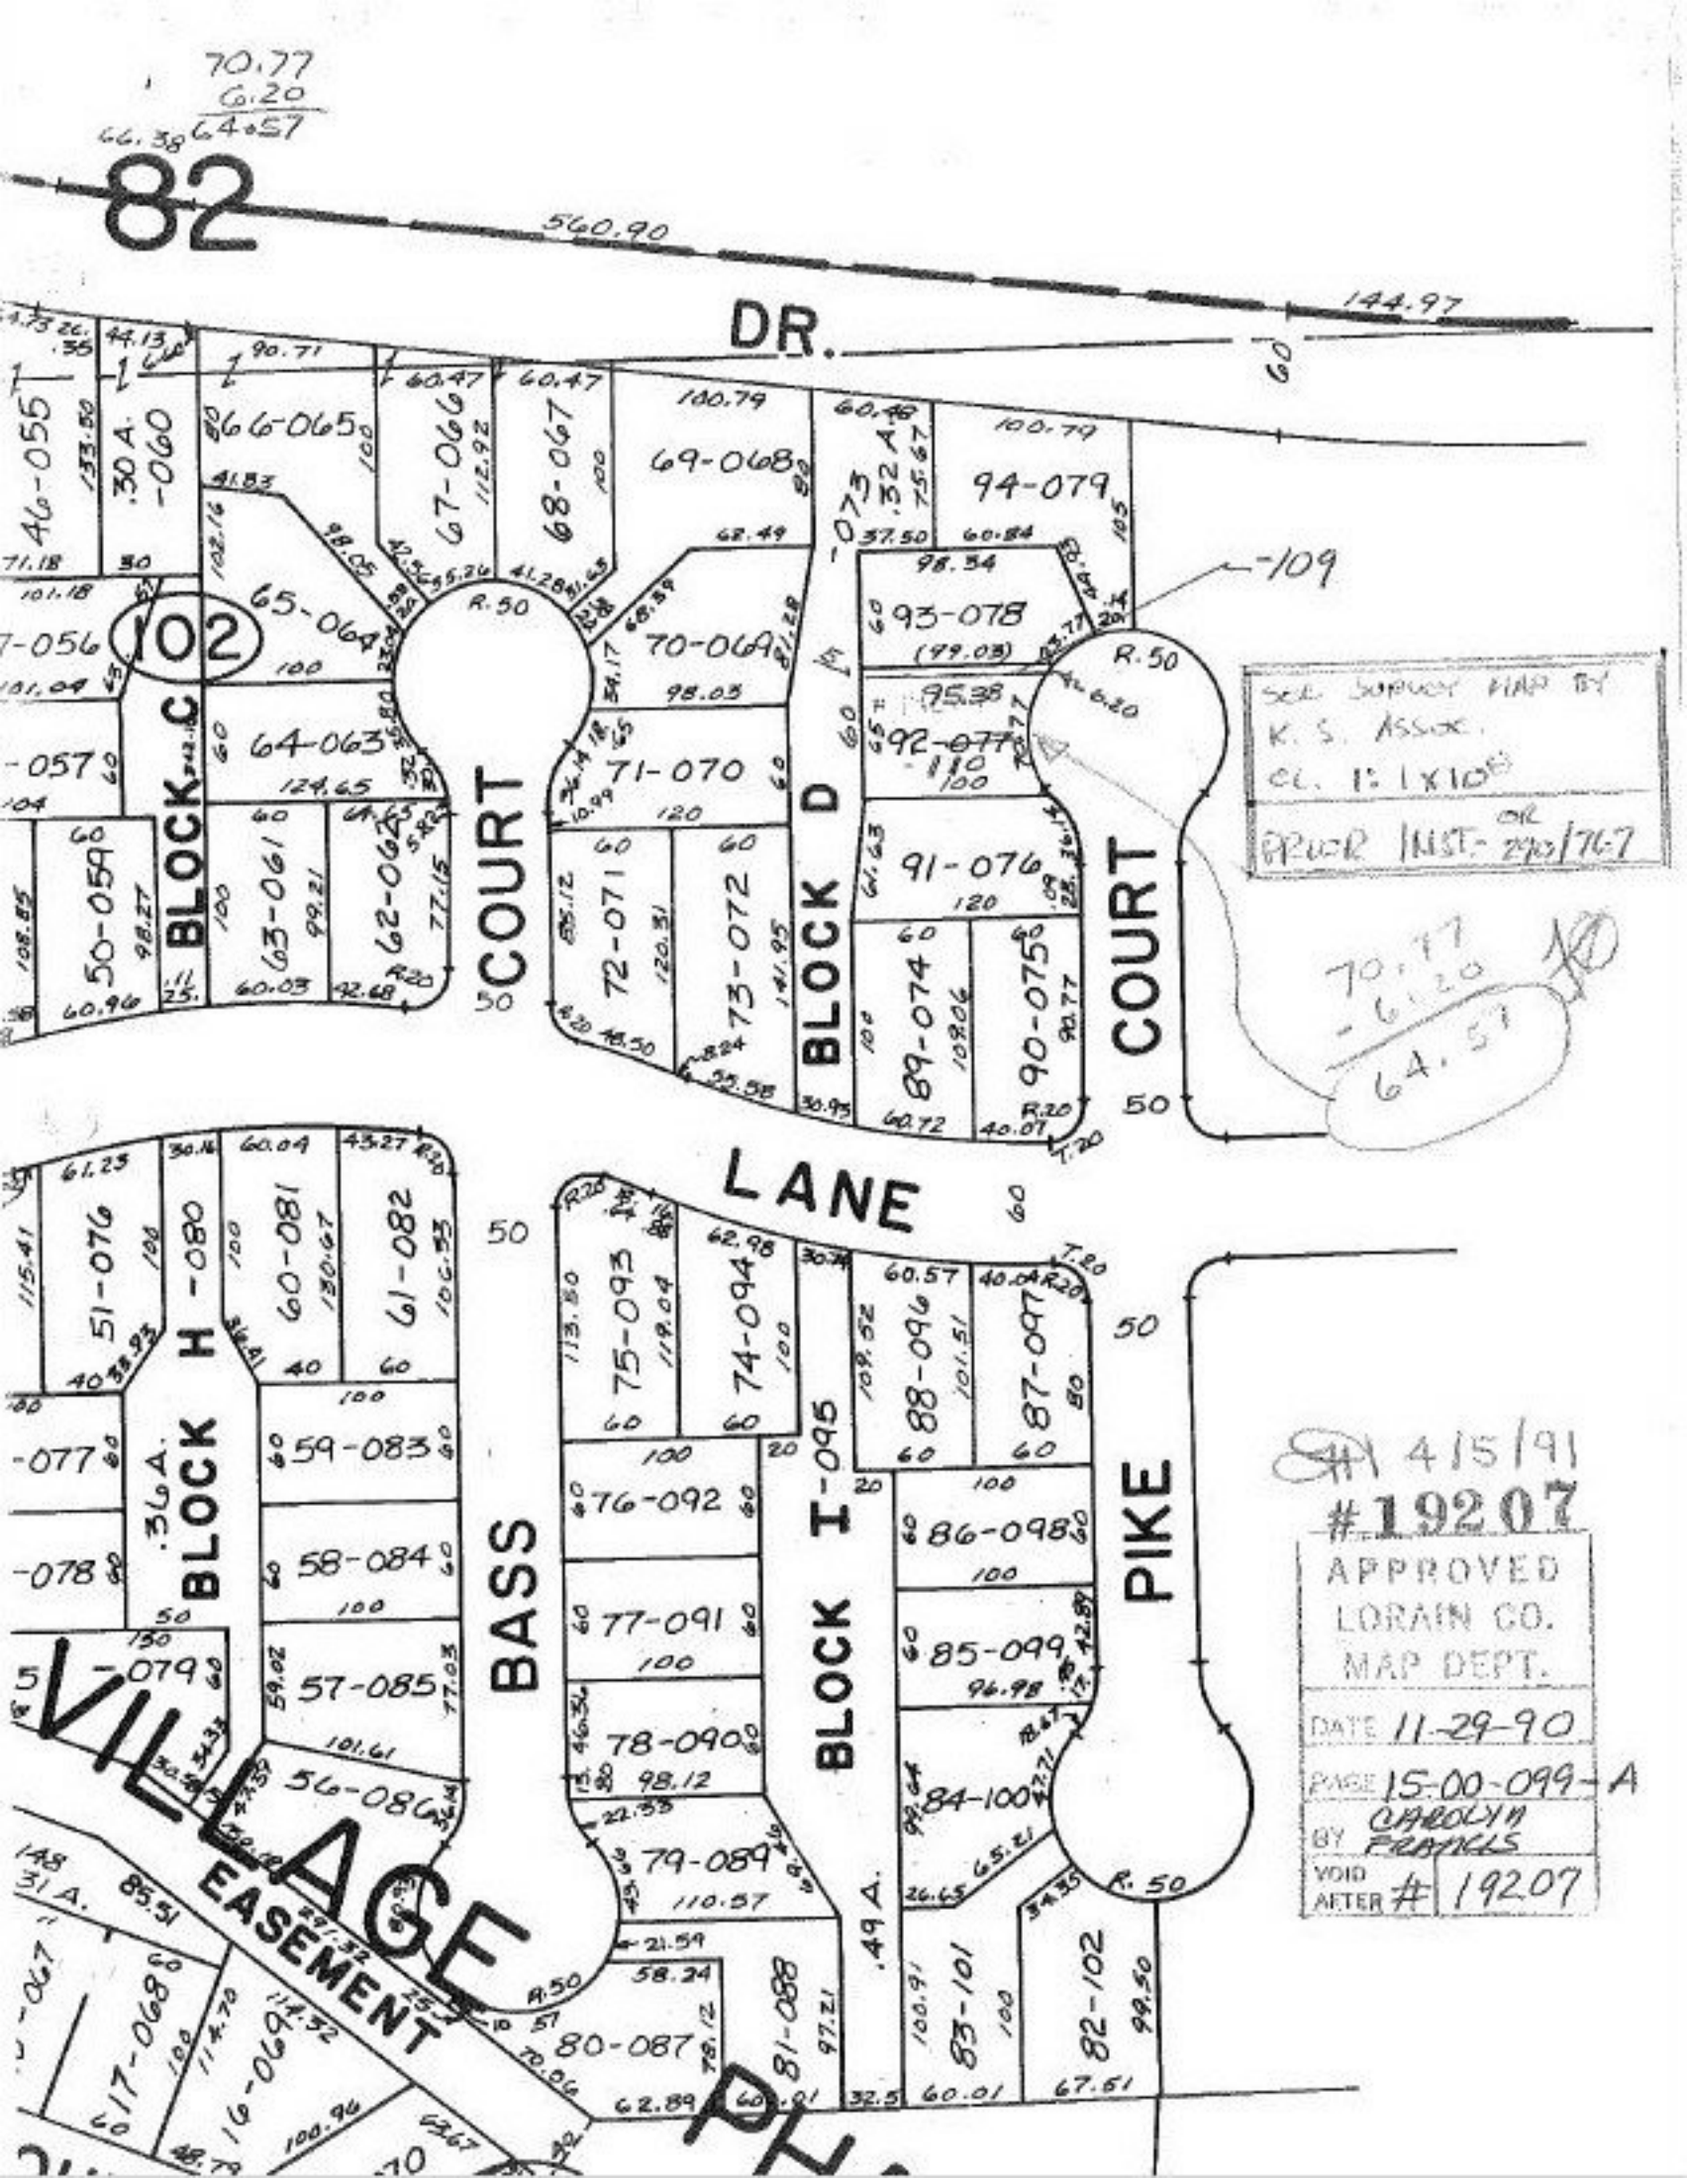

70.77
6.20
64.57
82
560.90
144.97
DR.
102
BLOCK C
COURT
BLOCK D
COURT
LANE
BLOCK H
BASS
BLOCK I
PIKE
VILLAGE
EASEMENT
-109
SEE SURVEY MAP BY
K. S. ASSOC.
CL. 1: 1X10
PRIOR INST. OR 290/767
70.77
-6.20
64.57
4/5/91
#19207
APPROVED
LORAIN CO.
MAP DEPT.
DATE 11-29-90
PAGE 15-00-099-A
BY CAROLYN FRANCIS
VOID AFTER # 19207