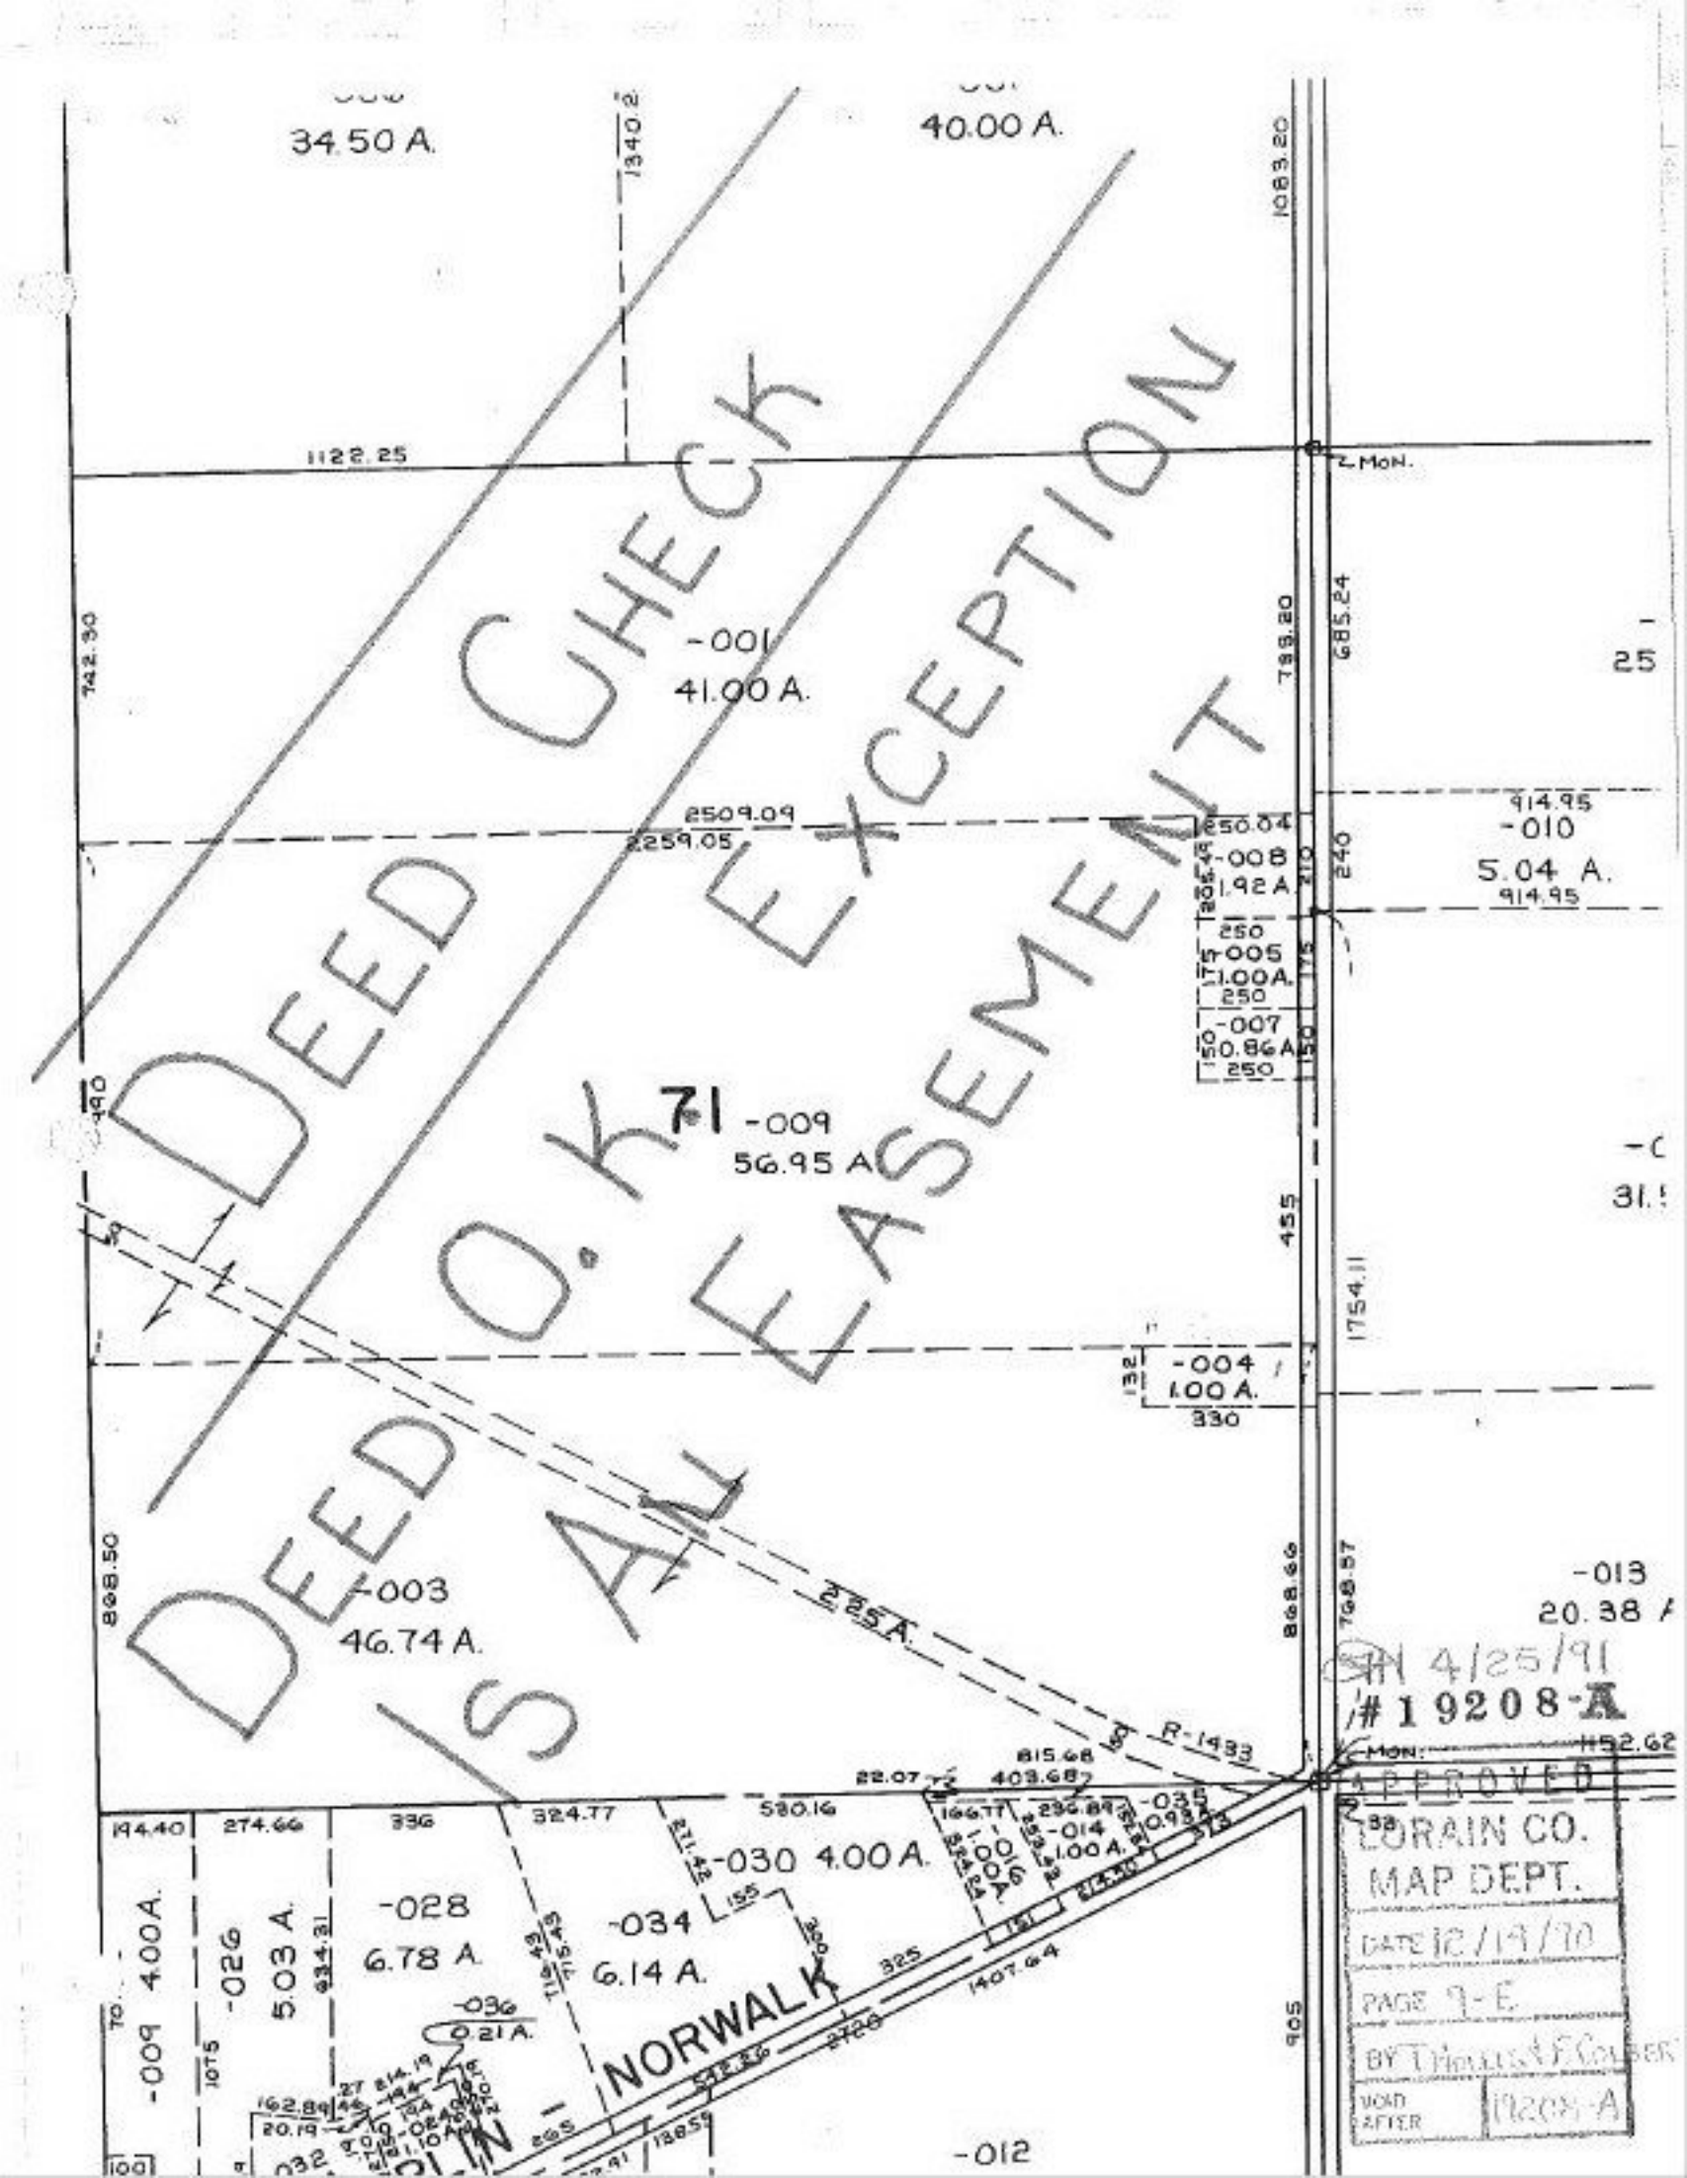
DEED CHECK
DEED O.K.
IS ALL
EXCEPTION
EASEMENT
34.50 A.
40.00 A.
1340.2
1083.20
1122.25
2 MON.
742.30
-001
41.00 A.
738.20
685.24
2509.09
2259.05
914.95
-010
5.04 A.
914.95
250.04
-008
1.92 A.
-005
1.00 A.
-007
0.86 A.
71 -009
56.95 A.
455
1754.11
-004
1.00 A.
330
868.50
-003
46.74 A.
2.25 A.
R-1483
868.66
768.57
-013
20.38 A
4/25/91
#19208-A
1152.62
MON.
815.68
403.68
22.07
194.40
274.66
336
324.77
530.16
-030 4.00 A.
-014
1.00 A.
-016
1.00 A.
-035
0.98 A.
-009 4.00 A.
-026
5.03 A.
-028
6.78 A.
-034
6.14 A.
-036
0.21 A.
NORWALK
1407.64
-012
APPROVED
LORAIN CO.
MAP DEPT.
DATE 12/19/90
PAGE 9-E
BY T. Hollis & F. Colbert
VOID AFTER
19208-A