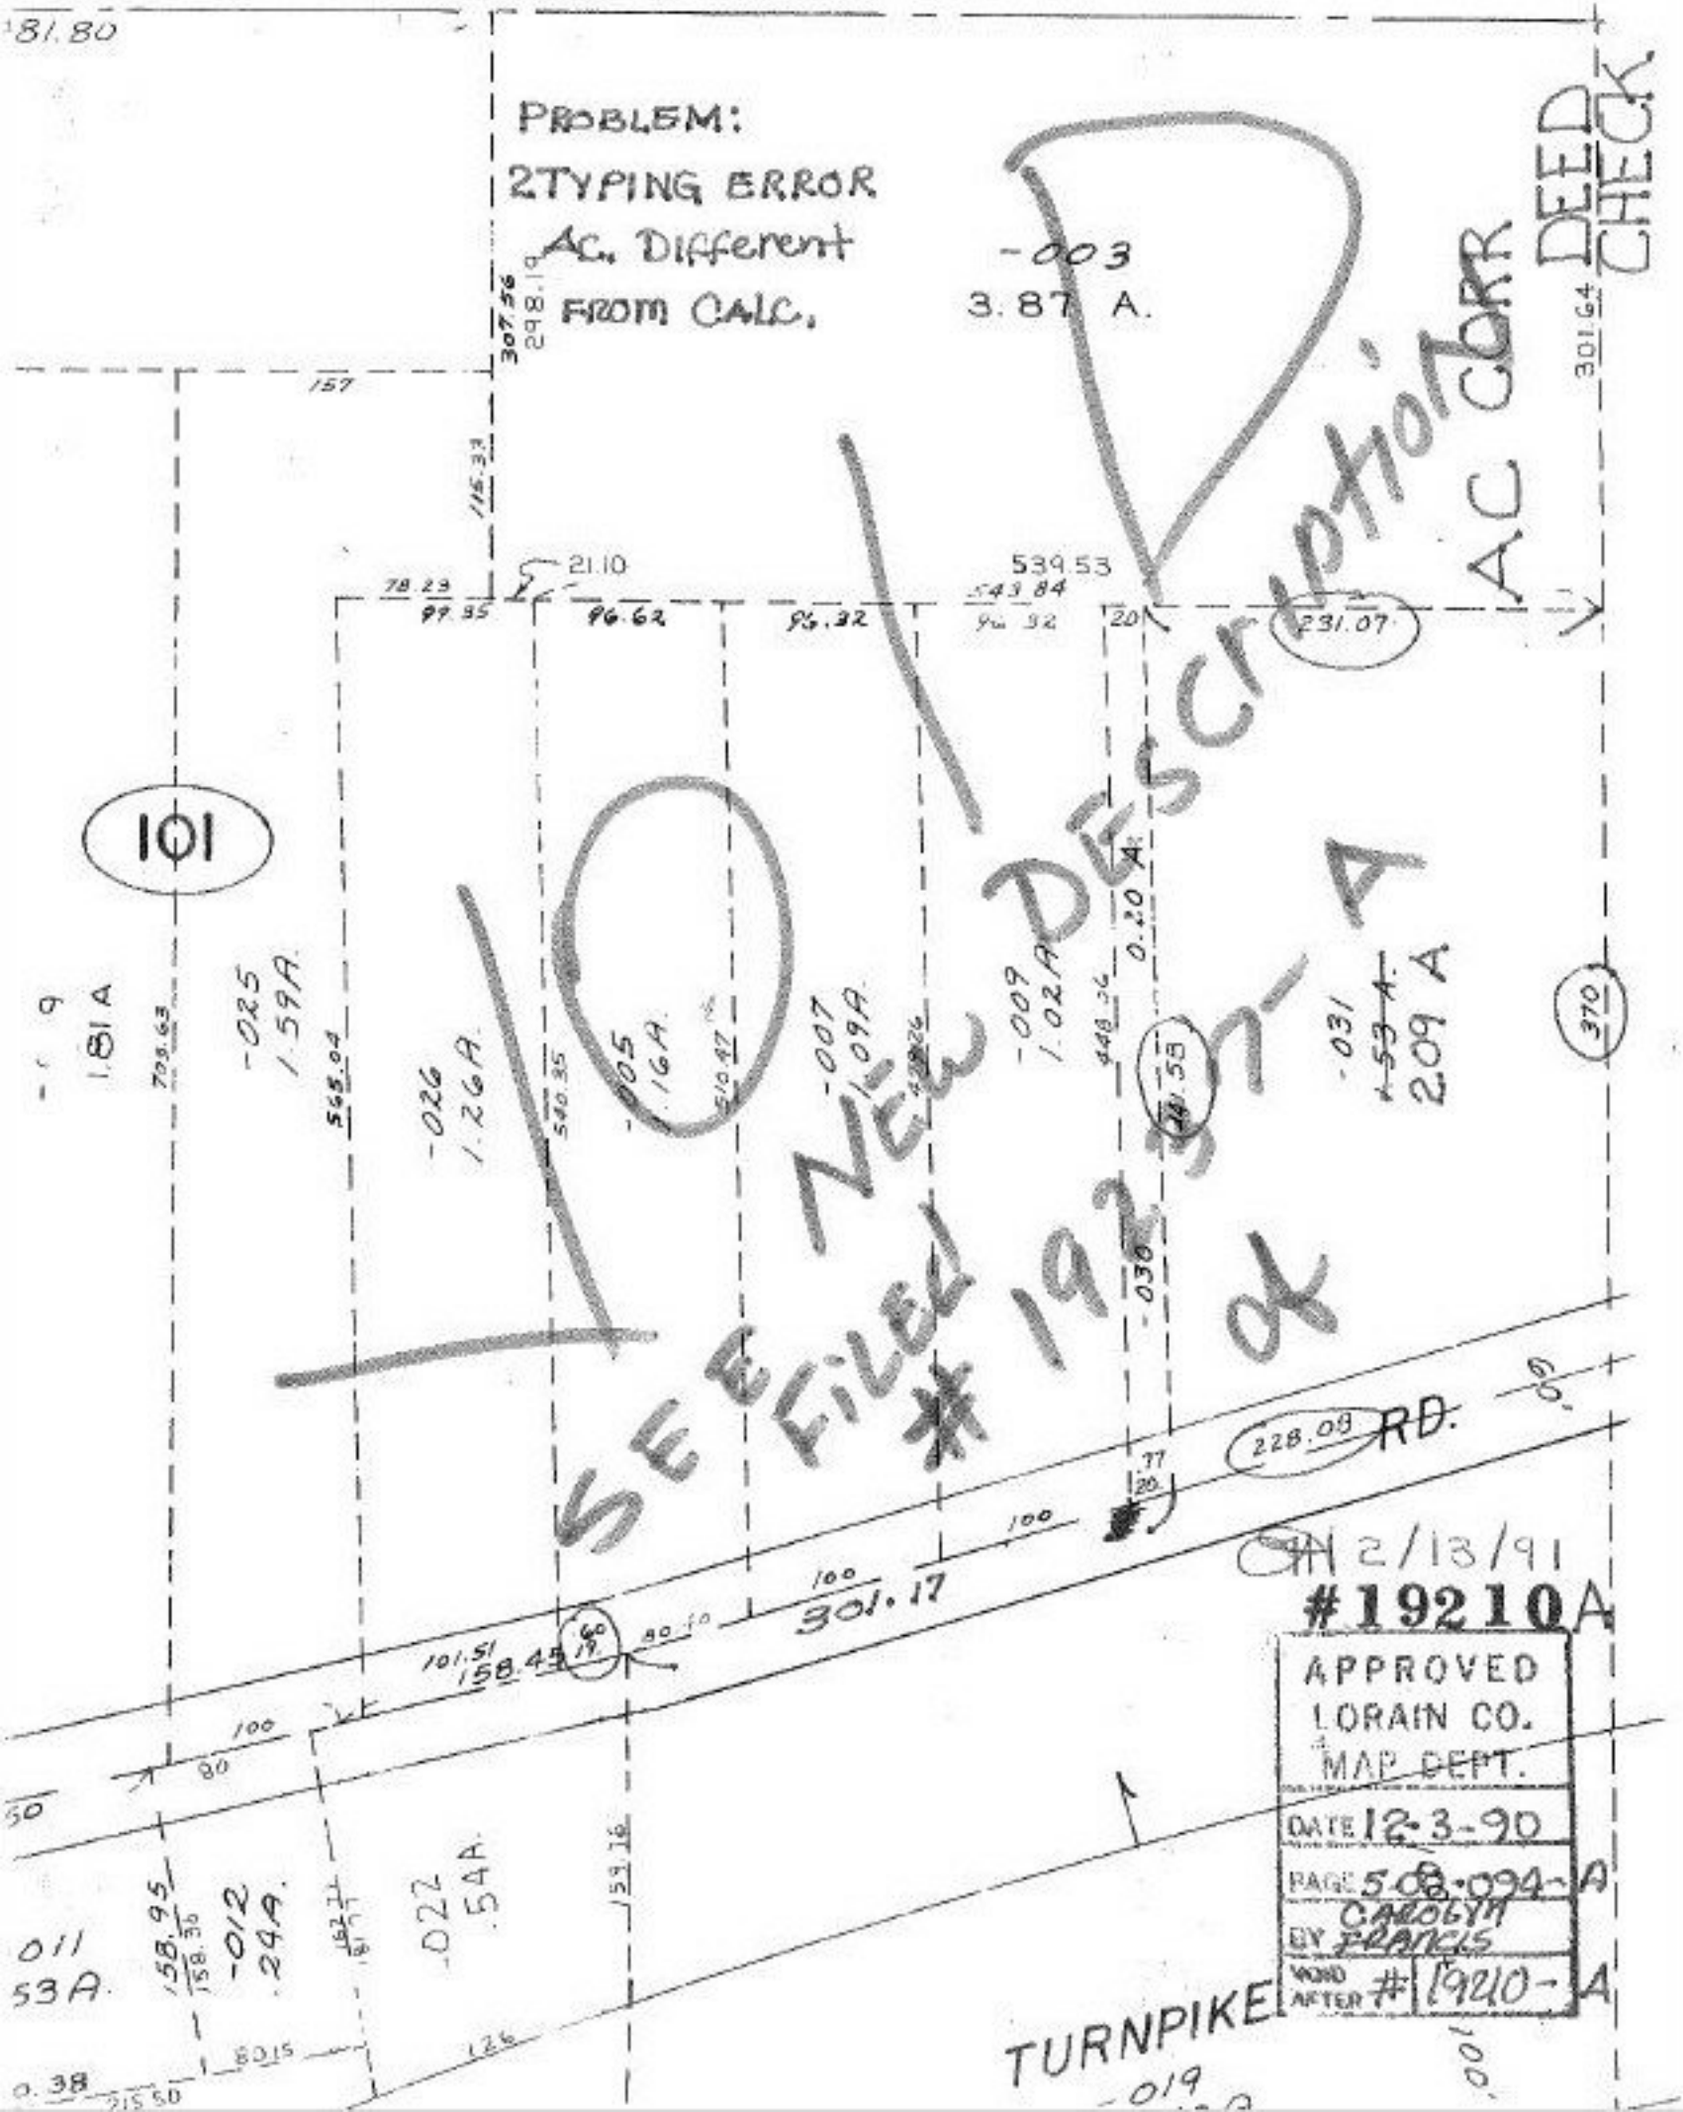
PROBLEM:
2TYPING ERROR
AC. Different
FROM CALC.
-003
3.87 A.
DEED CHECK
AC CORR
101
-025
1.59A
-026
1.26A
-005
1.16A
-007
1.09A
-009
1.02A
-031
209 A
-030
-019
-012
.24A
-022
.54A
-011
53A
TURNPIKE
RD.
SEE NEW DESCRIPTION
FILED #19237-A
ok
2/13/91
#19210A
APPROVED
LORAIN CO.
MAP DEPT.
DATE 12-3-90
PAGE 5-08-094-A
BY CAROLYN FRANCIS
VOID AFTER # 19210-A