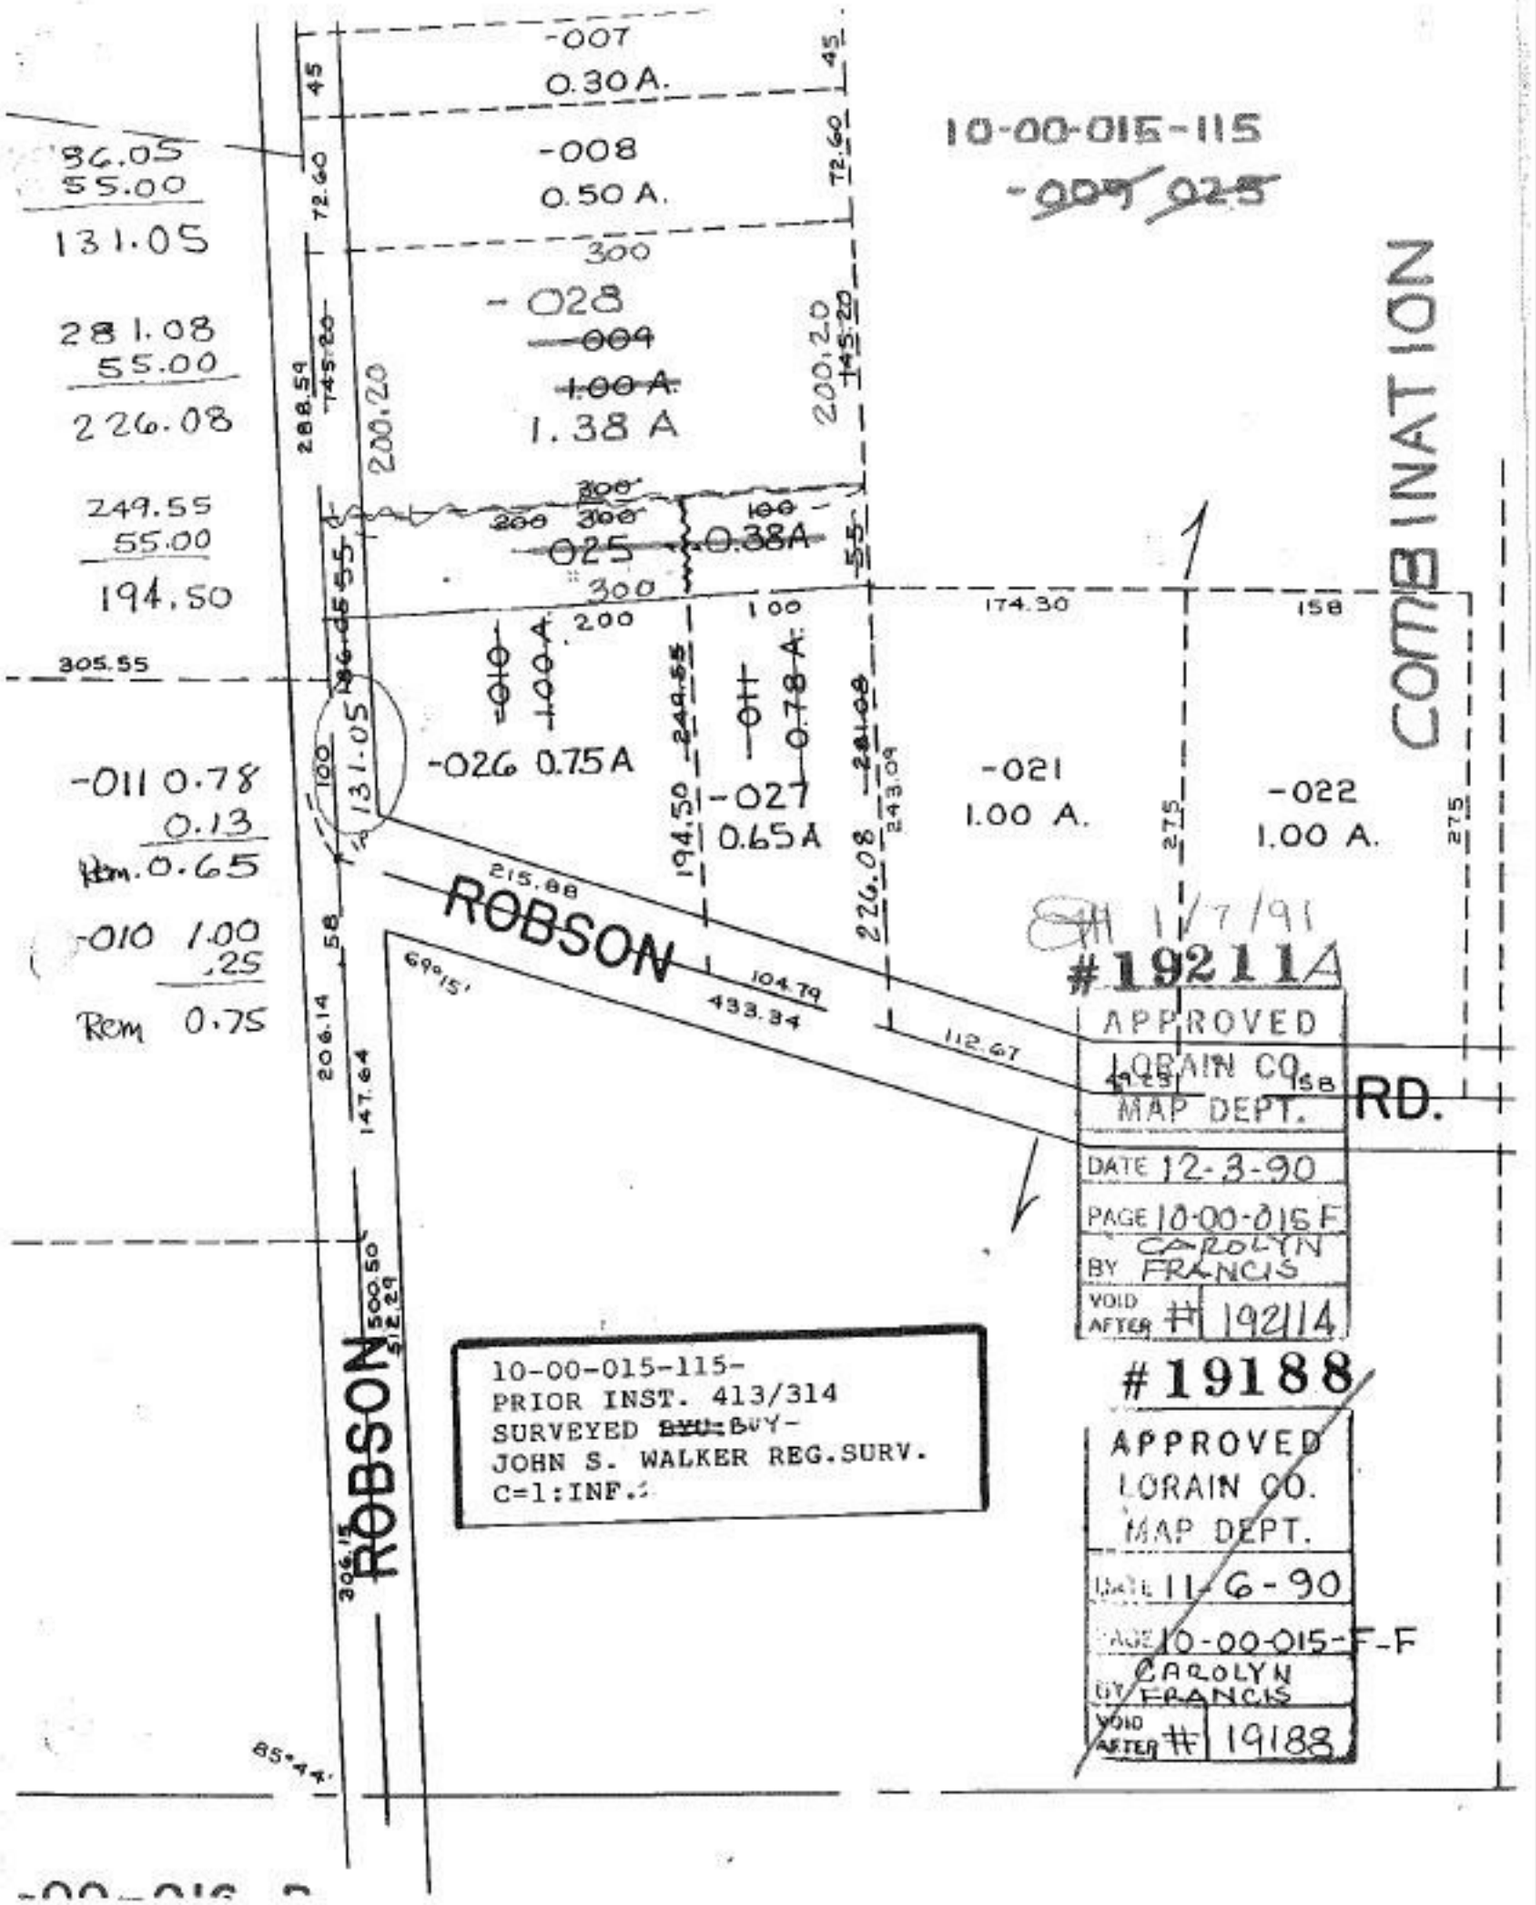

10-00-015-115
-007 0.30 A.
-008 0.50 A.
-028 1.38 A
-025 0.38A
-026 0.75A
-027 0.65A
-021 1.00 A.
-022 1.00 A.
-011 0.78
0.13
Rem. 0.65
-010 1.00
.25
Rem 0.75
86.05
55.00
131.05
281.08
55.00
226.08
249.55
55.00
194.50
305.55
ROBSON
ROBSON
RD.
COMBINATION
#19211A
APPROVED
LORAIN CO.
MAP DEPT.
DATE 12-3-90
PAGE 10-00-015 F
BY CAROLYN FRANCIS
VOID AFTER # 19211A
#19188
APPROVED
LORAIN CO.
MAP DEPT.
DATE 11-6-90
PAGE 10-00-015-F-F
BY CAROLYN FRANCIS
VOID AFTER # 19188
10-00-015-115-
PRIOR INST. 413/314
SURVEYED BUY-
JOHN S. WALKER REG.SURV.
C=1:INF.