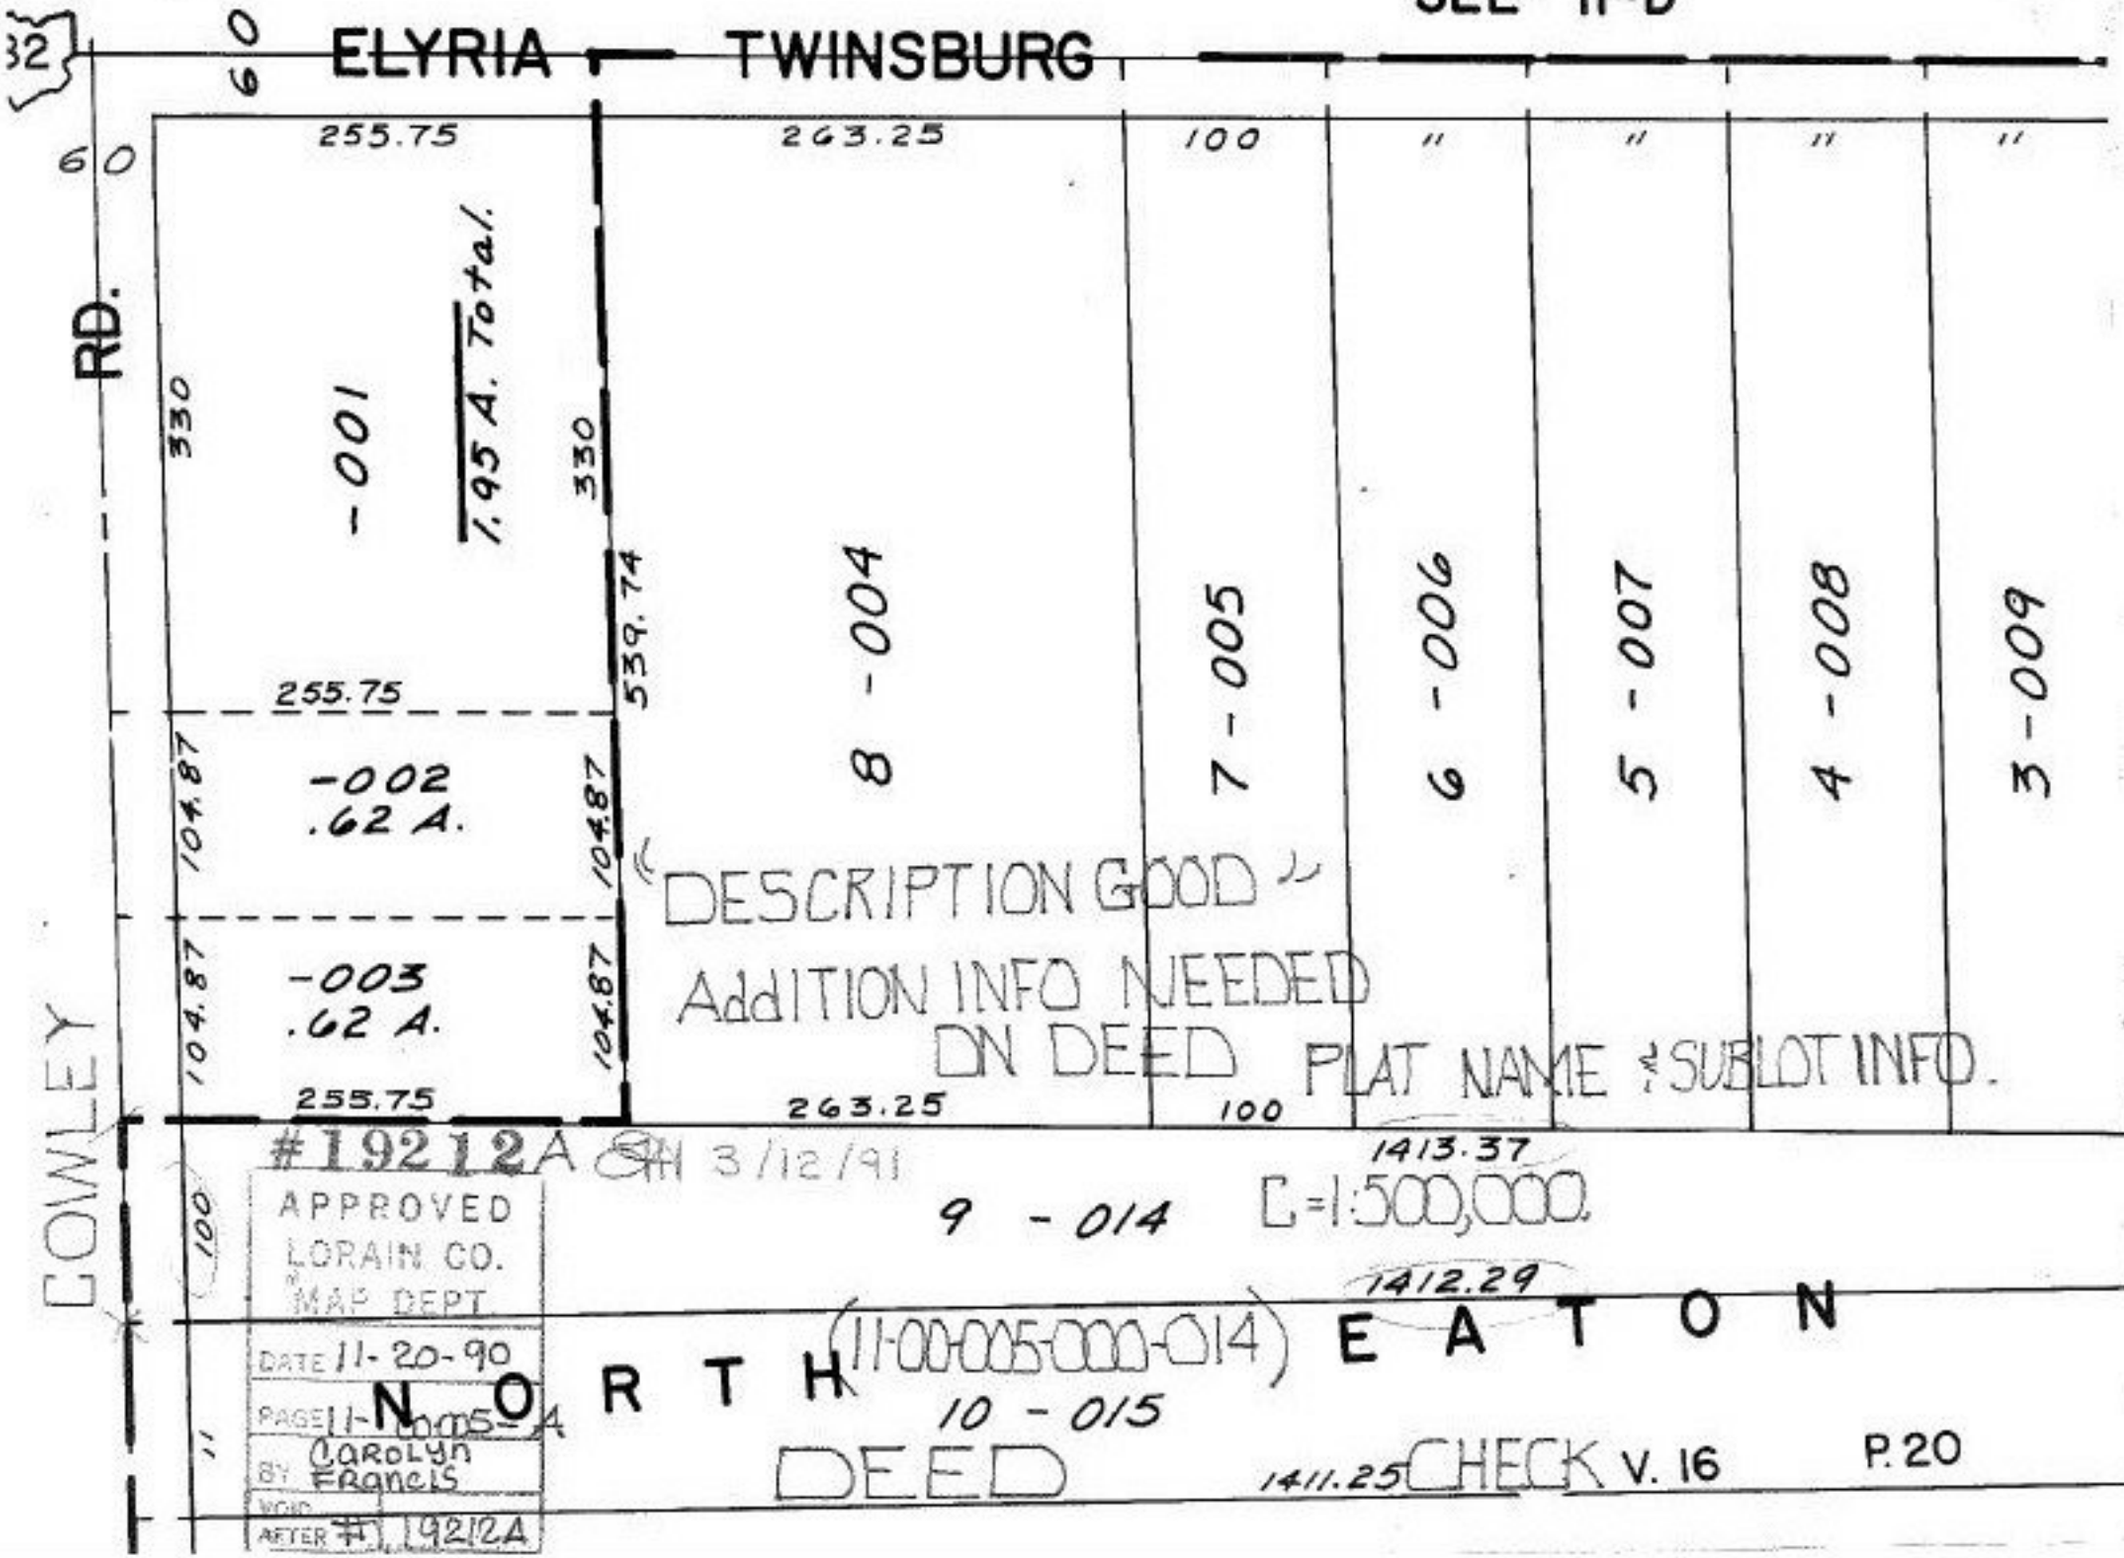
SEE II-D
32
60
ELYRIA — TWINSBURG
60
RD.
255.75
263.25
100
"
"
"
"
330
-001
1.95 A. Total
330
539.74
8 - 004
7 - 005
6 - 006
5 - 007
4 - 008
3 - 009
255.75
104.87
-002
.62 A.
104.87
104.87
-003
.62 A.
104.87
255.75
263.25
100
1413.37
1412.29
1411.25
100
11
DESCRIPTION GOOD
ADDITION INFO NEEDED
ON DEED PLAT NAME & SUBLOT INFO.
#19212A SH 3/12/91
9 - 014
C=1:500,000
10 - 015
(11-00-005-000-014)
DEED
CHECK V. 16
P. 20
COWLEY
NORTH
EATON
APPROVED
LORAIN CO.
MAP DEPT.
DATE 11-20-90
PAGE 11-Loop5=A
BY Carolyn Francis
VOID
AFTER #19212A