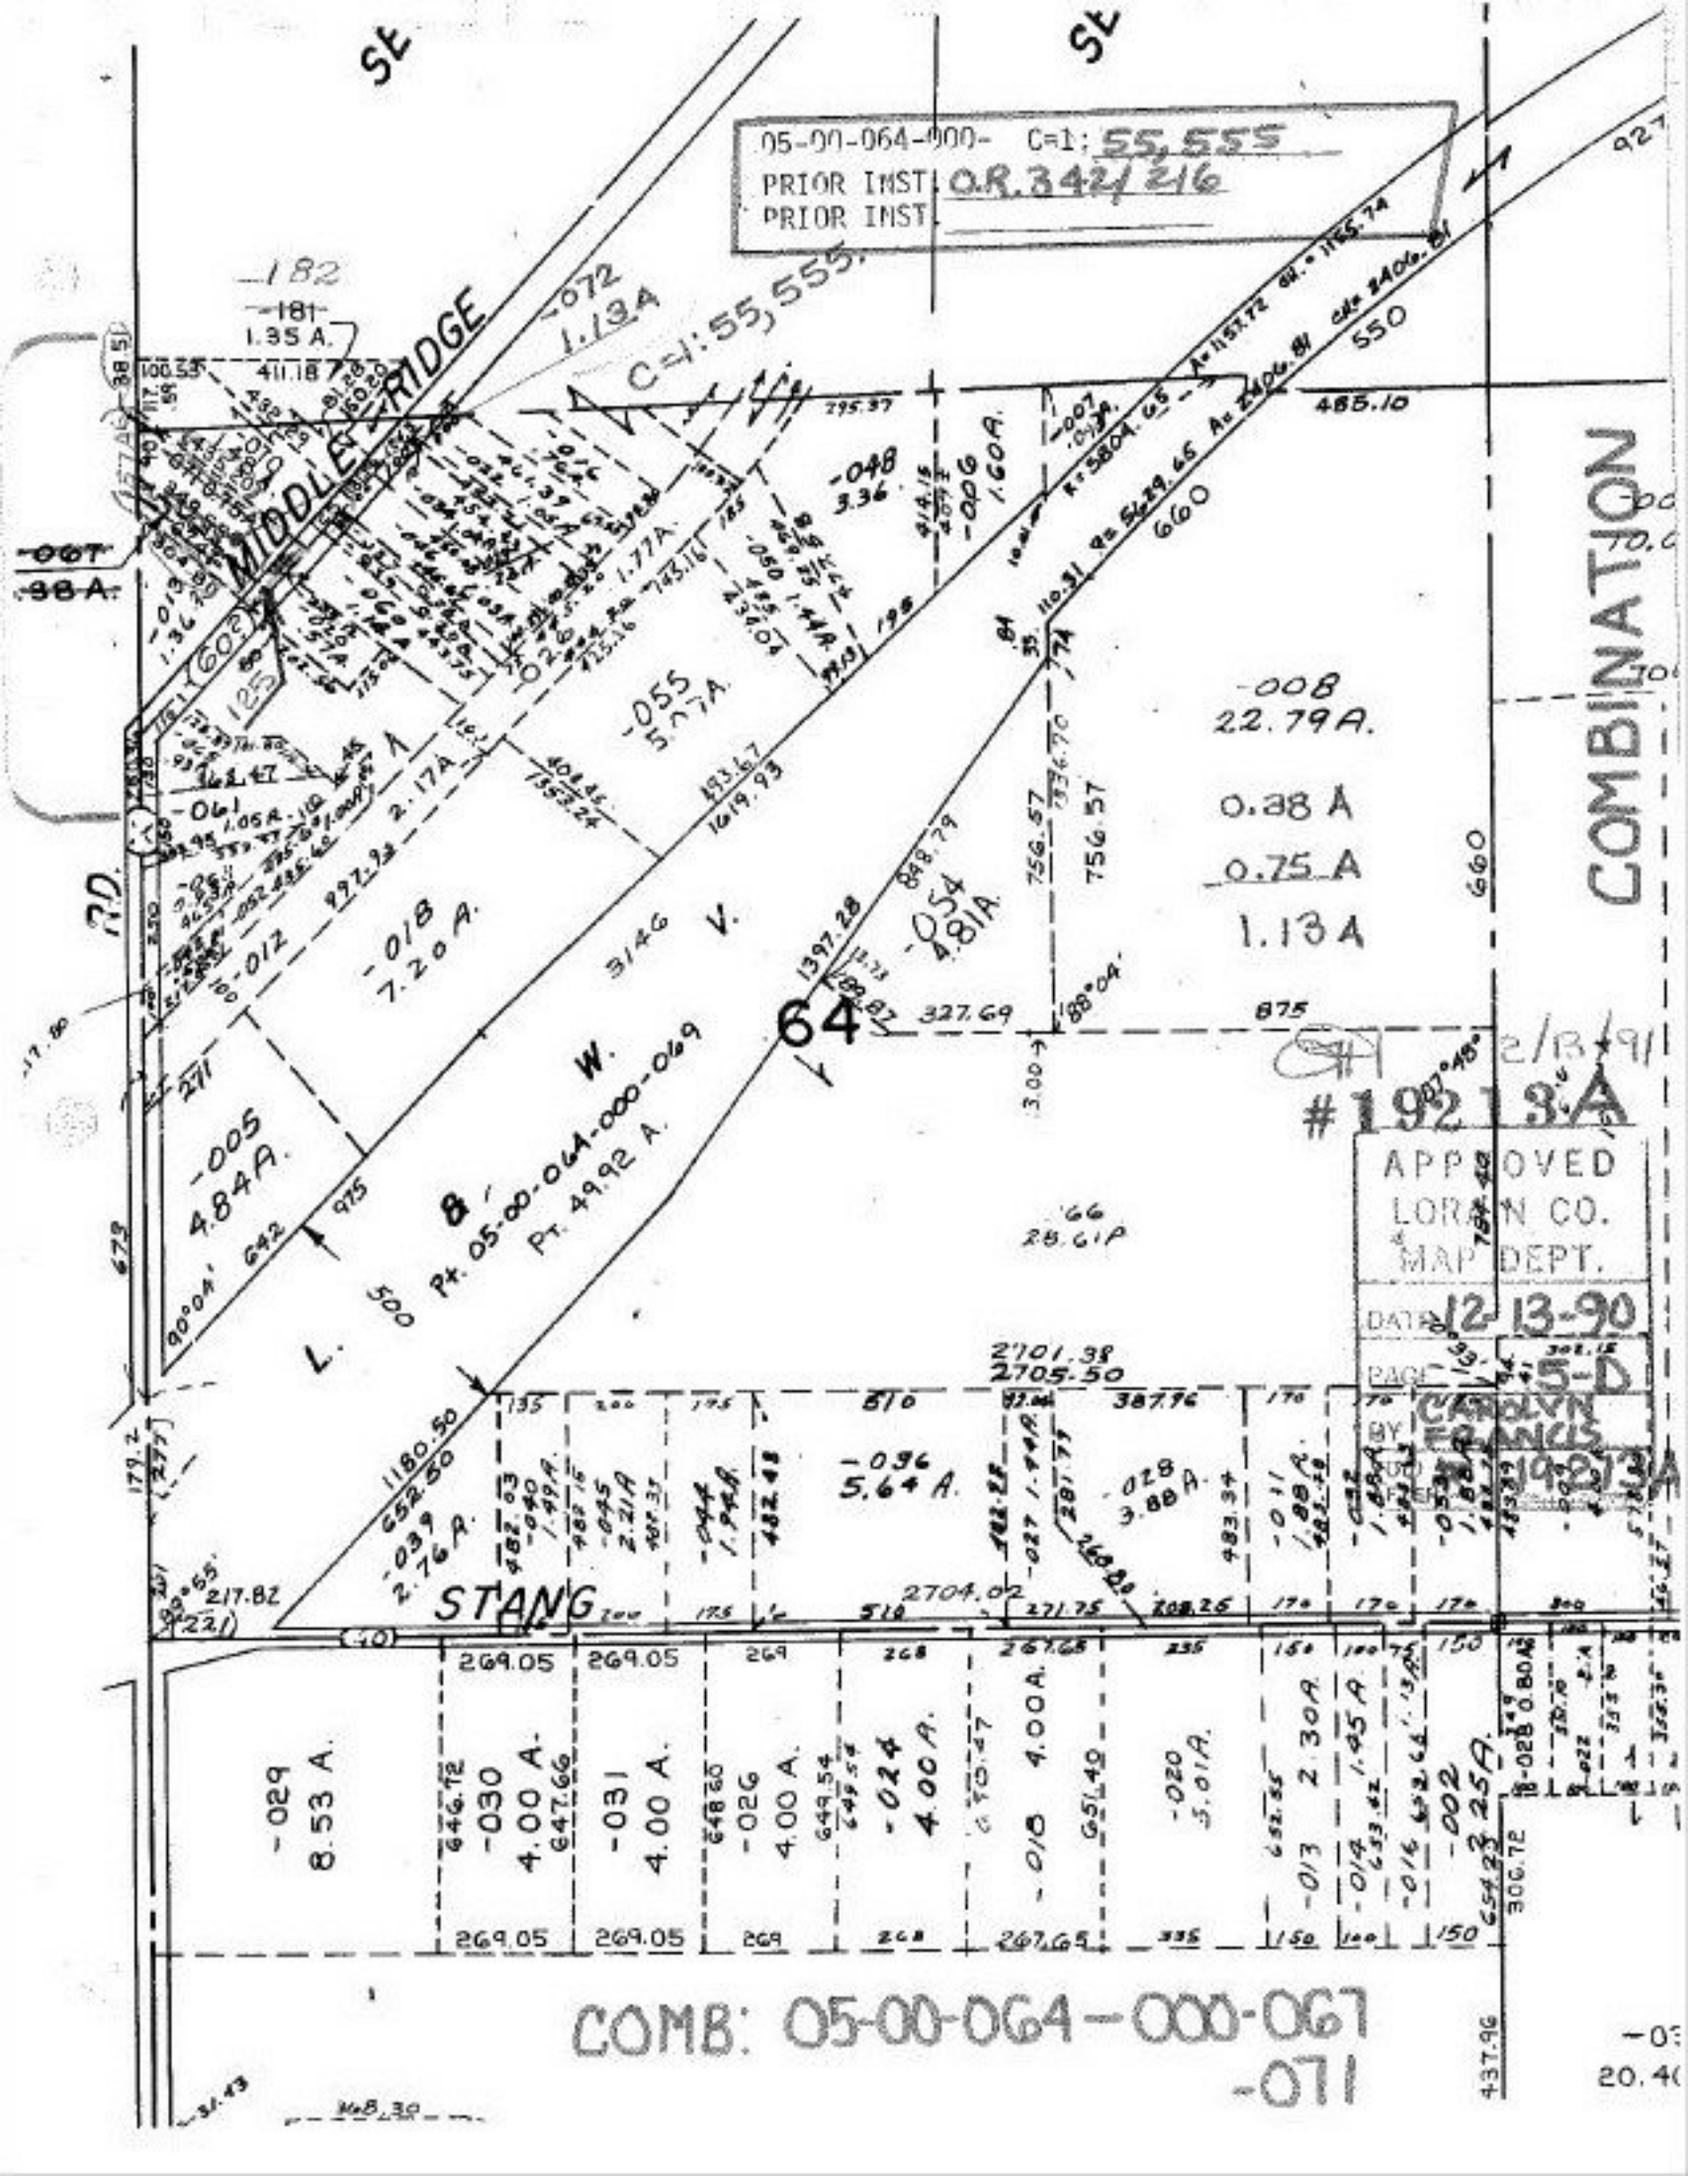
05-00-064-000- C=1; 55,555
PRIOR INST: O.R. 342/216
PRIOR INST:
C=1: 55,555
MIDDLE RIDGE
COMBINATION
-072
1.13A
-048
3.36
-055
5.17A
-008
22.79A.
0.88 A
0.75 A
1.13 A
-018
7.20A.
-054
4.81A
-005
4.84A.
-029
8.53 A.
-030
4.00 A.
-031
4.00 A.
-026
4.00 A.
-024
4.00A.
-010
4.00A.
-020
5.01A.
-013
2.30A.
-014
1.45A.
-016
-002
3.25A.
-028
0.80A.
-039
2.76A.
-036
5.64 A.
-028
3.88A.
-011
1.88A.
-012
-061
1.05A.
-060
1.44A.
-026
1.77A.
-027
1.94A.
-044
1.94A.
-045
2.21A.
-040
1.49A.
-022
2.17A.
-007
1.60A.
-006
1.60A.
-013
1.36A.
-181
1.35 A.
-182
-067
-98A.
STANG
MIDDLE RIDGE
SE
SE
S50
927
660
660
660