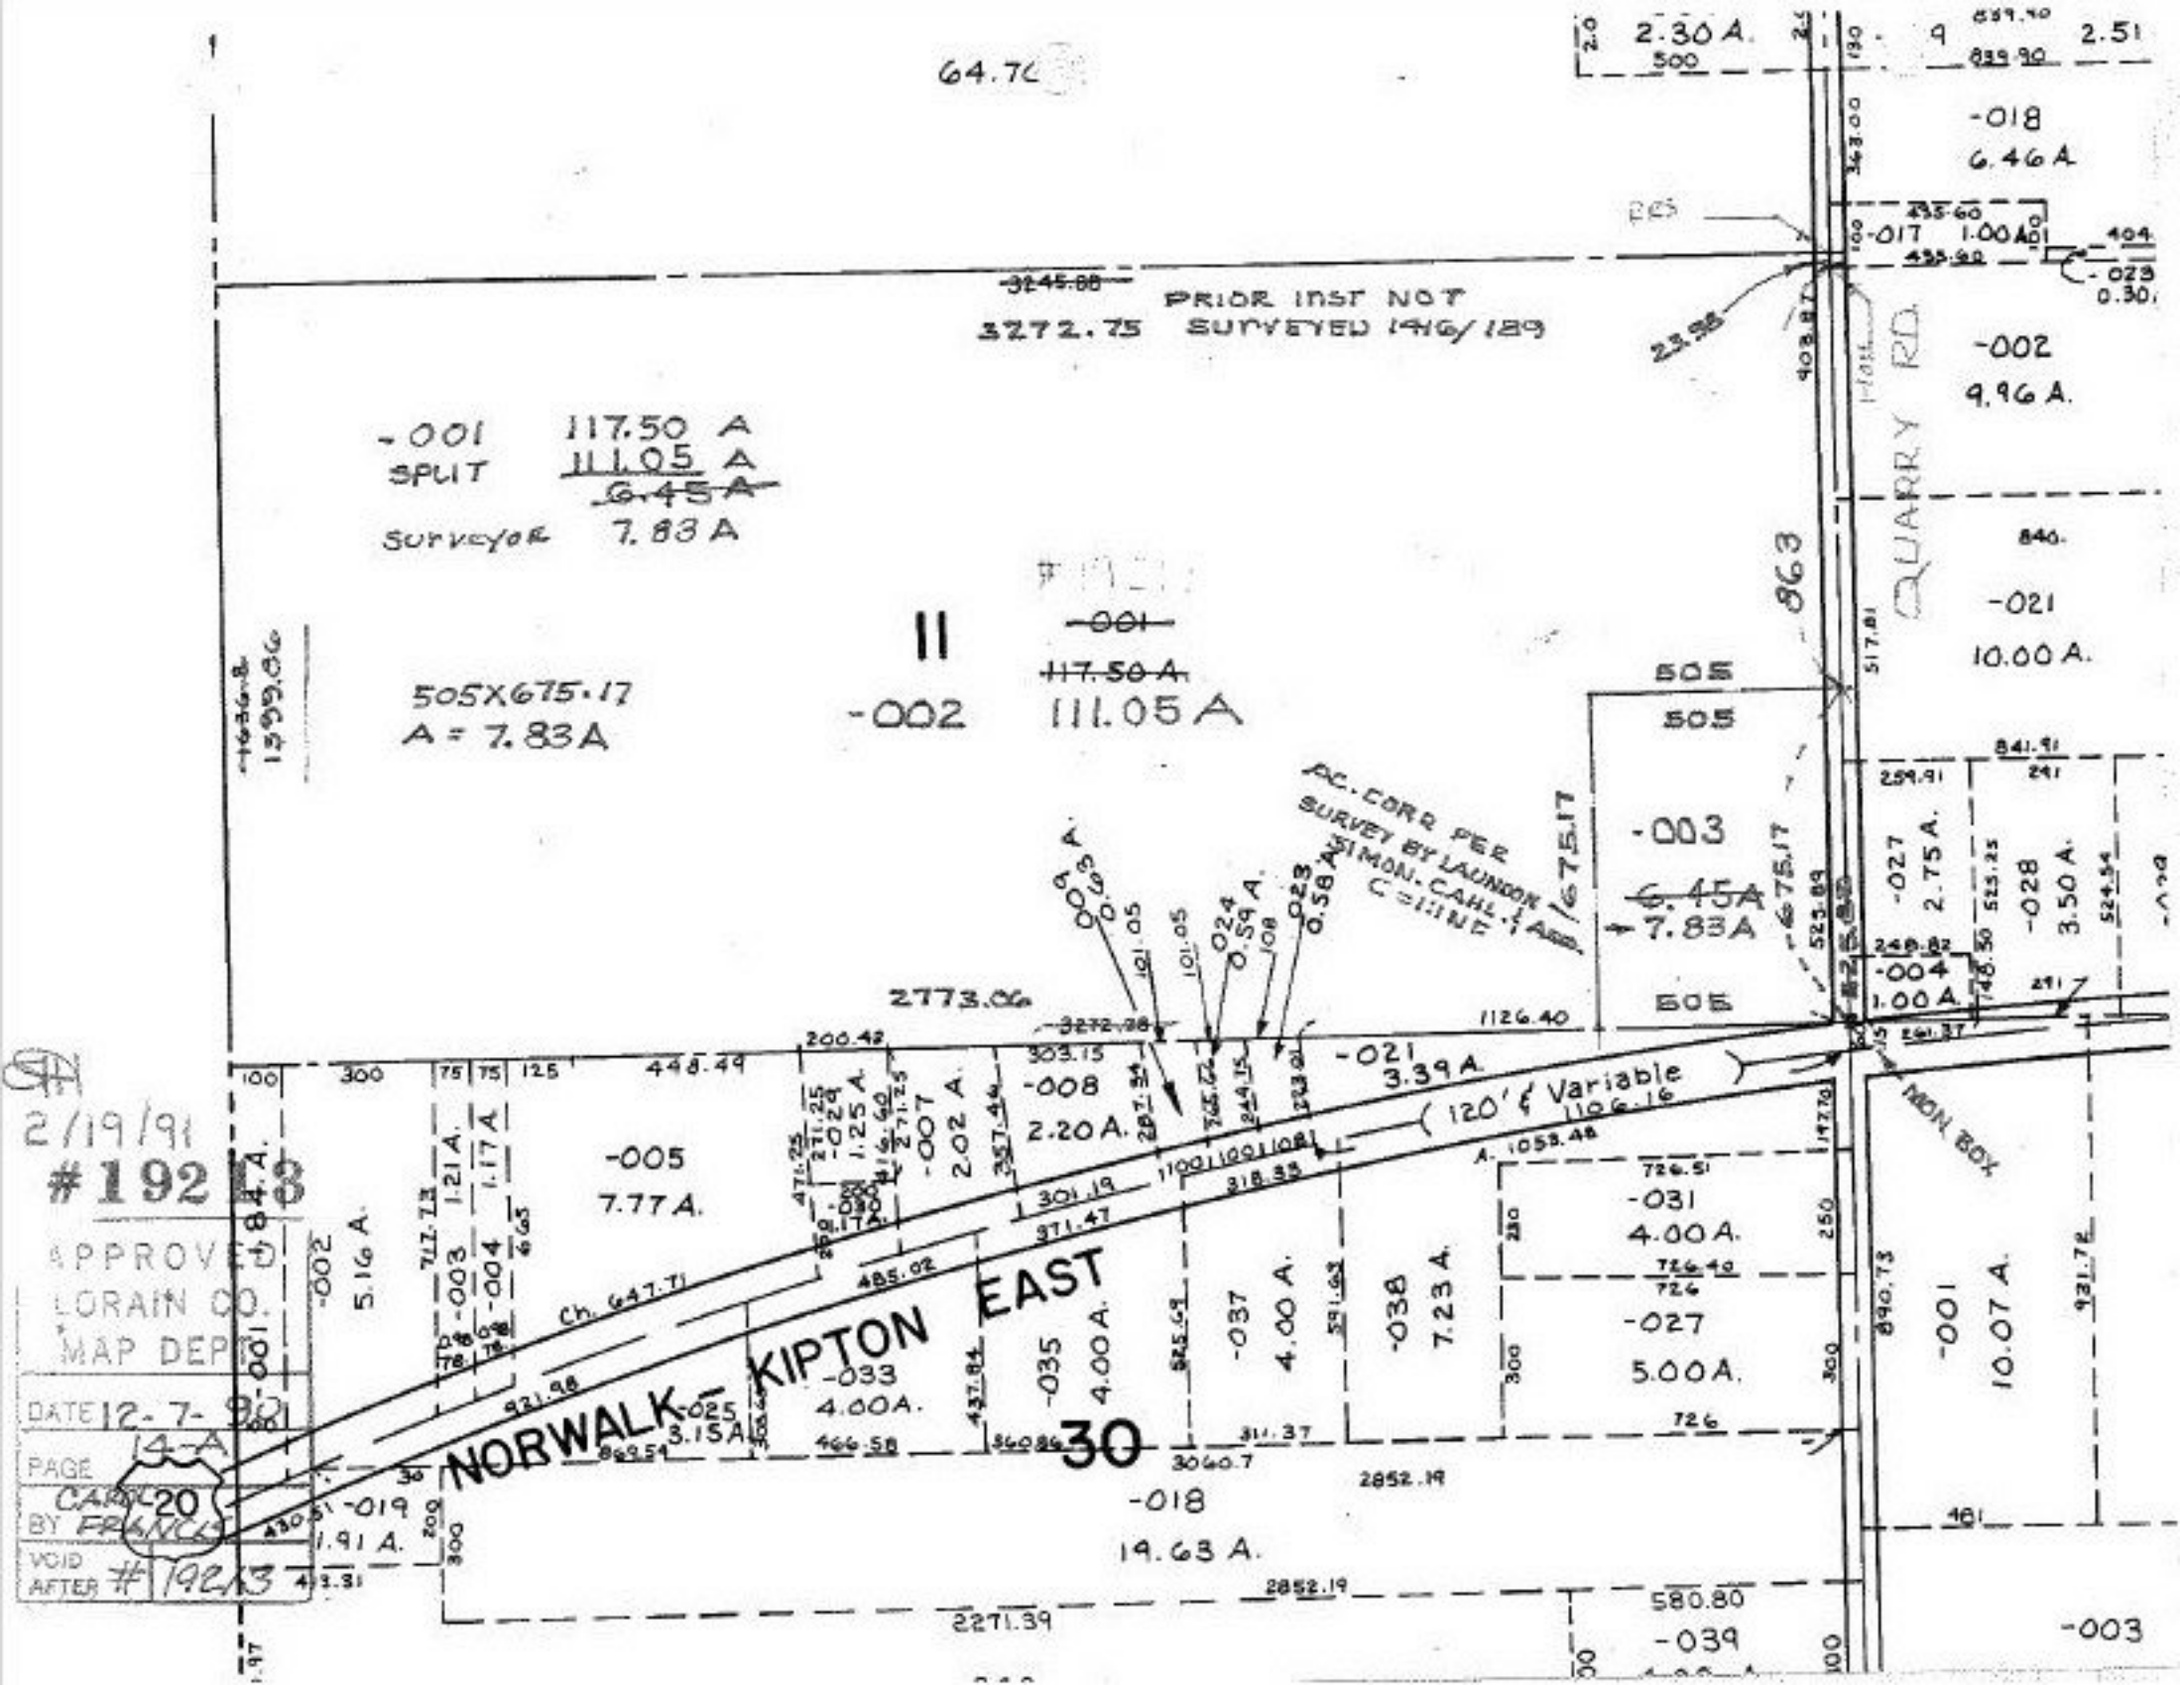
64.70
2.30 A.
2.51
-018
6.46 A.
-017 1.00 A.
-023 0.30
PRIOR INST NOT SURVEYED
3272.75
1416/189
-002
9.96 A.
QUARRY RD.
-001
SPLIT
117.50 A
111.05 A
6.45 A
SURVEYOR 7.83 A
505X675.17
A = 7.83A
11
-001
117.50 A
-002 111.05 A
-021
10.00 A.
505
-003
6.45 A
7.83 A
-027 2.75 A.
-028 3.50 A.
-004 1.00 A.
AC. CORR PER SURVEY BY LAUNDON SIMON-CAHL-LAMB
2773.06
-021
3.39 A.
120' & Variable
-005
7.77 A.
-008
2.20 A.
-007 2.02 A.
-024 1.25 A.
-025 3.15 A.
-033 4.00 A.
-035 4.00 A.
-037 4.00 A.
-038 7.23 A.
-031 4.00 A.
-027 5.00 A.
-001 10.07 A.
-003
NORWALK-KIPTON EAST
30
-018
19.68 A.
-039
-002 5.16 A.
-003 1.21 A.
-004 1.17 A.
-019 1.91 A.
MON. BOX
2271.39
2852.19
3040.7
Ch. 647.71
2/19/91
#192 83
APPROVED
LORAIN CO.
MAP DEPT.
DATE 12-7-90
PAGE 14-A
CARD 20
BY FRANCK
VOID AFTER #192 93