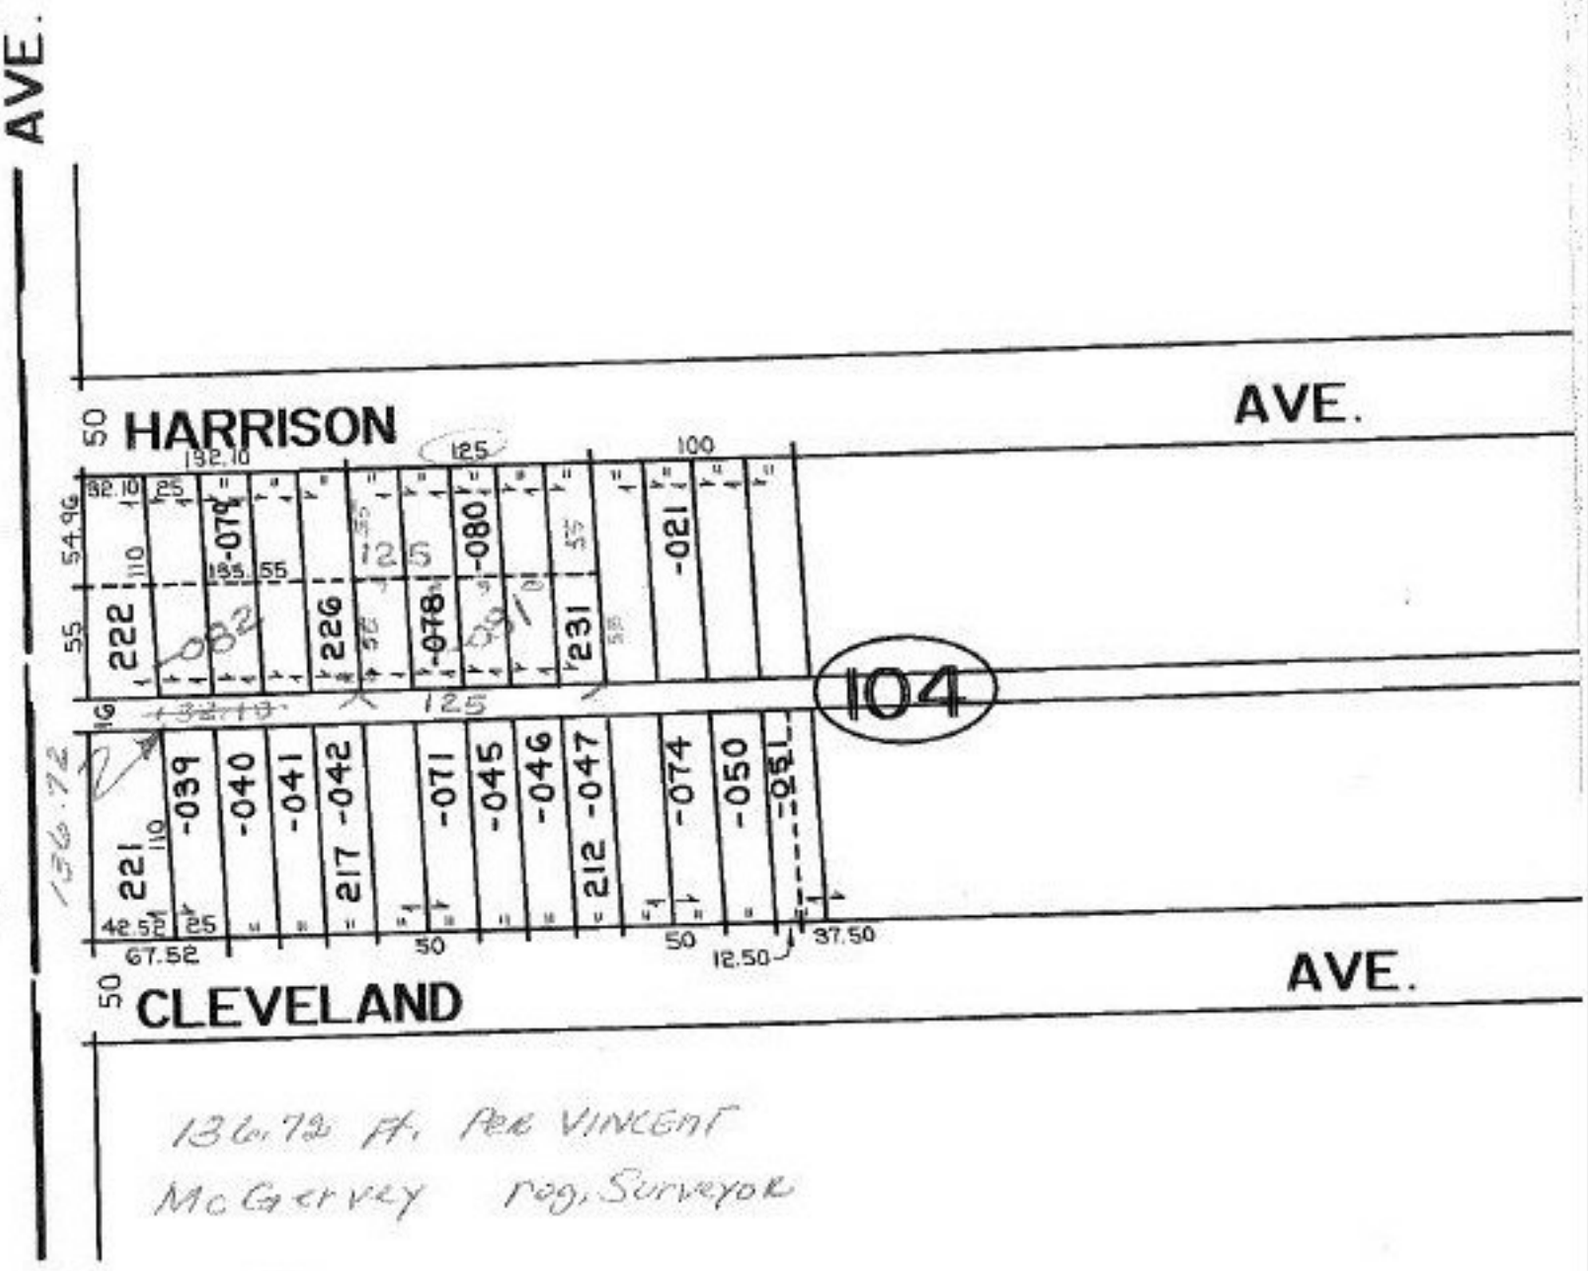

136.72 Ft. Per VINCENT McGERVEY Reg. Surveyor

257.10
125.00
132.10

03-00-109-104- PRIOR INST. 296/213
SURVEYED BY: VINCENT C. McGERVEY
REG. SURVEYOR

11/11/91
#19216
APPROVED
DRAIN CO.
MAP DEPT.
12-10-90
3-00-109A
CARDOT
FRANCIS
#192-16