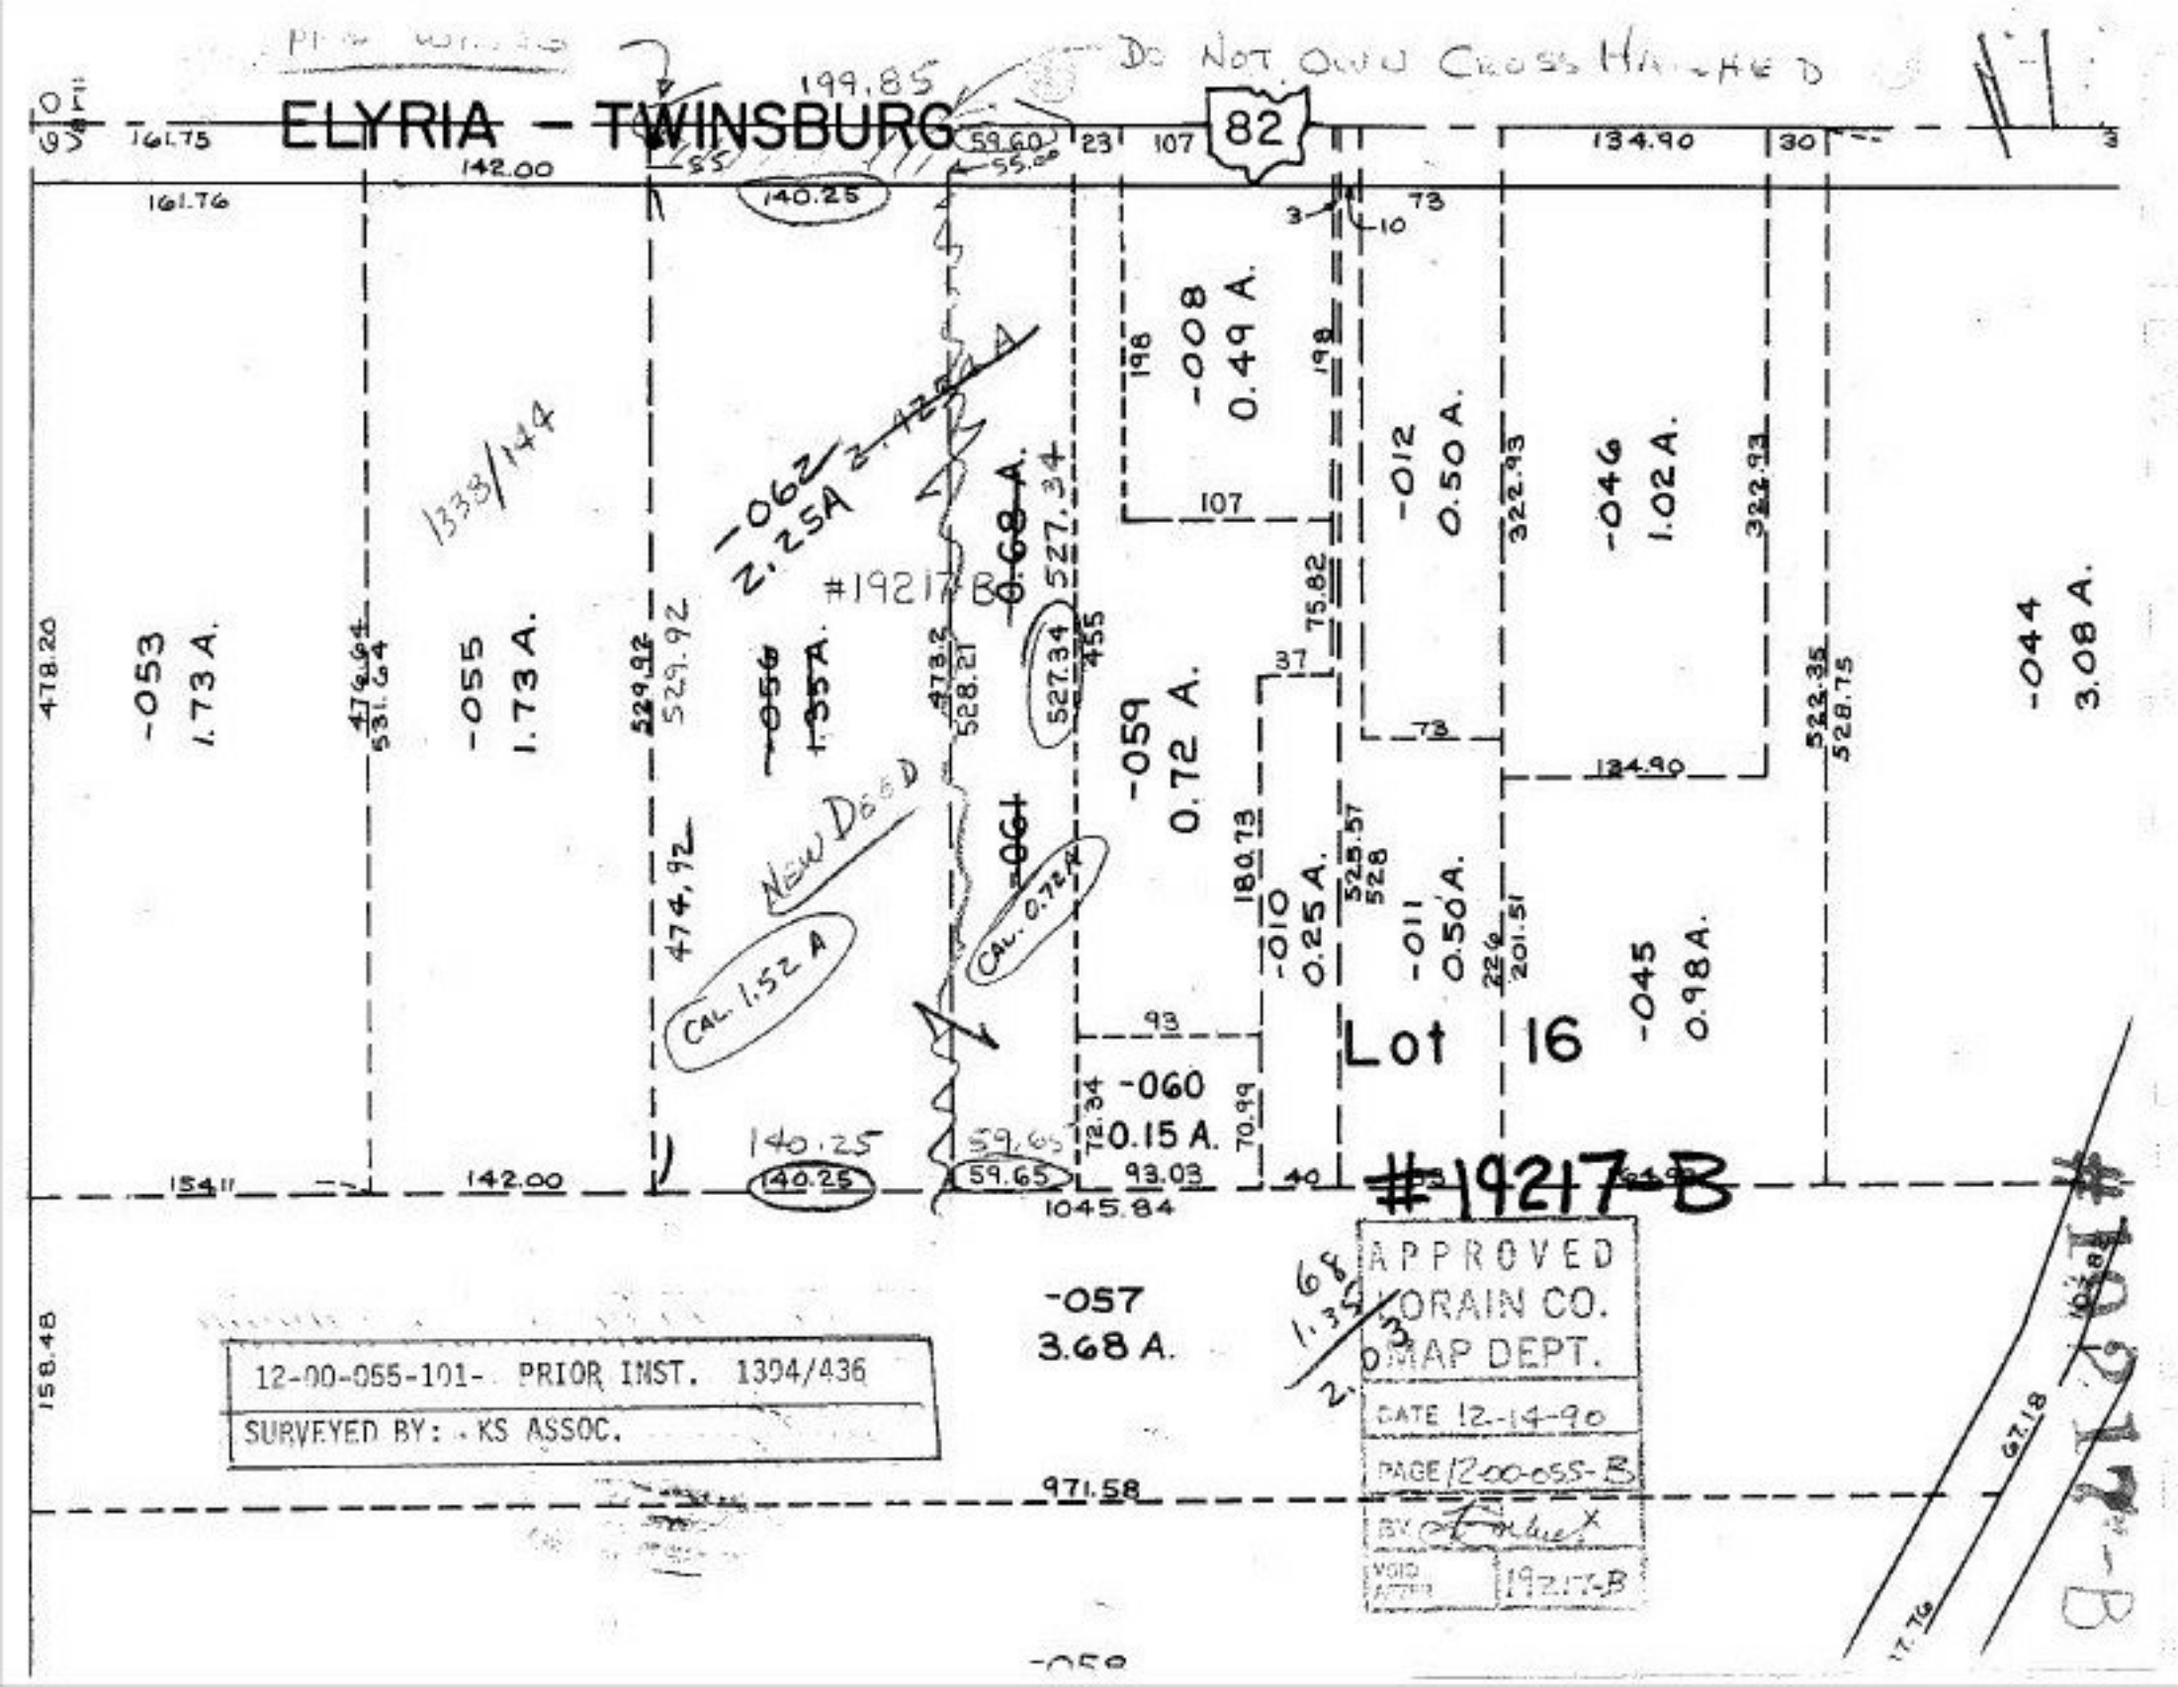
ELYRIA - TWINSBURG
82
DO NOT OWN CROSS HATCHED
199.85
161.75
142.00
161.76
140.25
59.60
55.00
23
107
134.90
30
-008
0.49 A.
198
107
-012
0.50 A.
322.93
-046
1.02 A.
322.93
-044
3.08 A.
-053
1.73 A.
-055
1.73 A.
-062
2.25A
1338/144
#19217-B
0.68 A.
527.34
-059
0.72 A.
75.82
37
73
134.90
-061
CAL. 0.72 A
NEW DEED
474.92
CAL. 1.52 A
-010
0.25 A.
180.73
-011
0.50 A.
-045
0.98 A.
Lot 16
93
-060
0.15 A.
72.34
70.99
140.25
59.65
93.03
40
154.11
142.00
1045.84
#19217-B
-057
3.68 A.
68
1.35
2.03
971.58
67.18
17.76
-058
12-00-055-101- PRIOR INST. 1394/436
SURVEYED BY: KS ASSOC.
APPROVED
LORAIN CO.
MAP DEPT.
DATE 12-14-90
PAGE 12-00-055-B
BY
VOID AFTER
19217-B
#19217-B