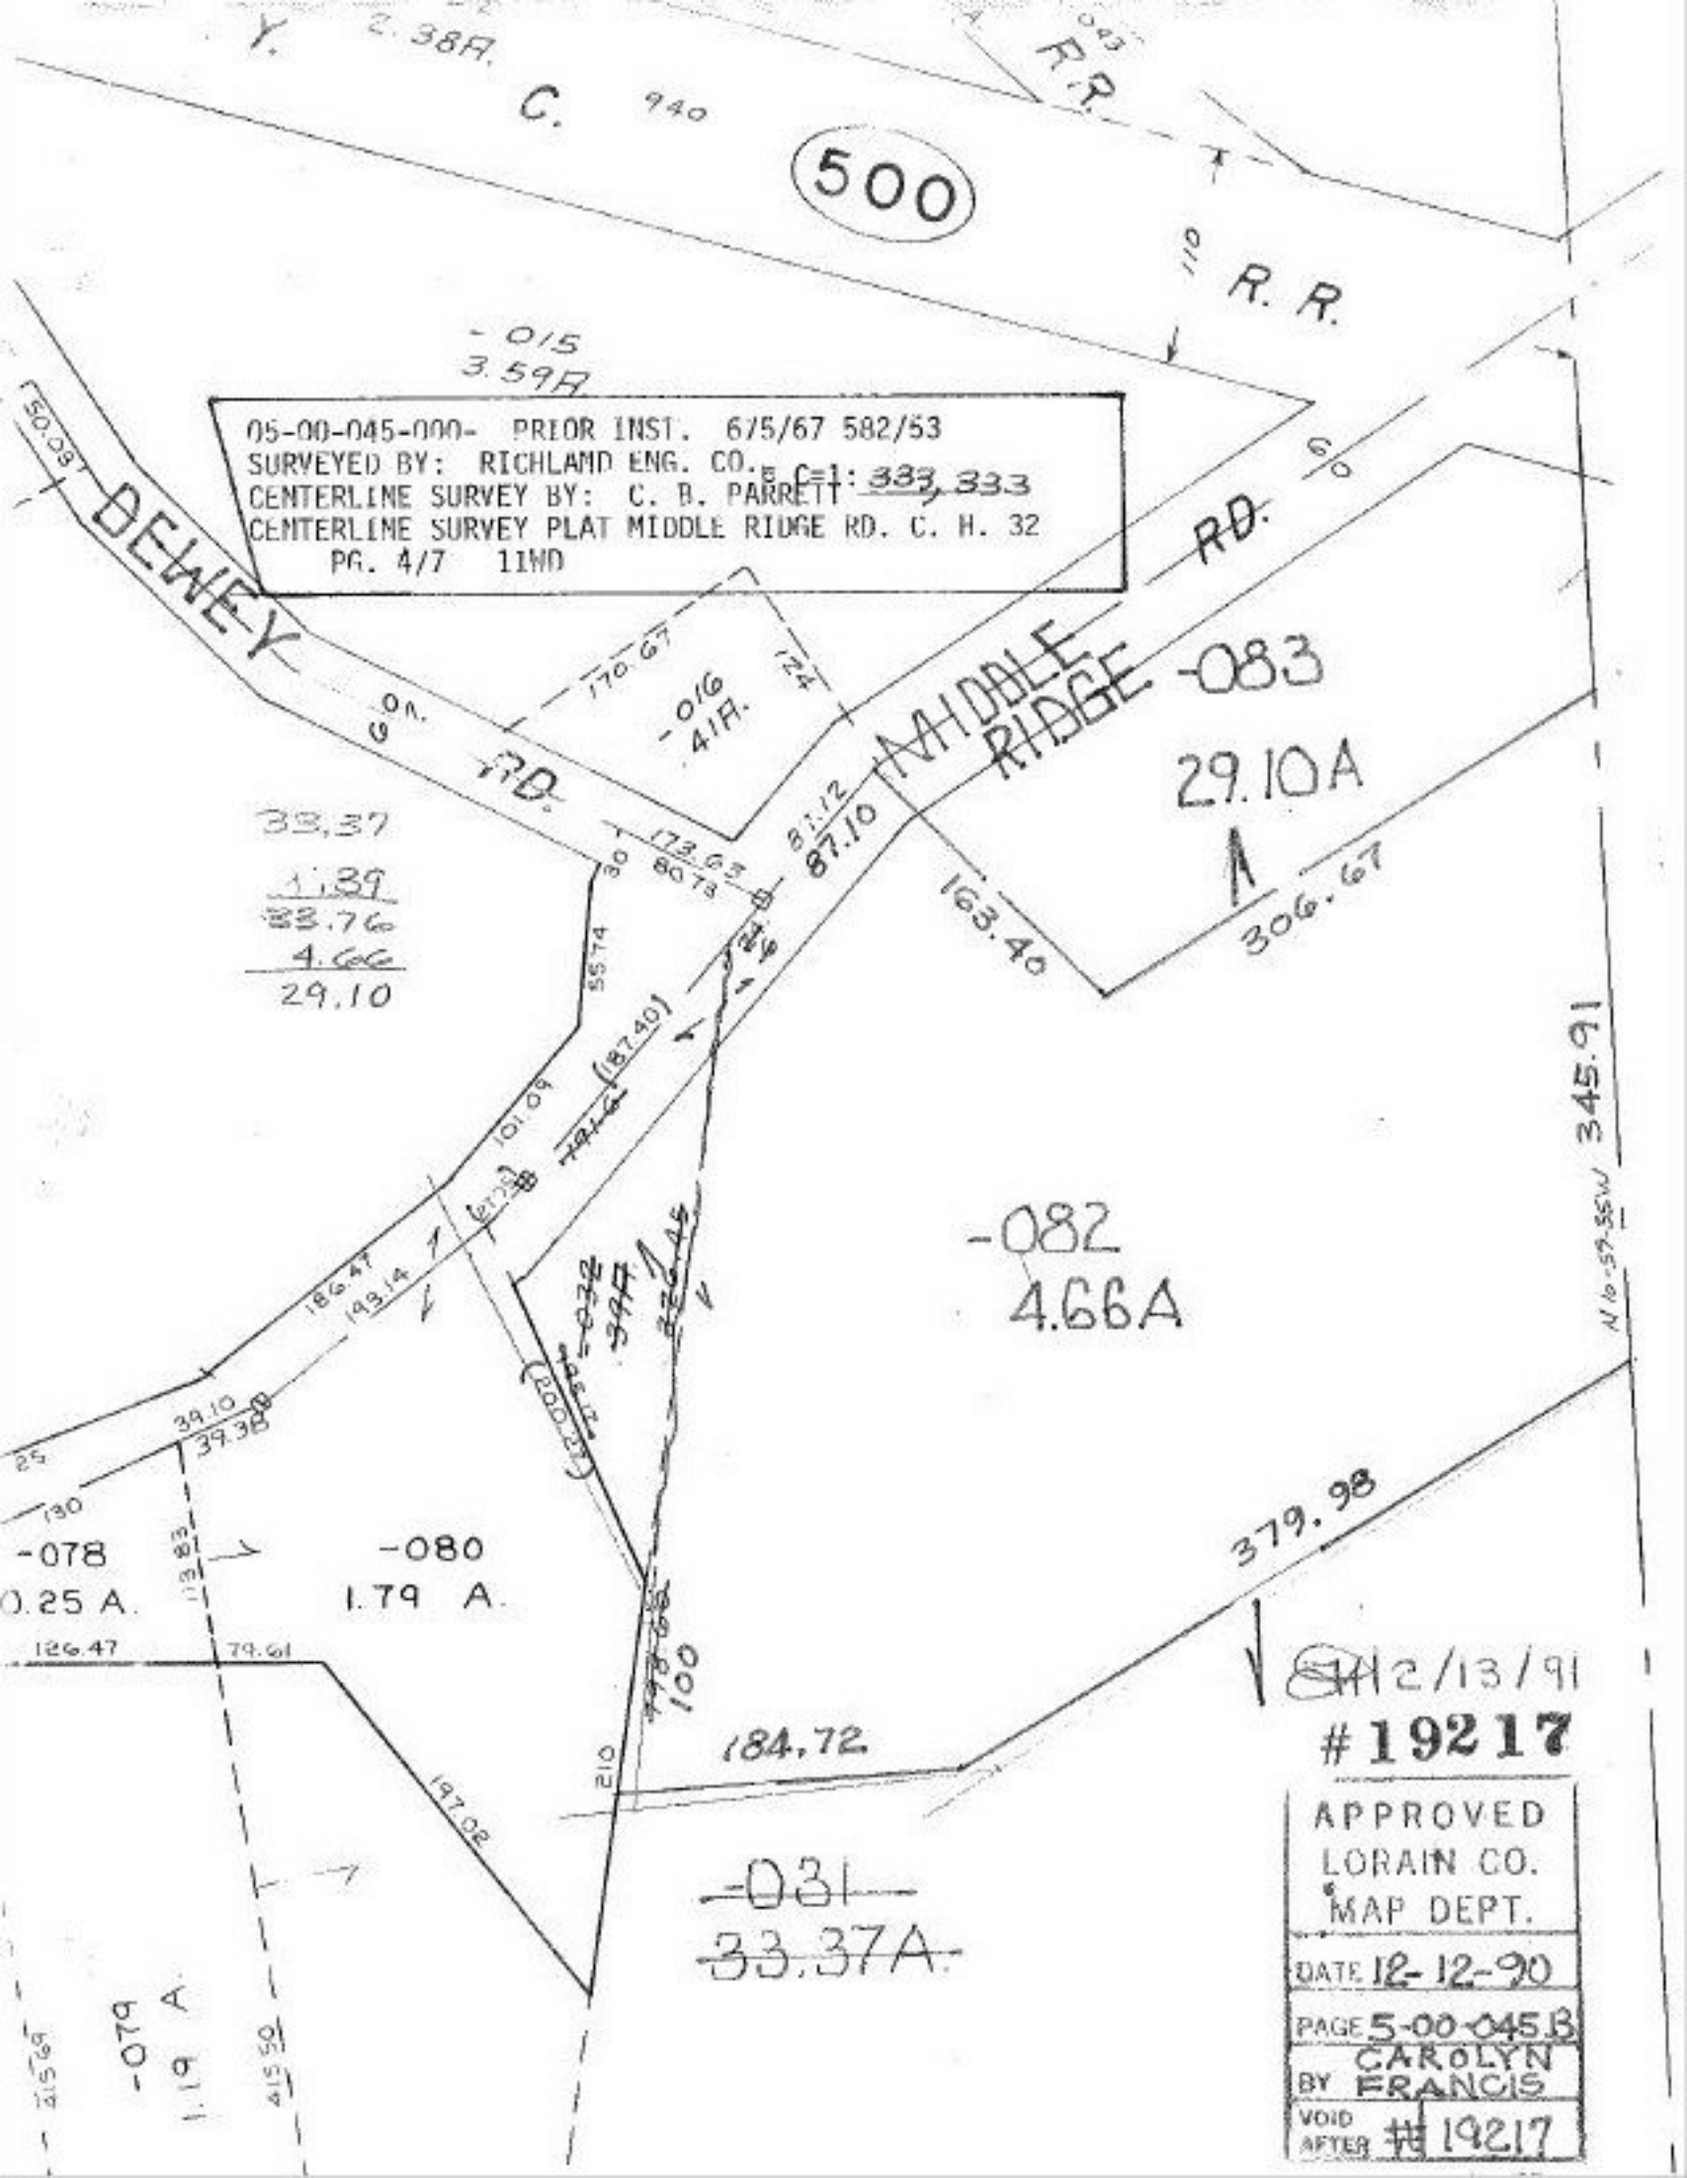

12/13/91

#19217

APPROVED
LORAIN CO.
MAP DEPT.

DATE 12-12-90

PAGE 5-00-045 B

BY CAROLYN FRANCIS

VOID AFTER # 19217