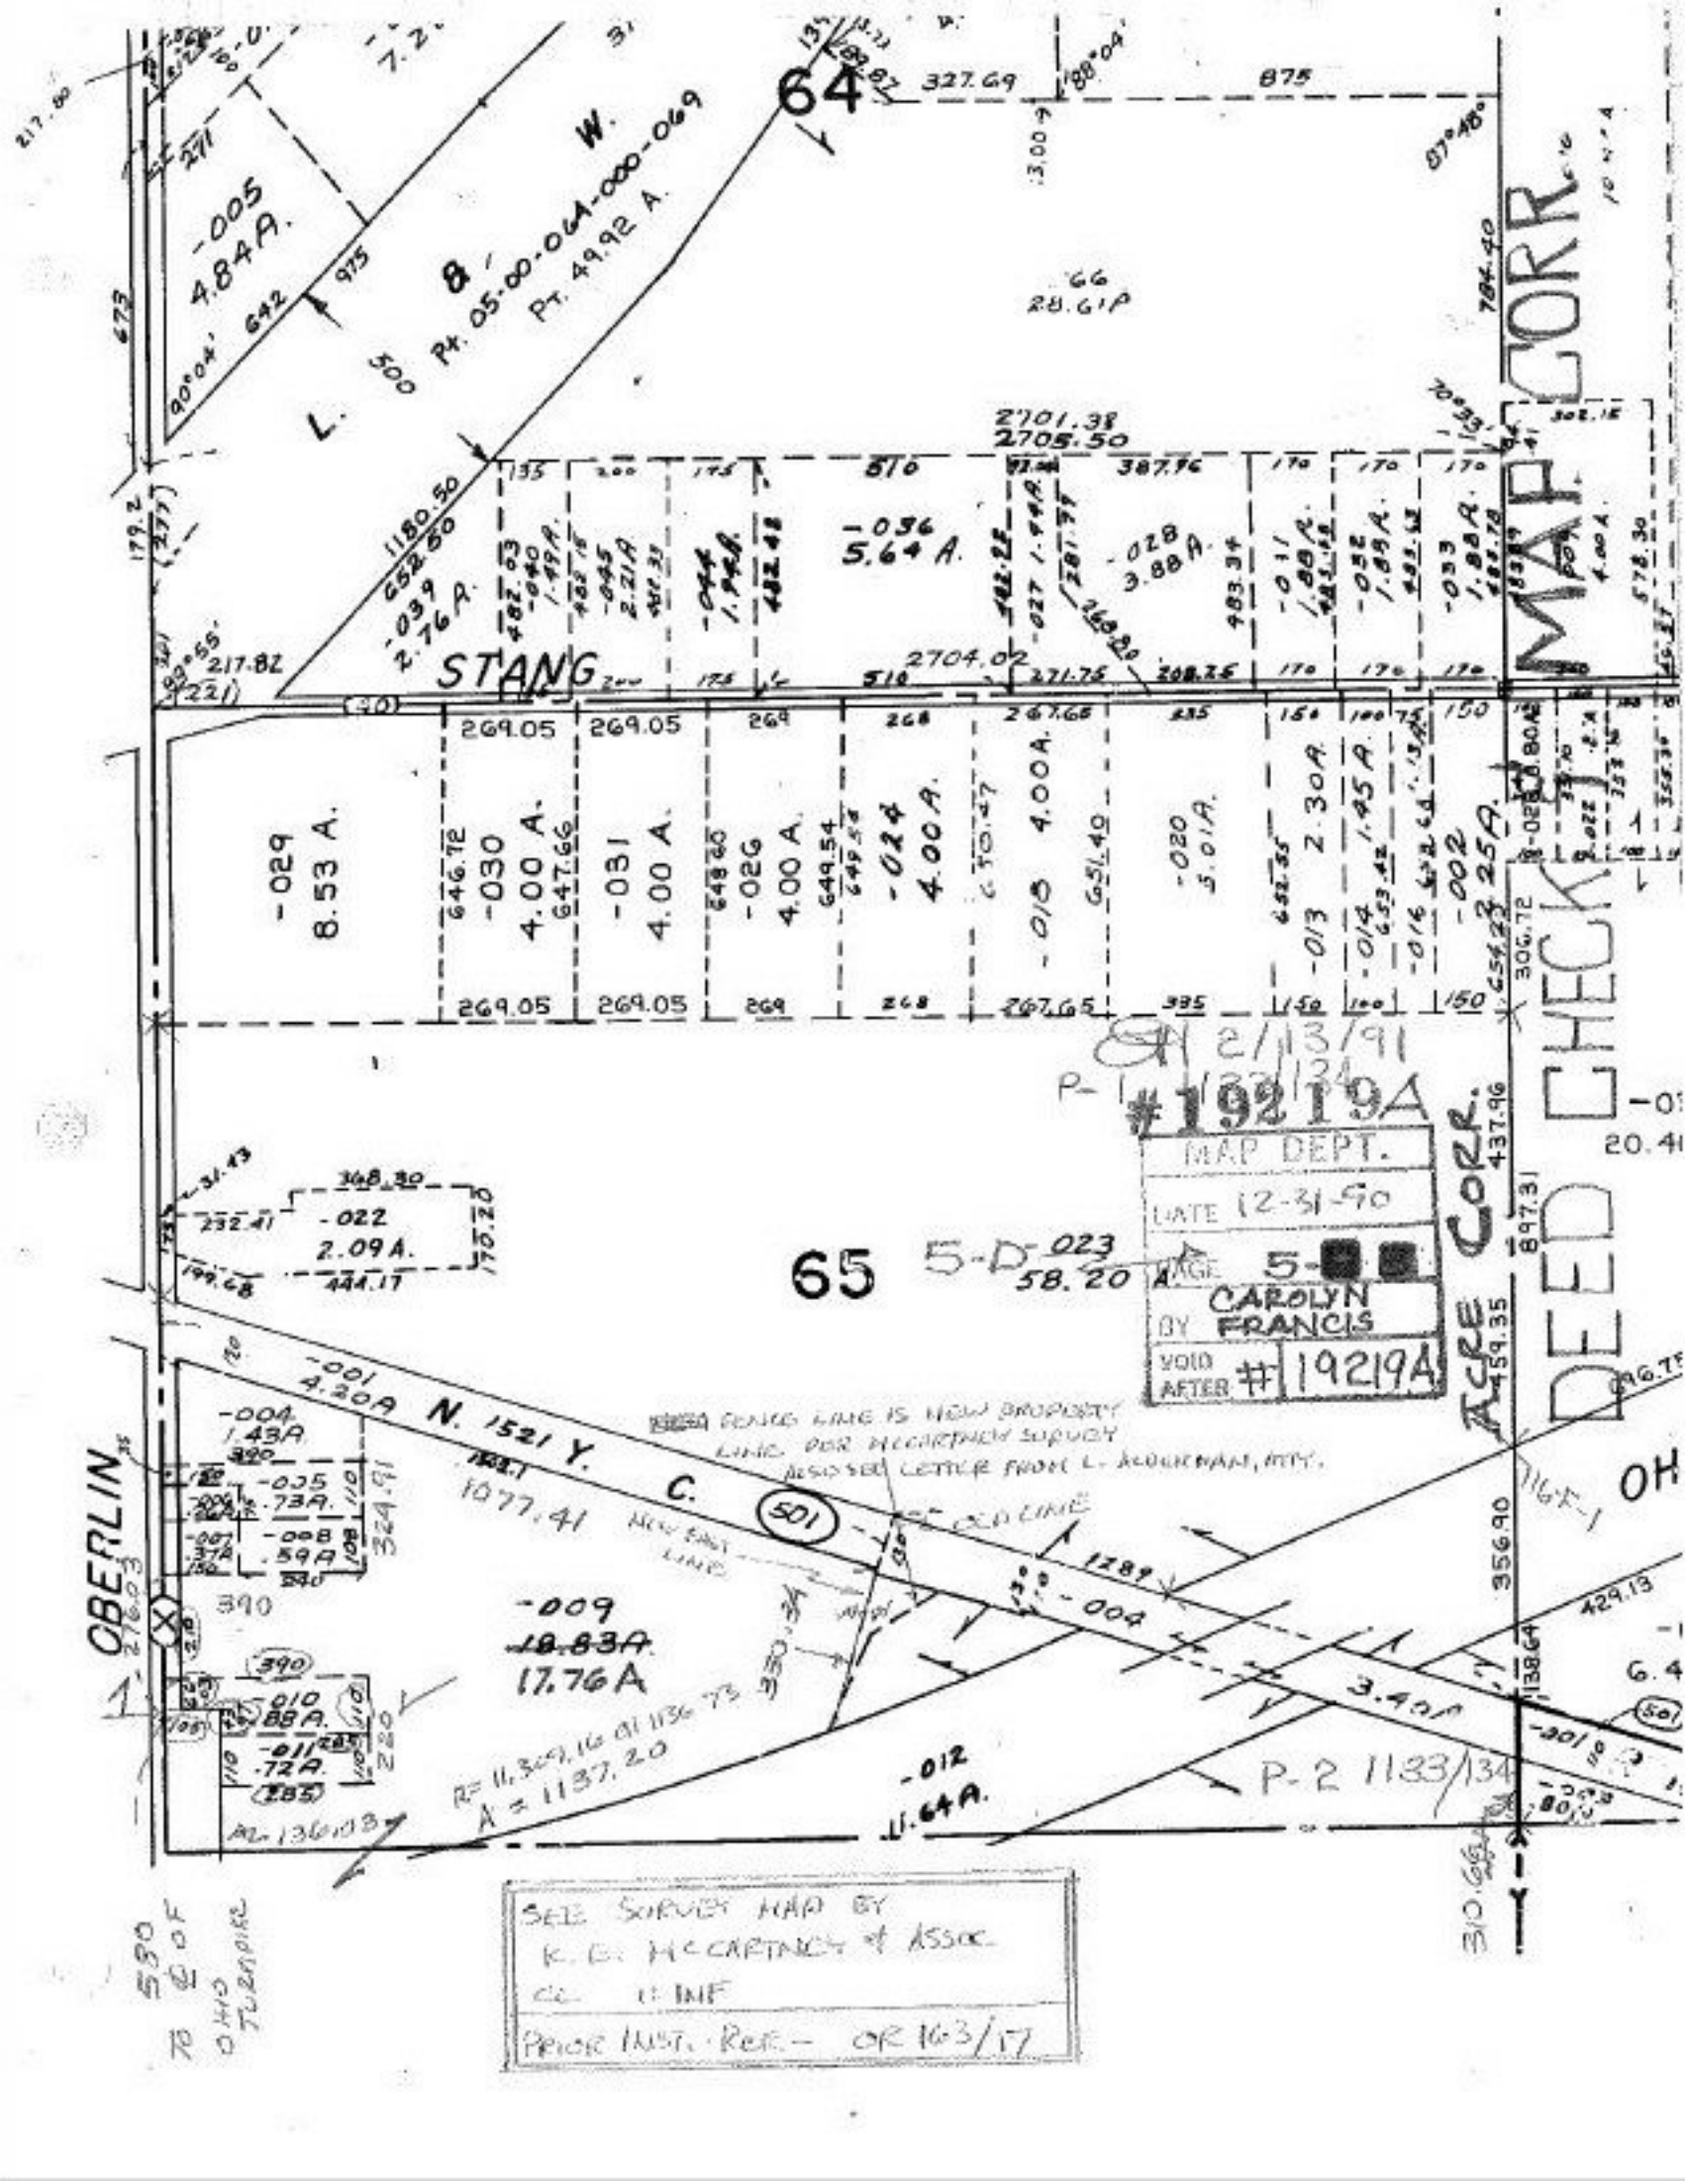
64
65
STANG
MAP CORR.
DEED CHECK
-005 4.84A.
-029 8.53 A.
-030 4.00 A.
-031 4.00 A.
-026 4.00 A.
-024 4.00A.
-013 4.00A.
-020 5.01A.
-014 1.45A.
-002 2.25A.
-022 2.09A.
-001 4.20A
-004 1.43A
-035 .73A.
-008 .59A
-009 18.83A 17.76A
-010 .88A.
-011 .72A.
-012 1.64A.
-028 3.88A.
-027 1.94A.
-039 2.76A.
-040 1.49A.
-045 2.21A.
-046 1.94A.
-033 1.88A.
-032 1.88A.
-011 1.88A.
-036 5.64 A.
N. 152 1/2 Y.
OBERLIN
MAP DEPT.
DATE 12-31-90
PAGE 5-
BY CAROLYN FRANCIS
VOID AFTER #19219A
#19219A
2/13/91
P-1 1133/134
P-2 1133/134
5-D-023
58.20
FENCE LINE IS NOW PROPERTY LINE PER MCCARTNEY SURVEY ALSO SEE LETTER FROM L. MCCORMAN, ATTY.
SEE SURVEY MAP BY K. E. MCCARTNEY & ASSOC.
PRIOR INST. REF. – OR 163/17