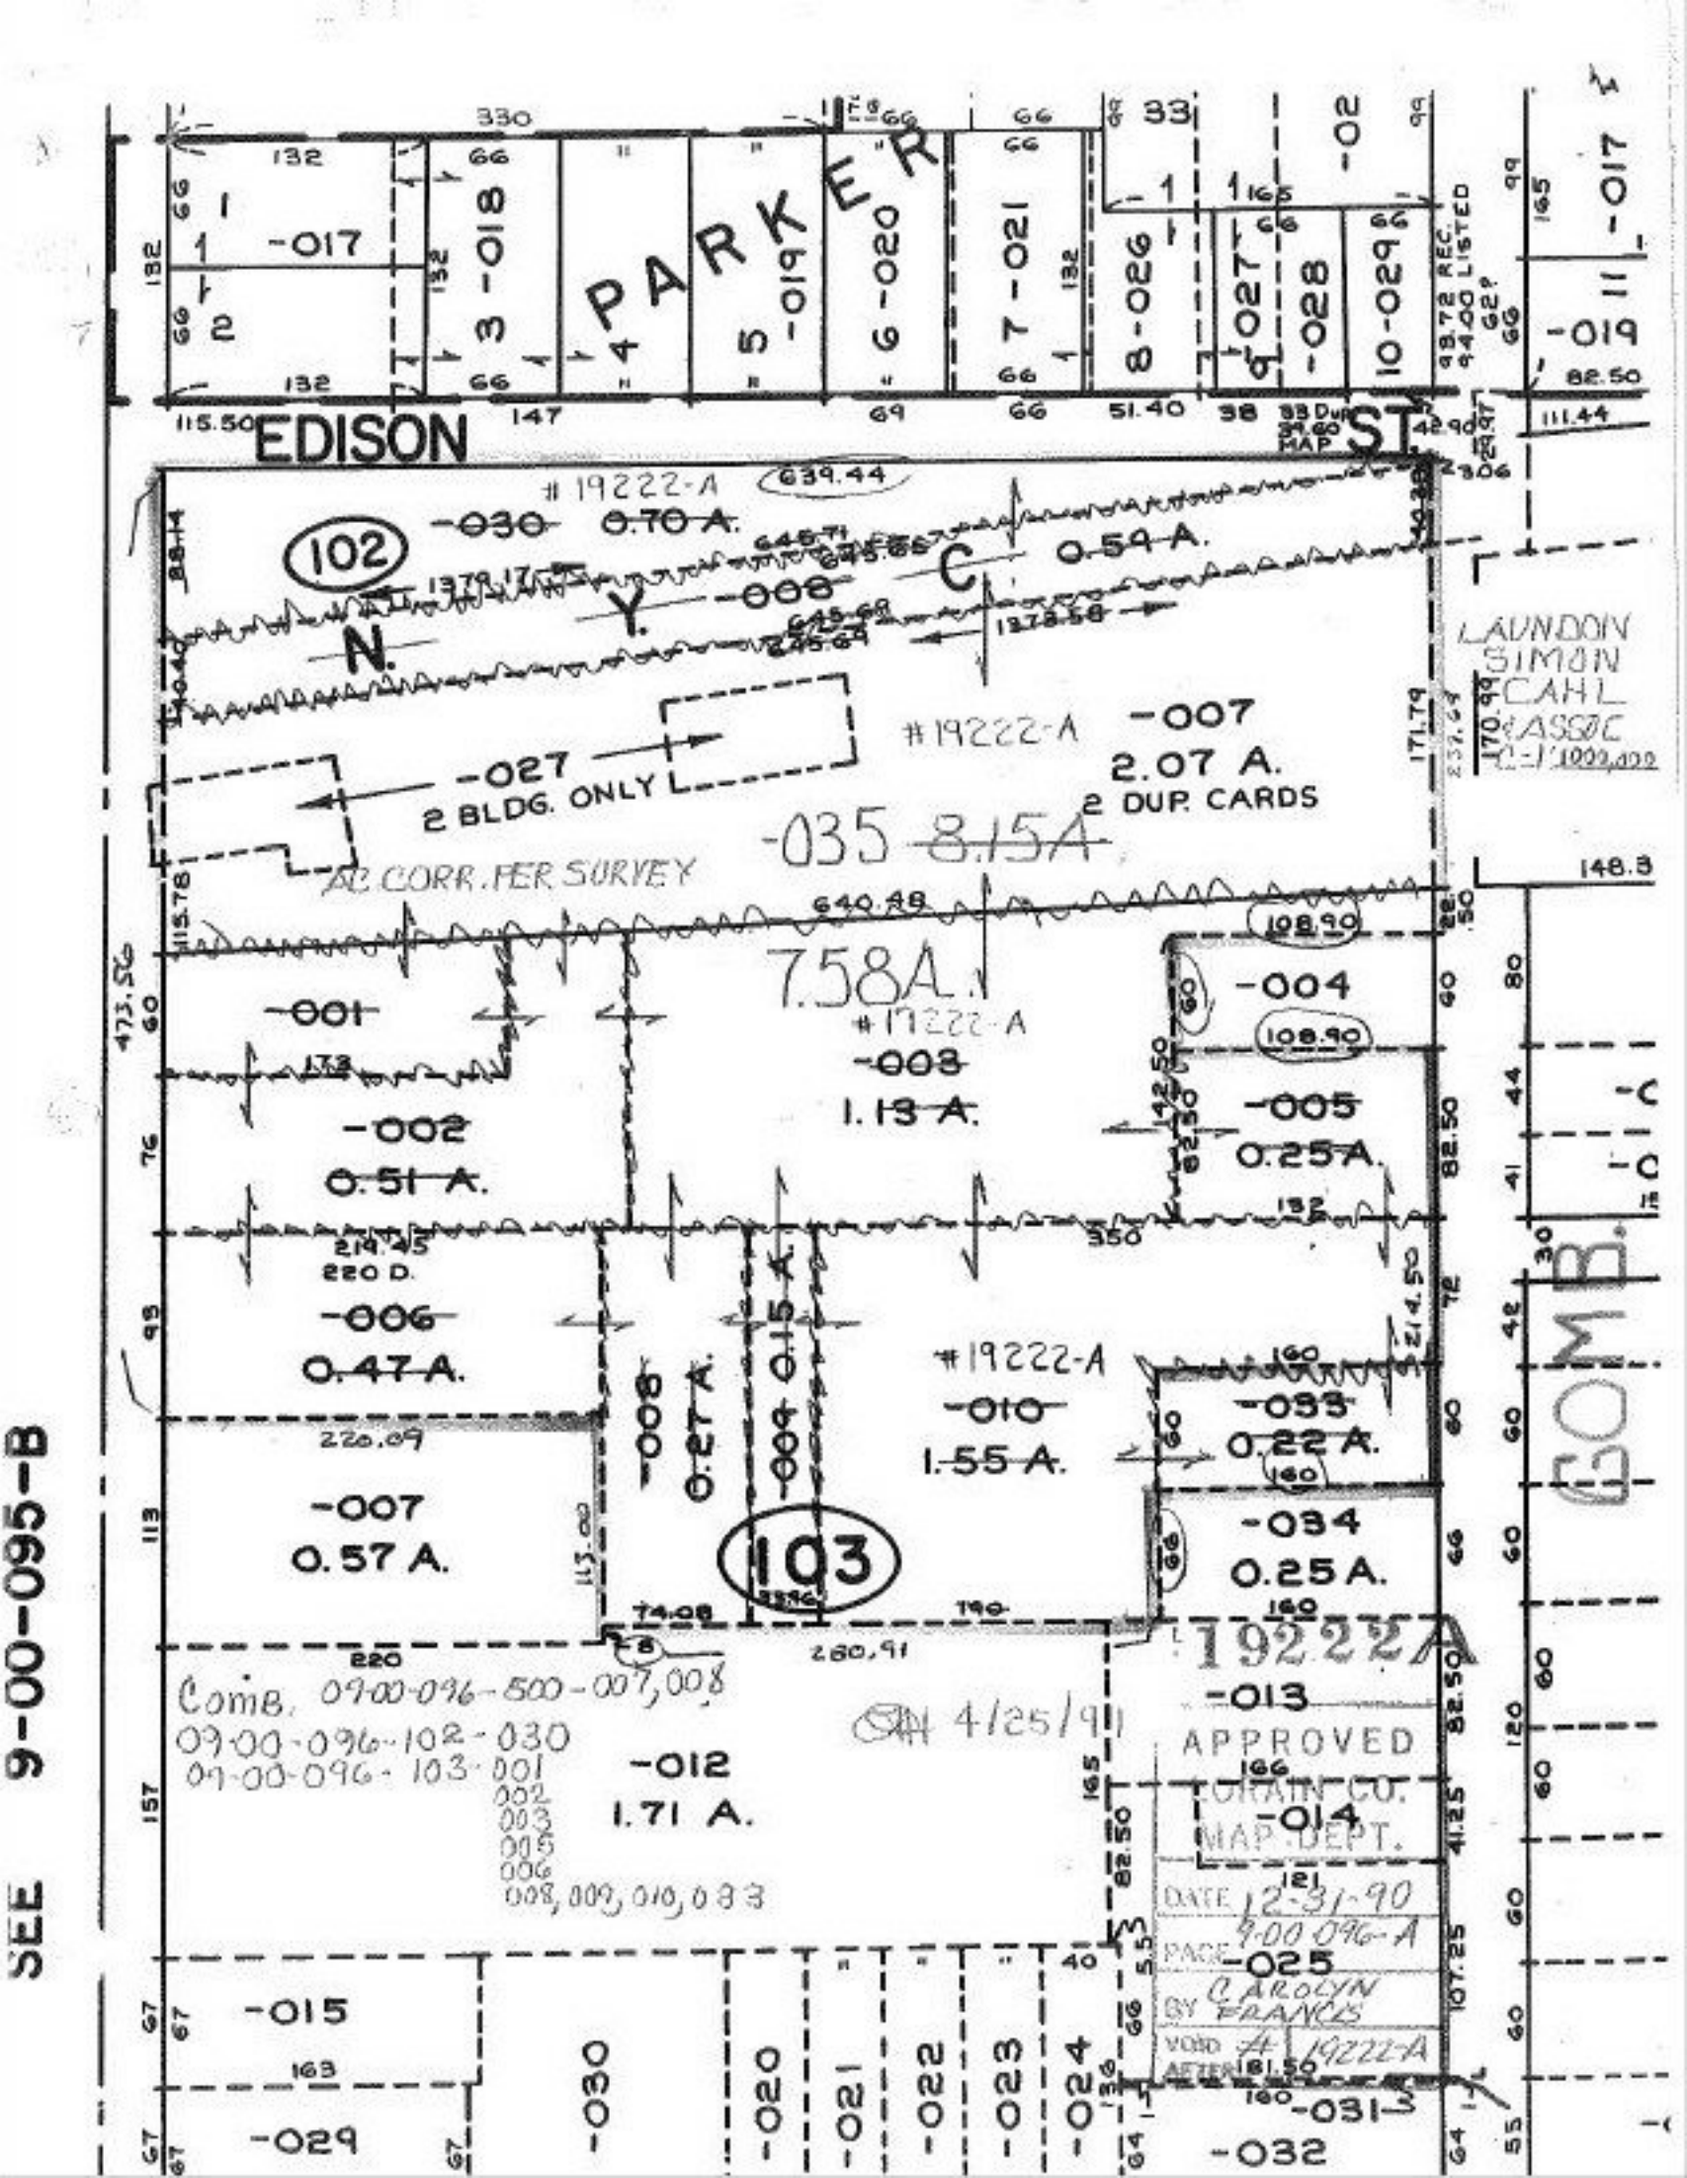

Comb. 09-00-096-500-007,008
09-00-096-102-030
09-00-096-103-001
002
003
005
006
008, 009, 010, 033

4/25/91