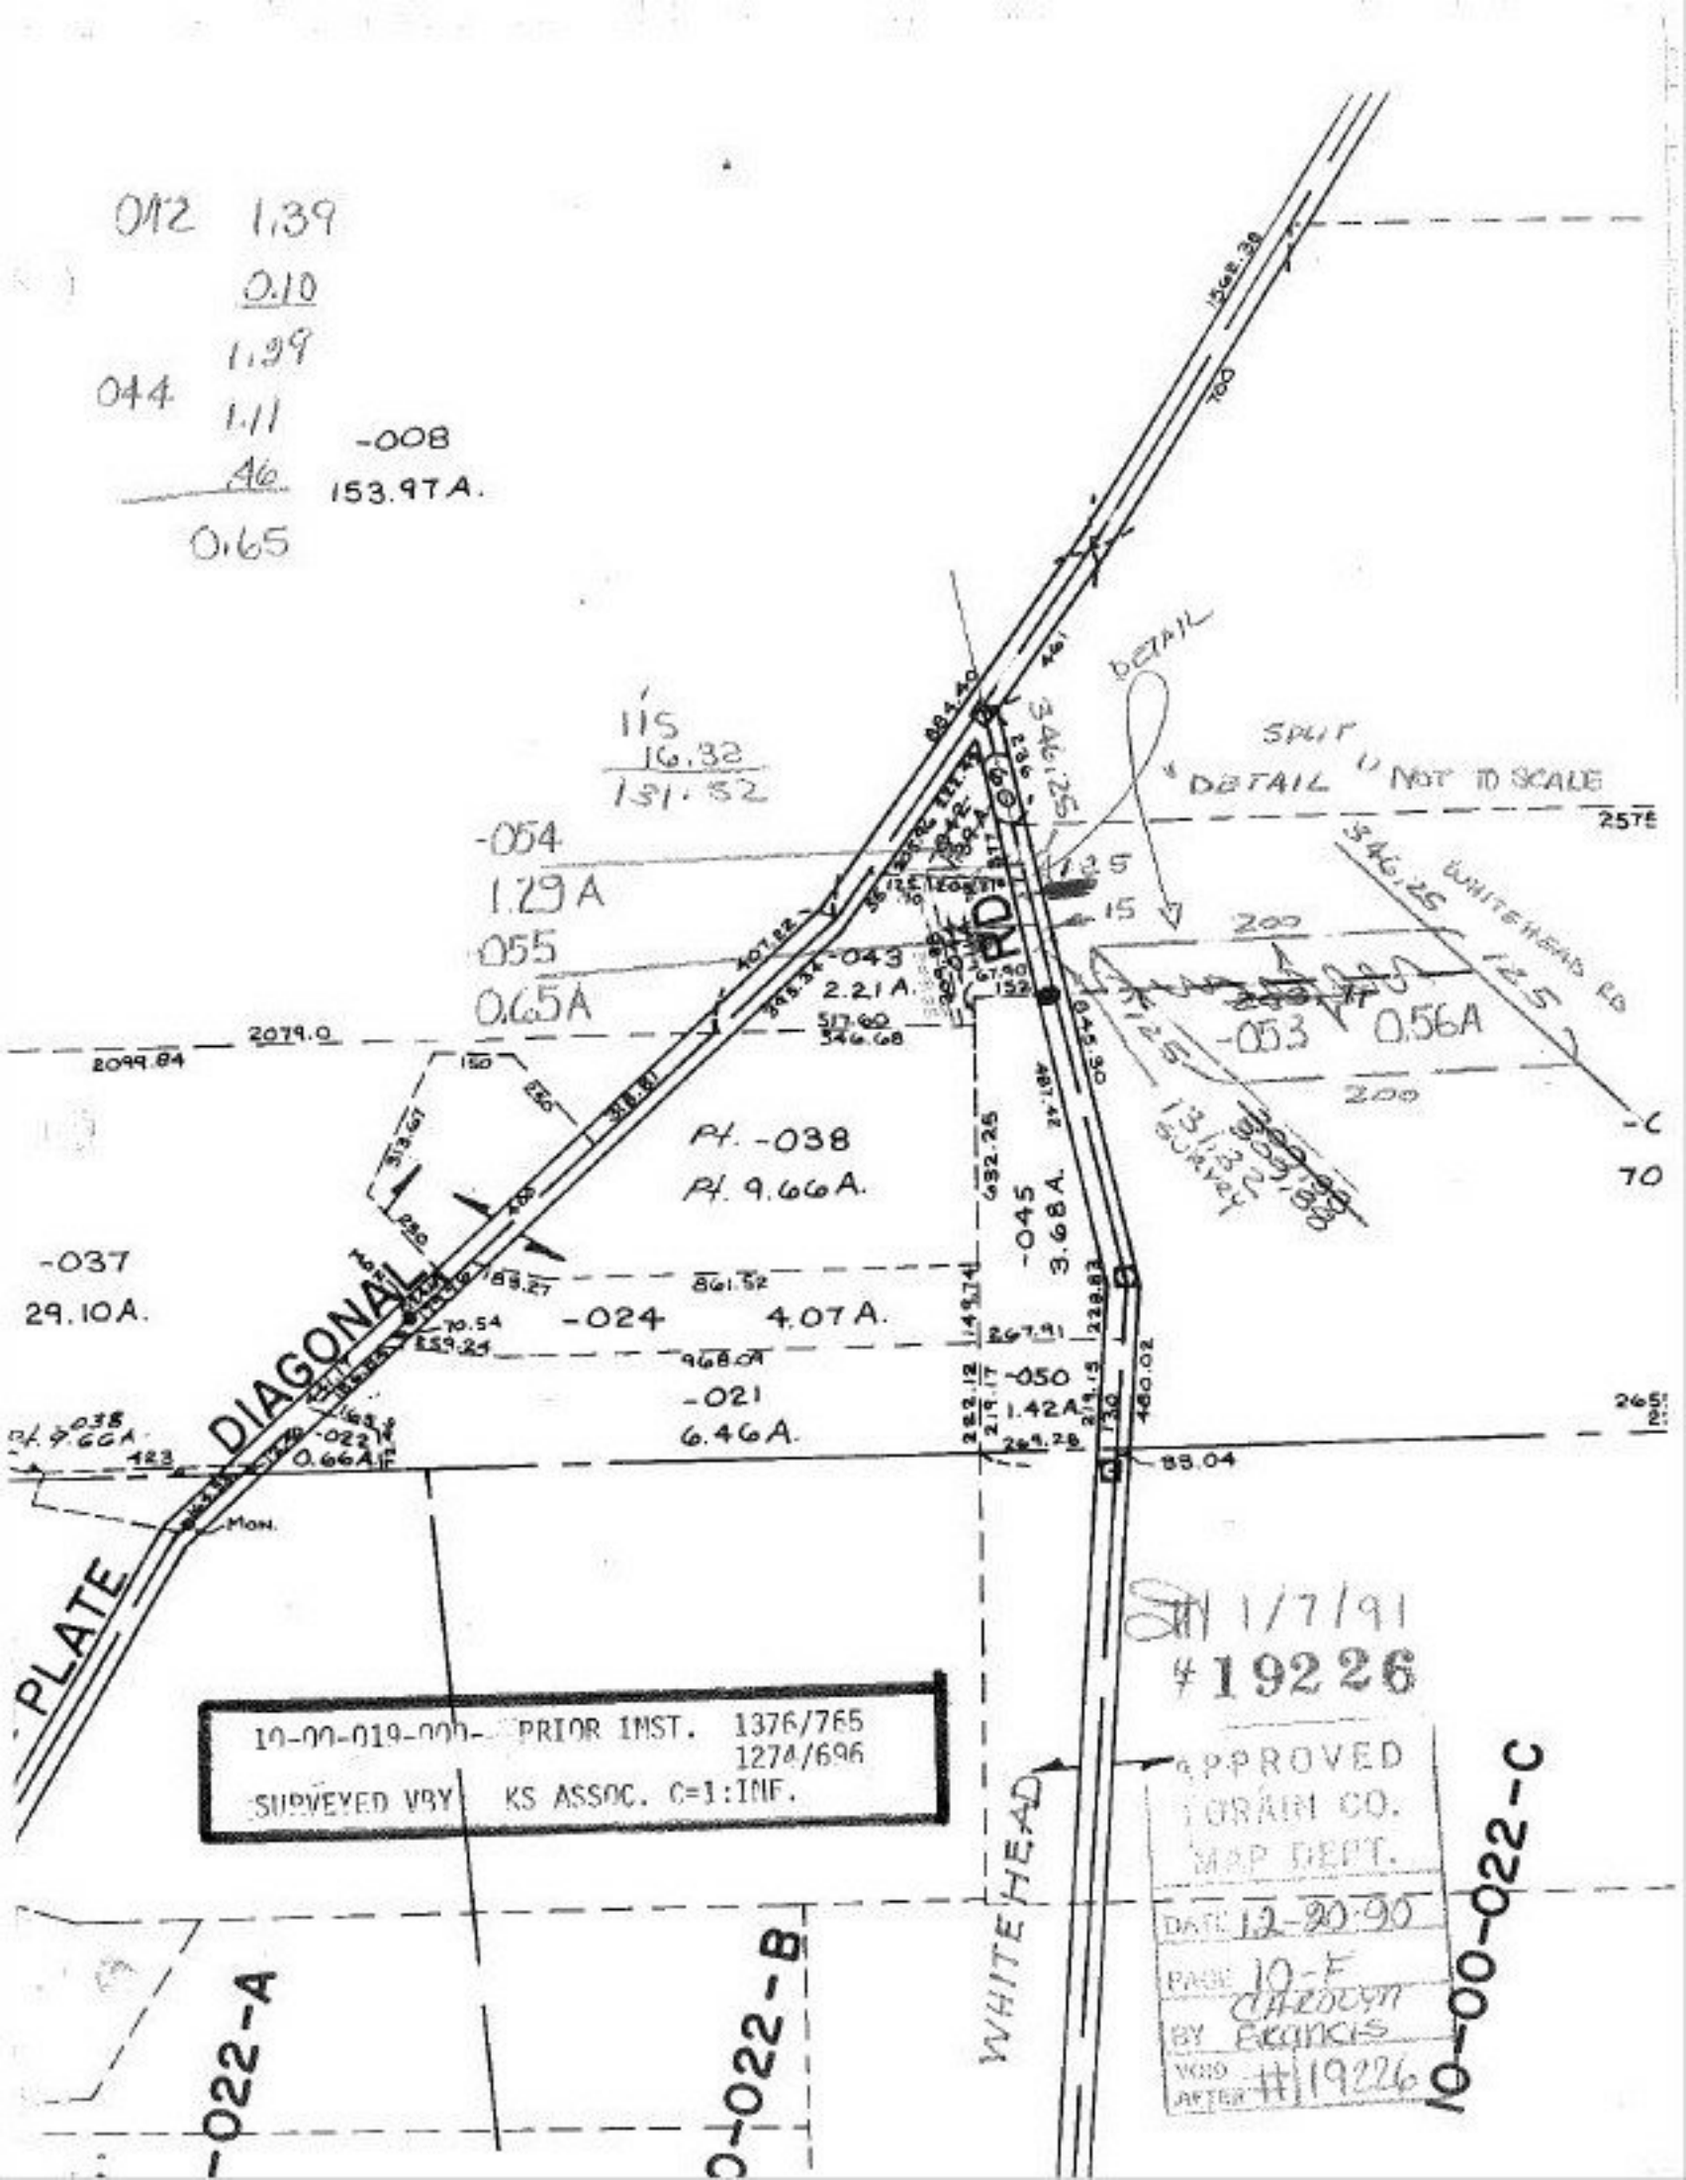
012 1.39
0.10
1.29
044 1.11
-008
46 153.97A.
0.65
115
16.32
131.52
-054
1.29A
055
0.65A
-043
2.21A.
DETAIL
SPLIT
" DETAIL " NOT TO SCALE
WHITEHEAD RD
-053 0.56A
Pt. -038
Pt. 9.66A.
-045
3.68A.
-037
29.10A.
-024 4.07A.
-021
6.46A.
-050
1.42A
Pt. 9.66A.
-022
0.66A±
MON.
PLATE DIAGONAL
WHITEHEAD
10-00-019-000- PRIOR INST. 1376/765
1274/696
SURVEYED VBY KS ASSOC. C=1:INF.
1/7/91
#19226
APPROVED
FORAIN CO.
MAP DEPT.
DATE 12-20-90
PAGE 10-E
BY Francis
NOTED AFTER #19226
10-00-022-C
10-00-022-B
10-00-022-A