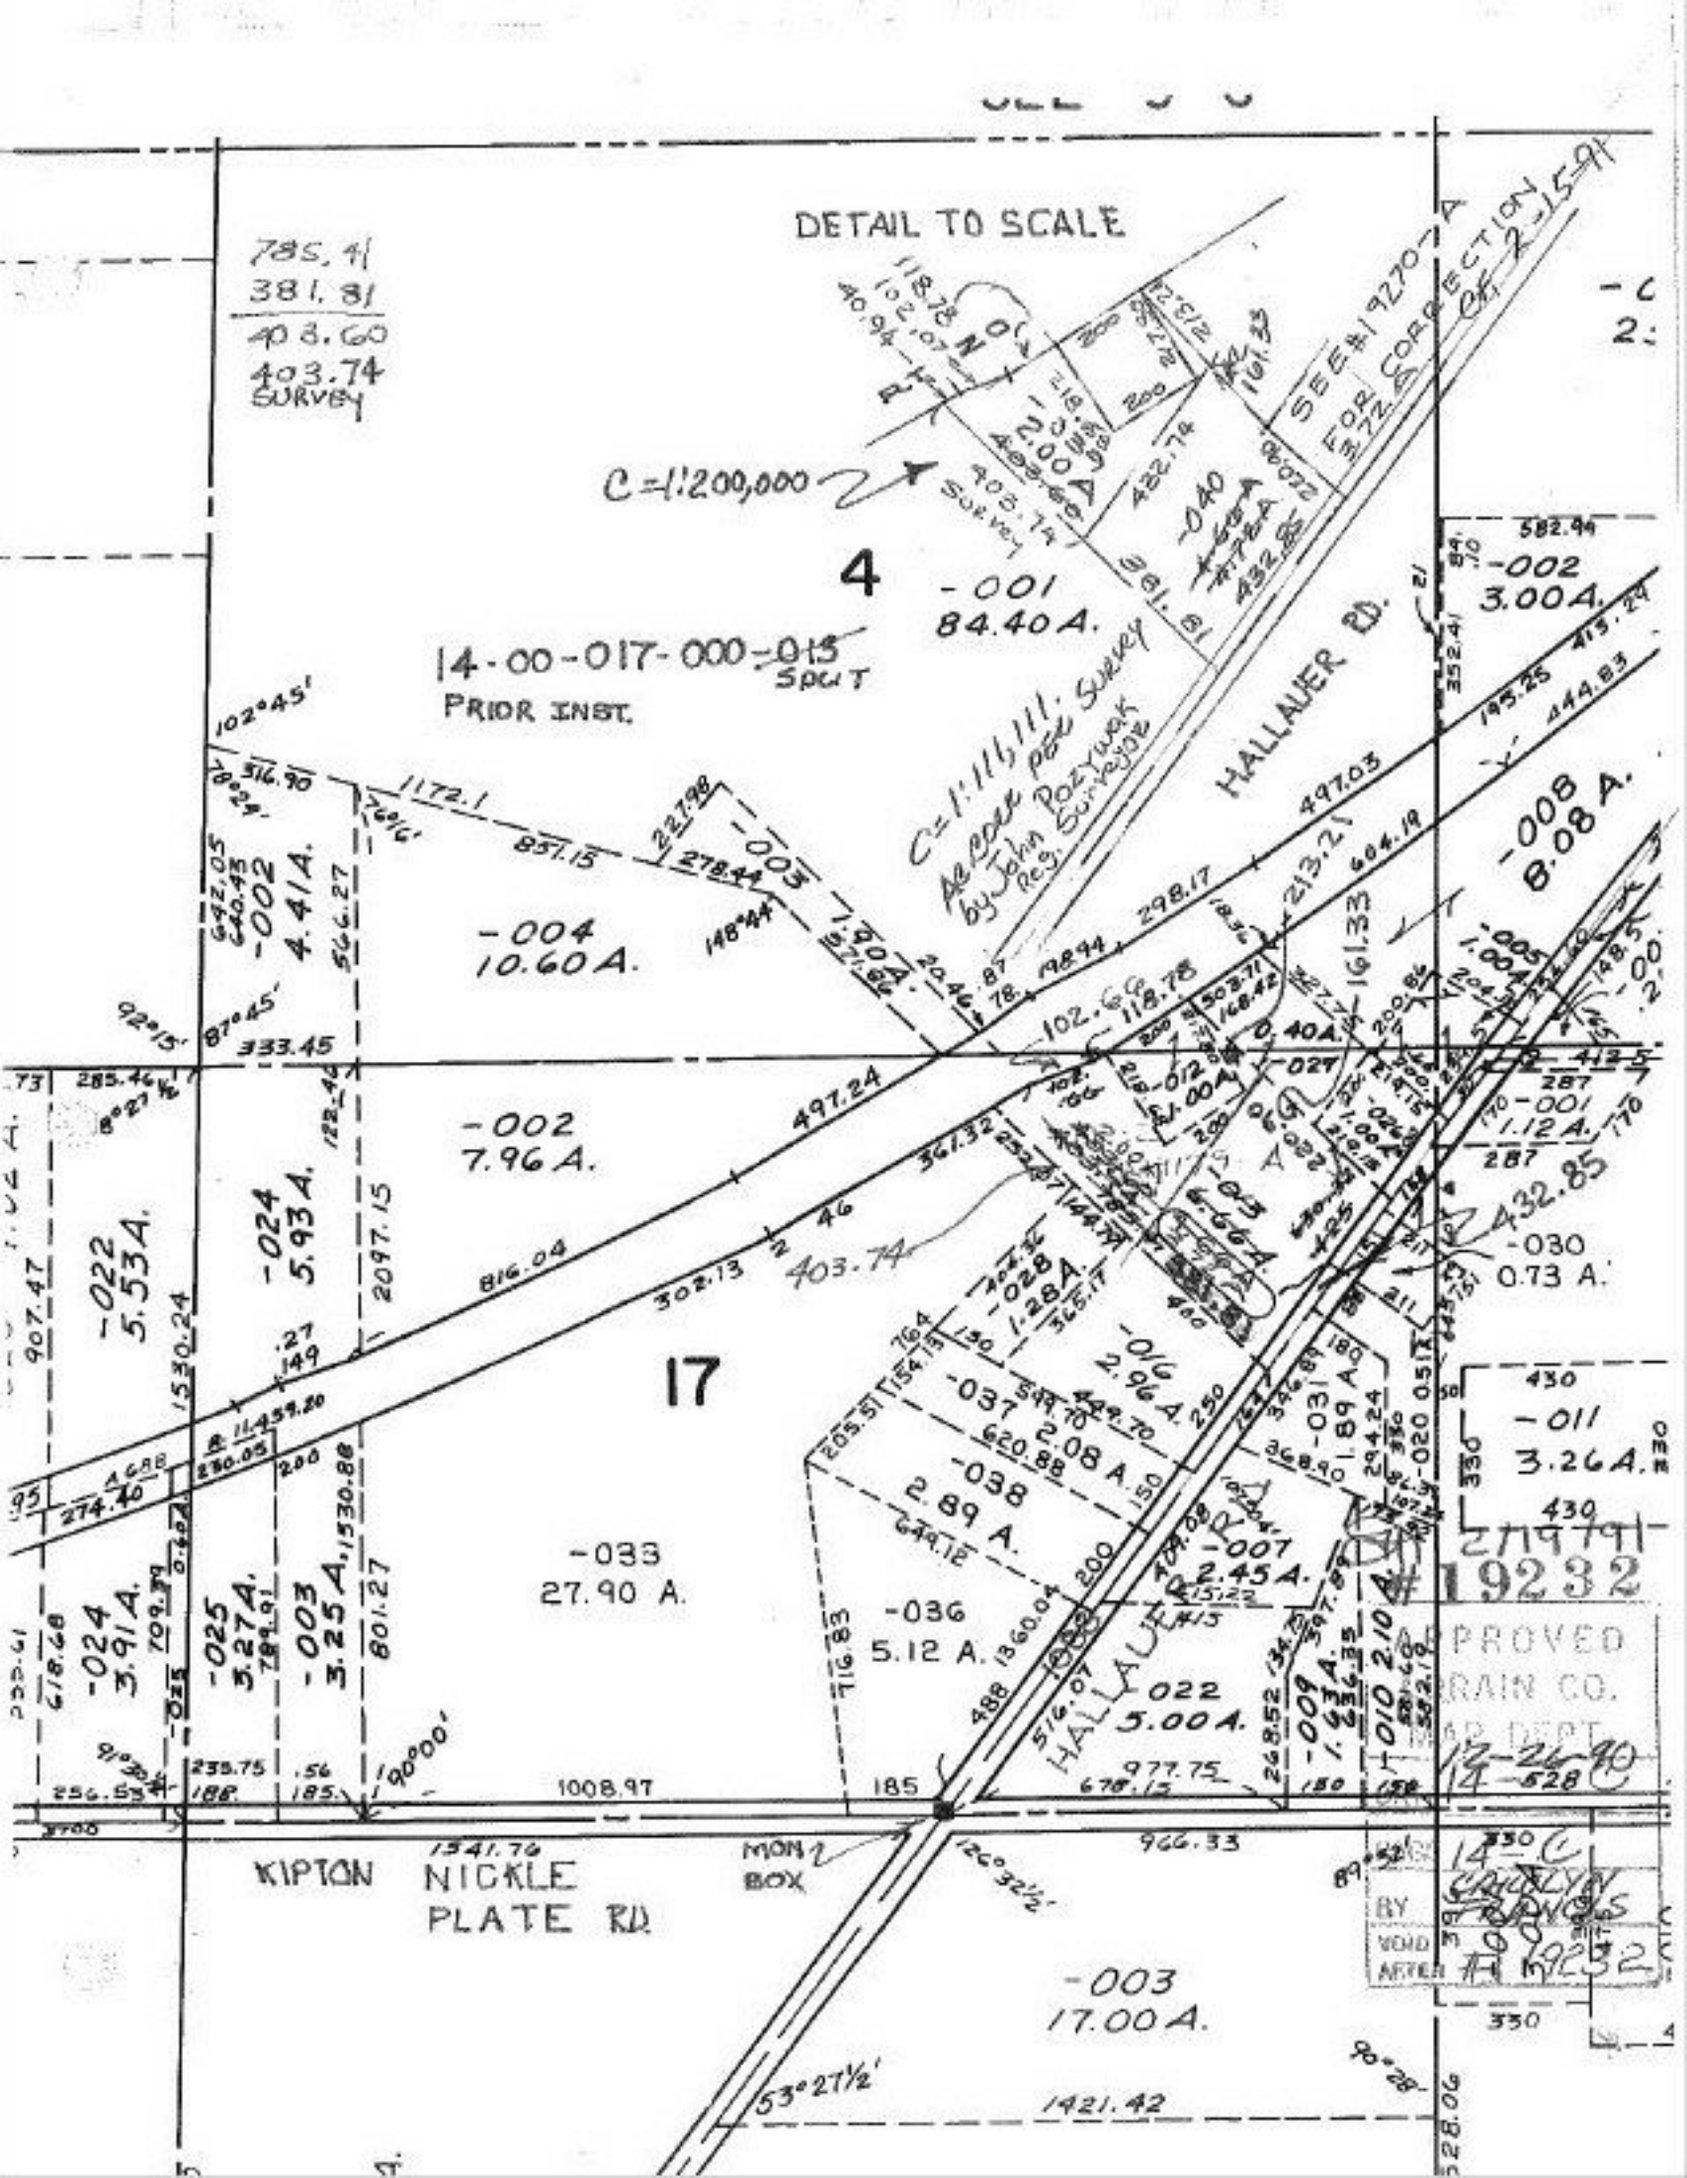
DETAIL TO SCALE
785.41
381.81
403.60
403.74
SURVEY
C=1:200,000
4
-001
84.40 A.
14-00-017-000-015
SPLIT
PRIOR INST.
C=1:111,111
As core per survey
by John Pozywak
Reg. Surveyor
HALLAUER RD.
SEE #19270-A
FOR CORRECTION
-002
3.00 A.
-008
8.08 A.
-004
10.60 A.
-002
4.41 A.
-002
7.96 A.
-024
5.93 A.
-022
5.53 A.
17
-033
27.90 A.
-036
5.12 A.
-037
2.08 A.
-038
2.89 A.
-016
2.96 A.
-028
1.28 A.
-030
0.73 A.
-011
3.26 A.
-007
2.45 A.
-022
5.00 A.
-009
1.63 A.
-010
2.10 A.
-024
3.91 A.
-025
3.27 A.
-003
3.25 A.
-003
17.00 A.
KIPTON NICKLE
PLATE RD.
MON BOX
1008.97
1541.76
966.33
1421.42
#19232
APPROVED
RAIN CO.
MAP DEPT.
12-26-90
14-C
BY
VOID
AFTER