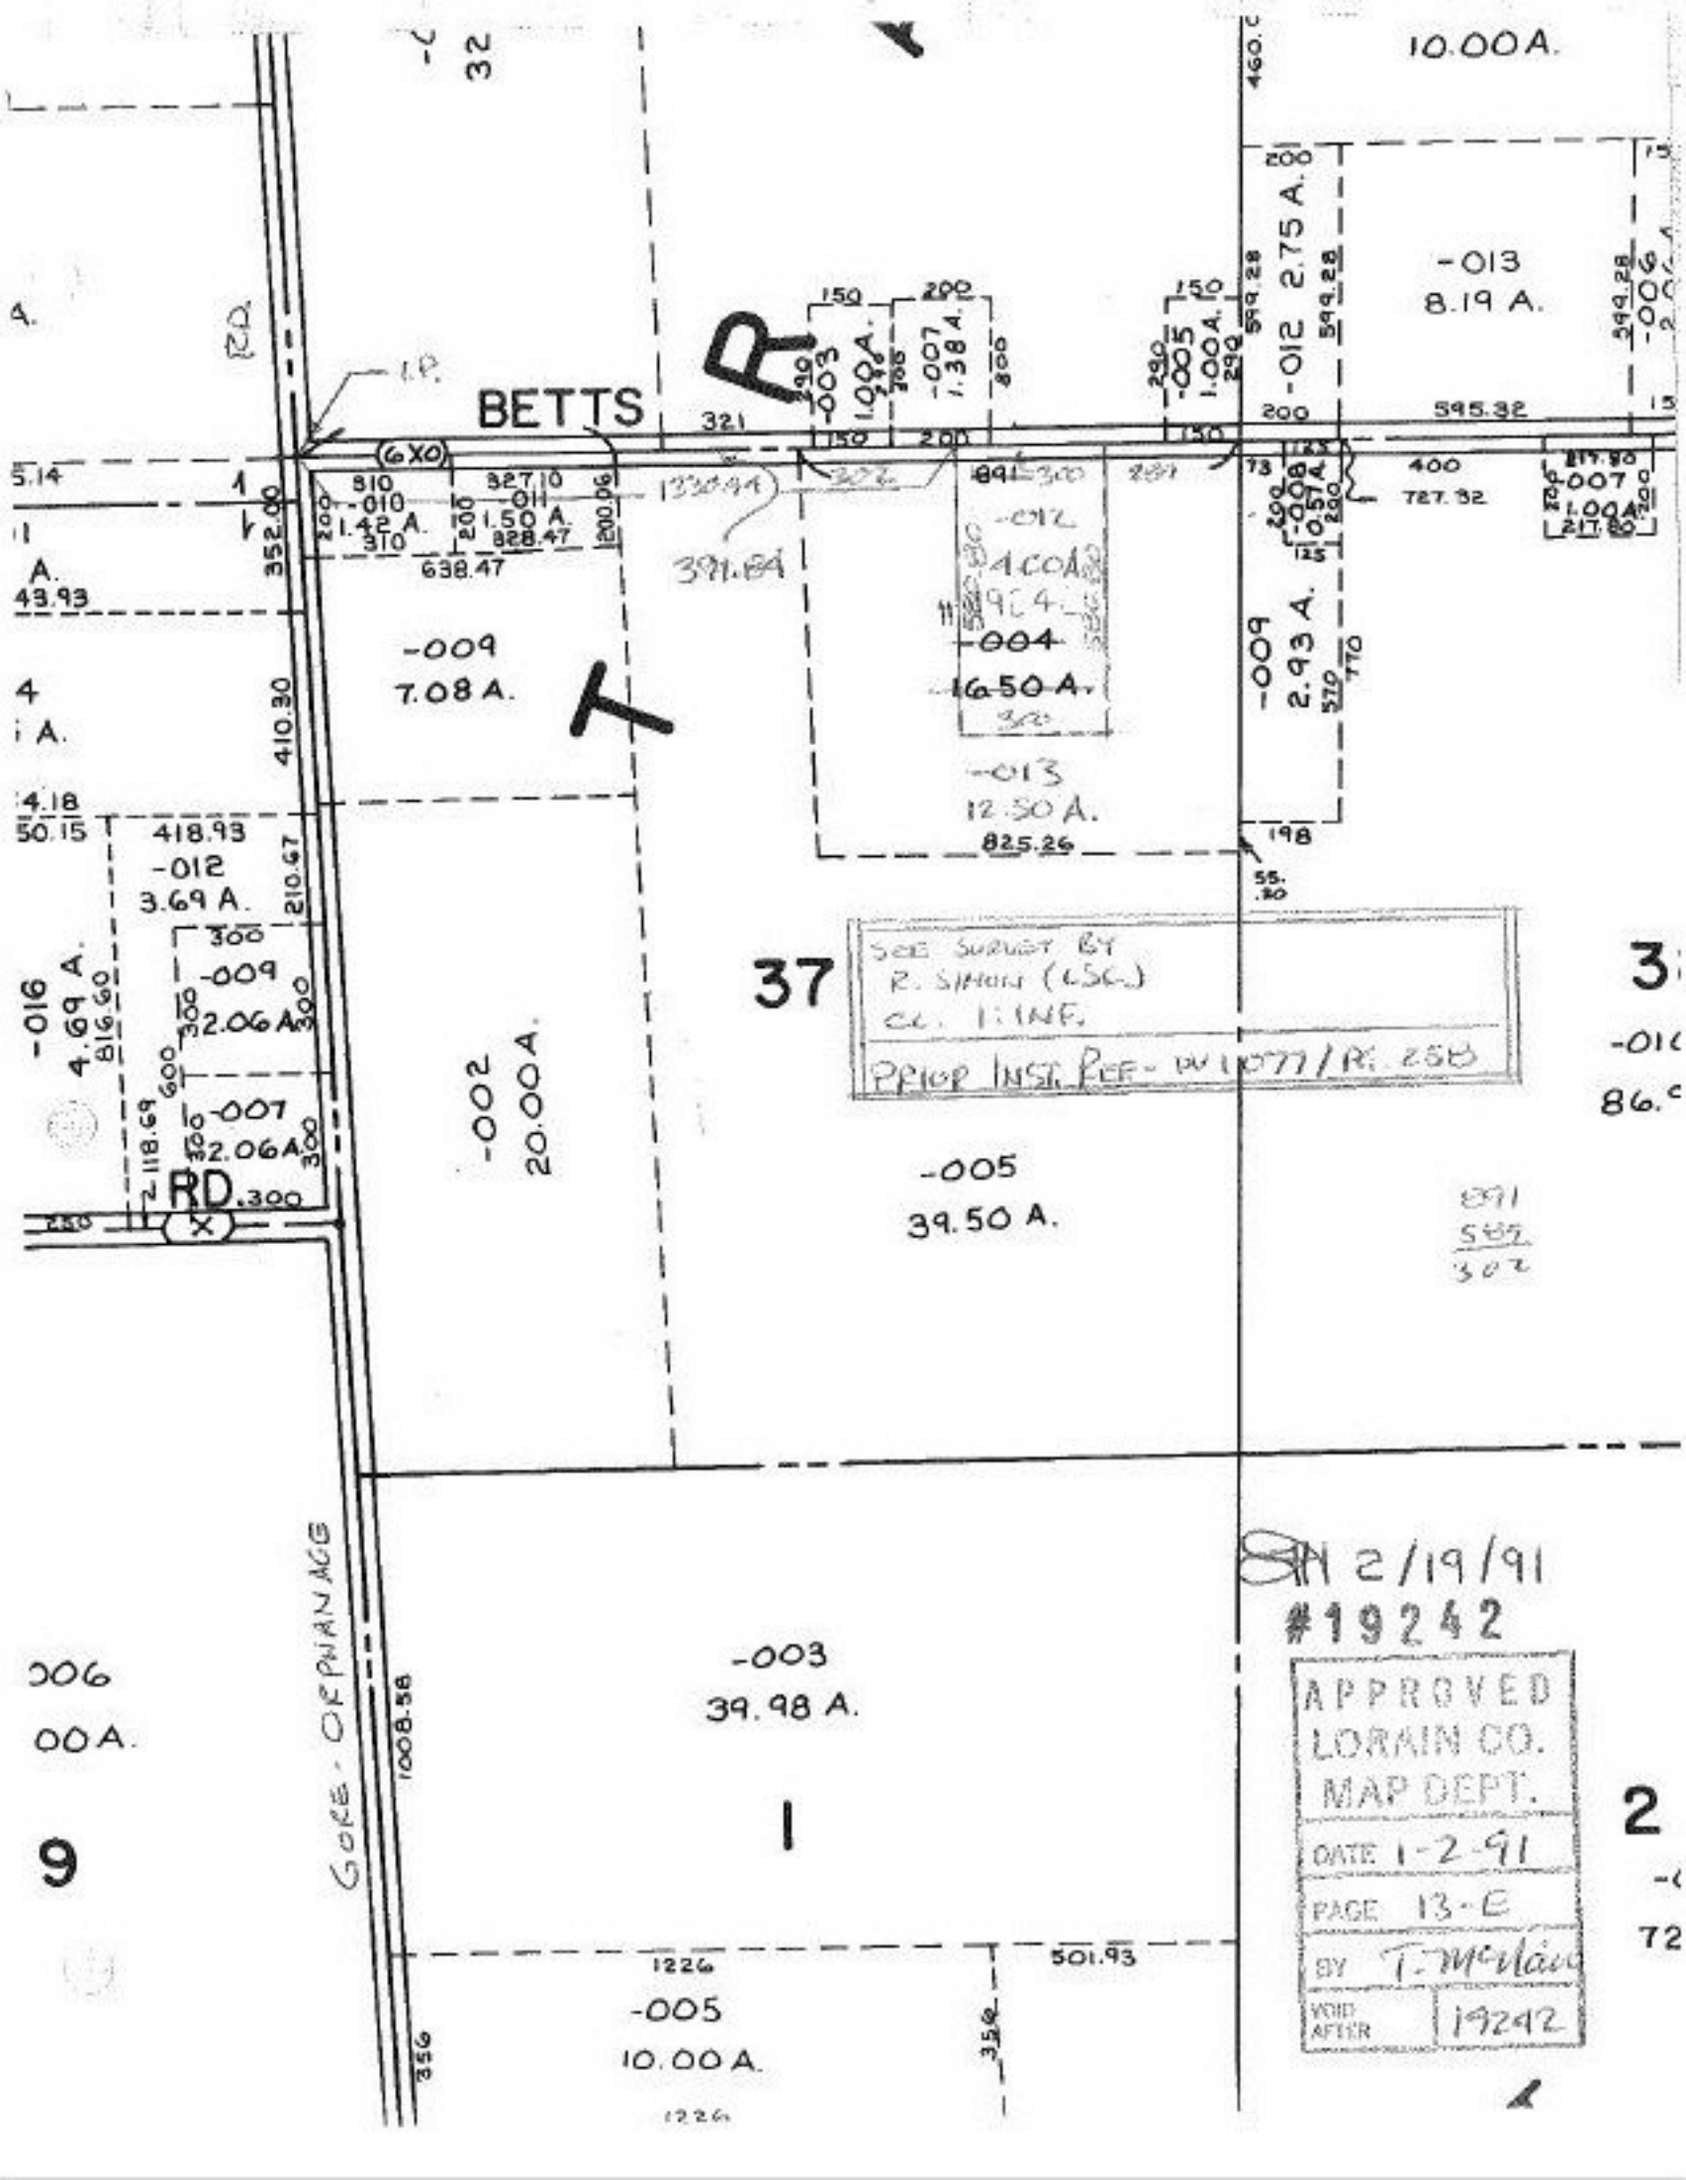
BETTS
R
T
37
-009
7.08 A.
-010
1.42 A.
-011
1.50 A.
-012
3.69 A.
-013
12.50 A.
-004
16.50 A.
-009
2.06 A.
-007
32.06 A.
-002
20.00 A.
-005
39.50 A.
-003
39.98 A.
-005
10.00 A.
-013
8.19 A.
-012
2.75 A.
-009
2.93 A.
-016
4.69 A.
RD.
GORE-ORPHANAGE
SEE SURVEY BY
R. SIMON (LSC)
CL. 1: INF.
PRIOR INSTR. REF - DV 1077 / PG. 258
2/19/91
#19242
APPROVED
LORAIN CO.
MAP DEPT.
DATE 1-2-91
PAGE 13-E
BY T. McClain
VOID AFTER 19242