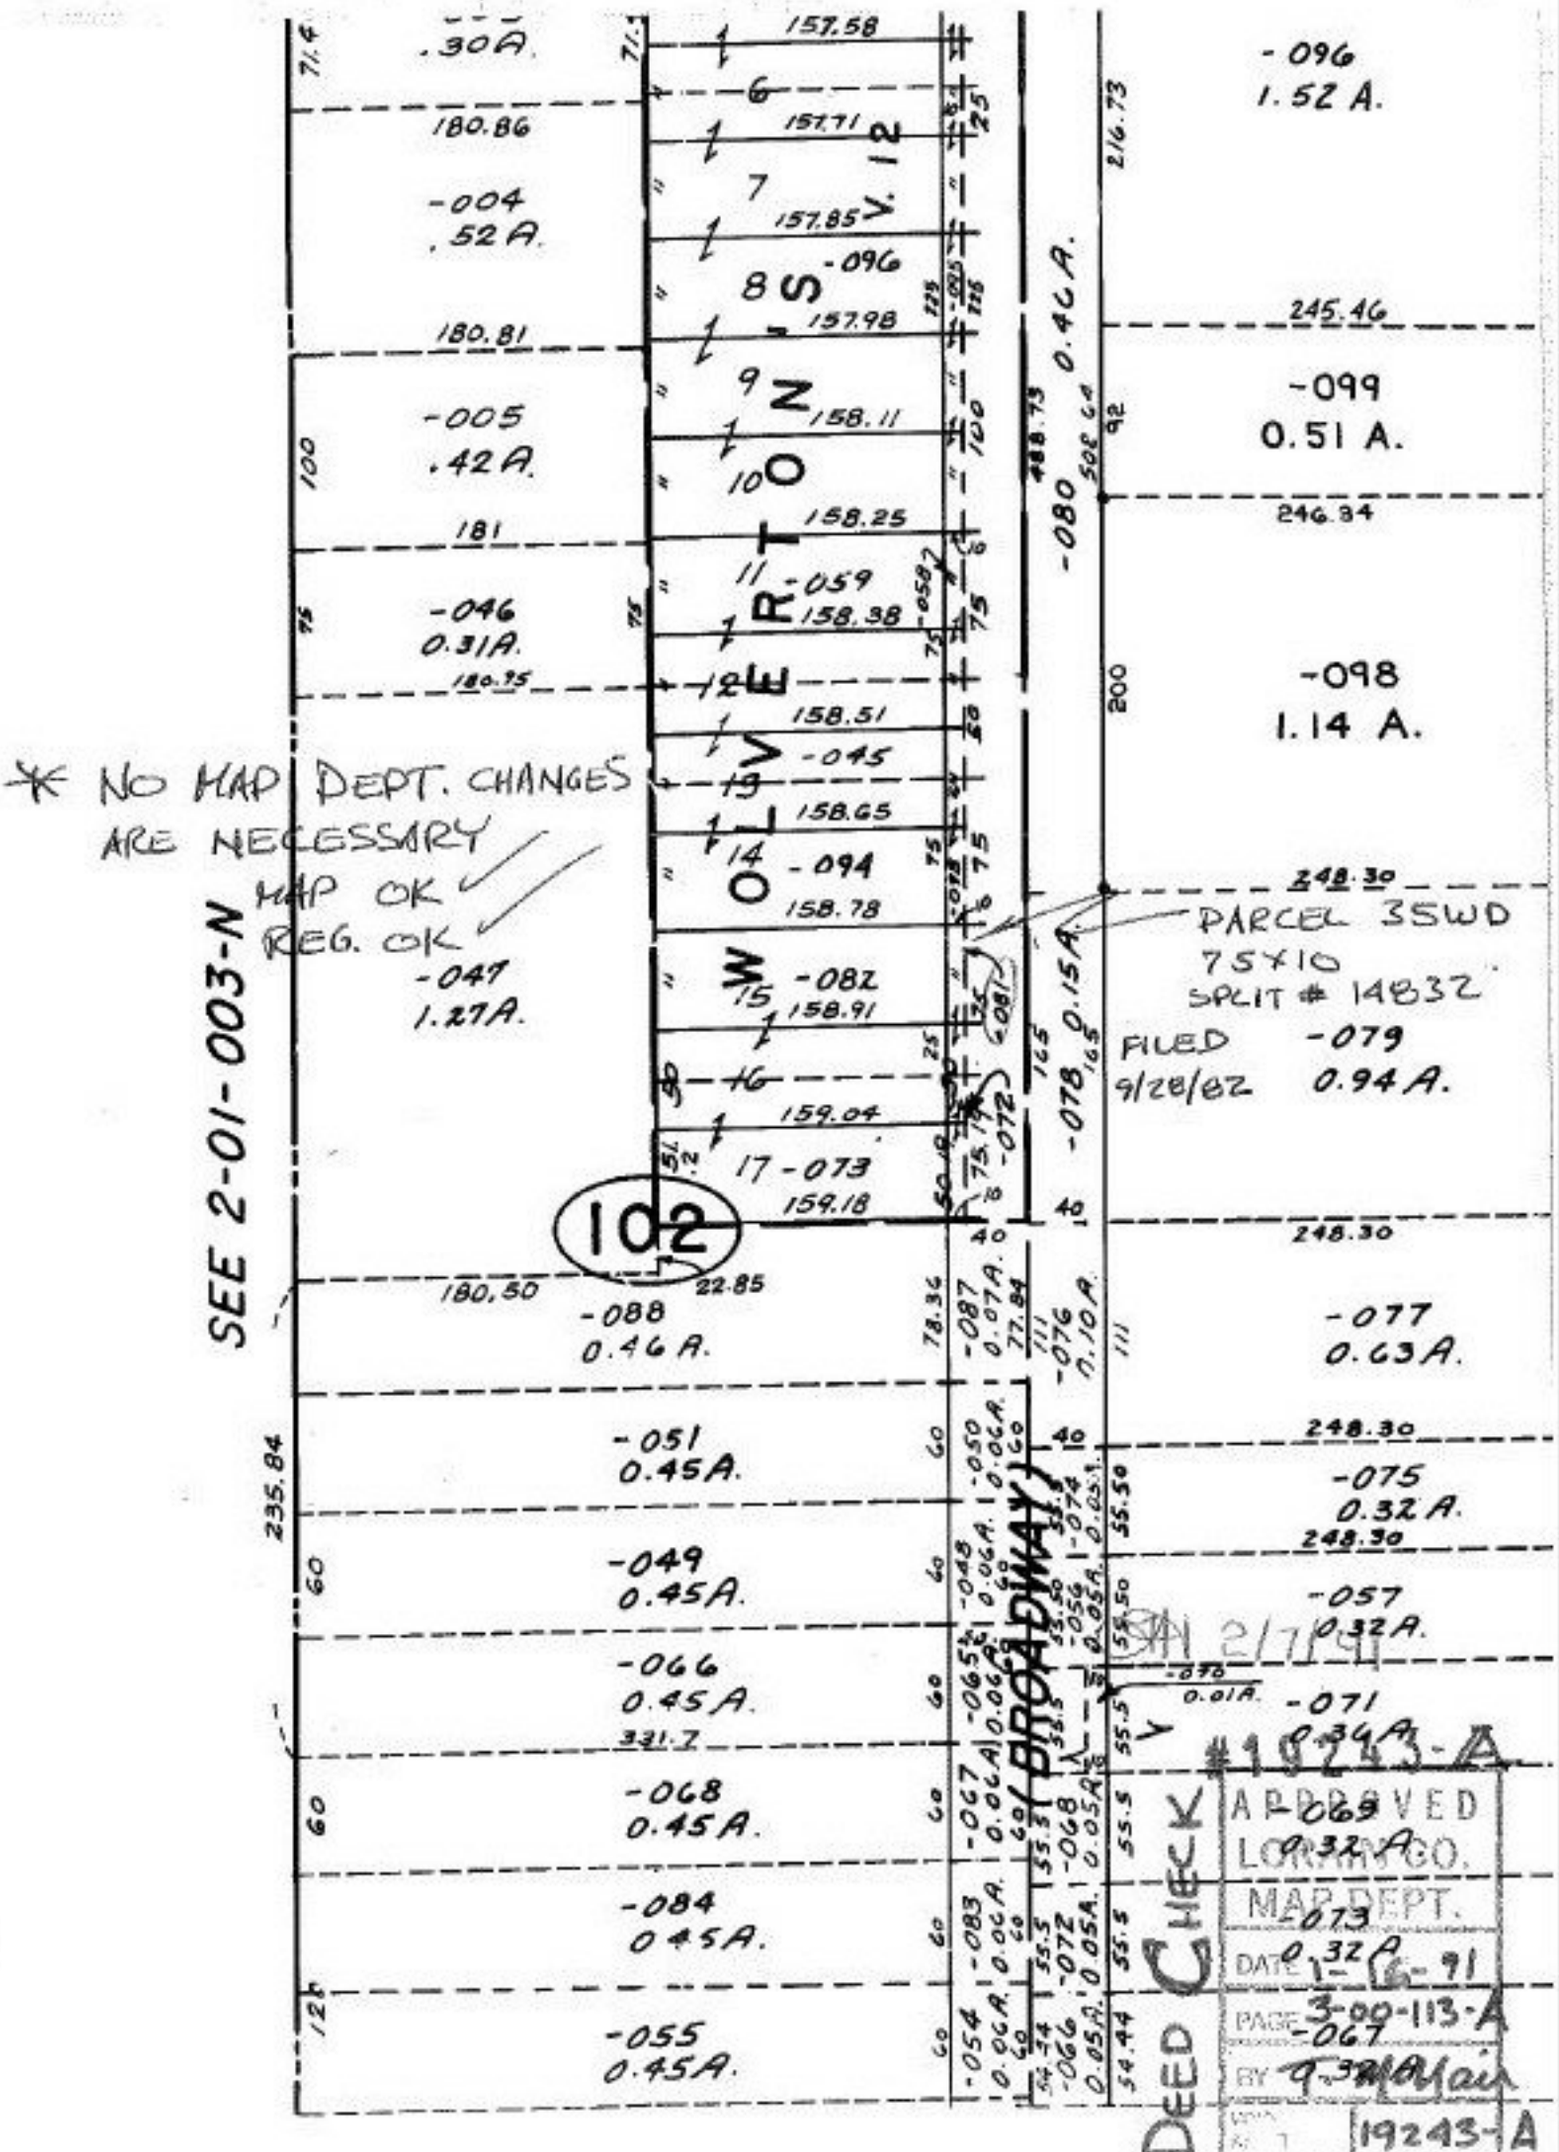
.30A.
157.58
-096
1.52 A.
180.86
157.71
-004
.52A.
157.85
-096
180.81
157.98
-005
.42A.
158.11
-099
0.51 A.
181
158.25
-046
0.31A.
-059
158.38
-098
1.14 A.
158.51
-045
158.65
-094
158.78
-047
1.27A.
-082
158.91
PARCEL 35WD
75X10
SPLIT # 14832
FILED 9/28/82
-079
0.94A.
159.04
-073
159.18
102
180.50
22.85
-088
0.46A.
-087
0.07A.
-076
0.10A.
-077
0.63A.
-051
0.45A.
-050
0.06A.
-075
0.32A.
-049
0.45A.
-048
0.06A.
-074
0.05A.
-057
0.32A.
-066
0.45A.
-065
0.06A.
-070
0.01A.
-071
0.34A.
331.7
-068
0.45A.
-067
0.06A.
-069
0.32A.
-084
0.45A.
-083
0.06A.
-072
0.05A.
-055
0.45A.
-054
0.06A.
-066
0.05A.
SEE 2-01-003-N
BROADWAY
* NO MAP DEPT. CHANGES ARE NECESSARY
MAP OK
REG. OK
DEED CHECK
APPROVED
LORAIN CO.
MAP DEPT.
DATE 1-26-91
PAGE 3-00-113-A
-067
BY
19243-A