1.43
.31
90 1.12
95 0.33
185 0.79

415.00
185.00
230.00
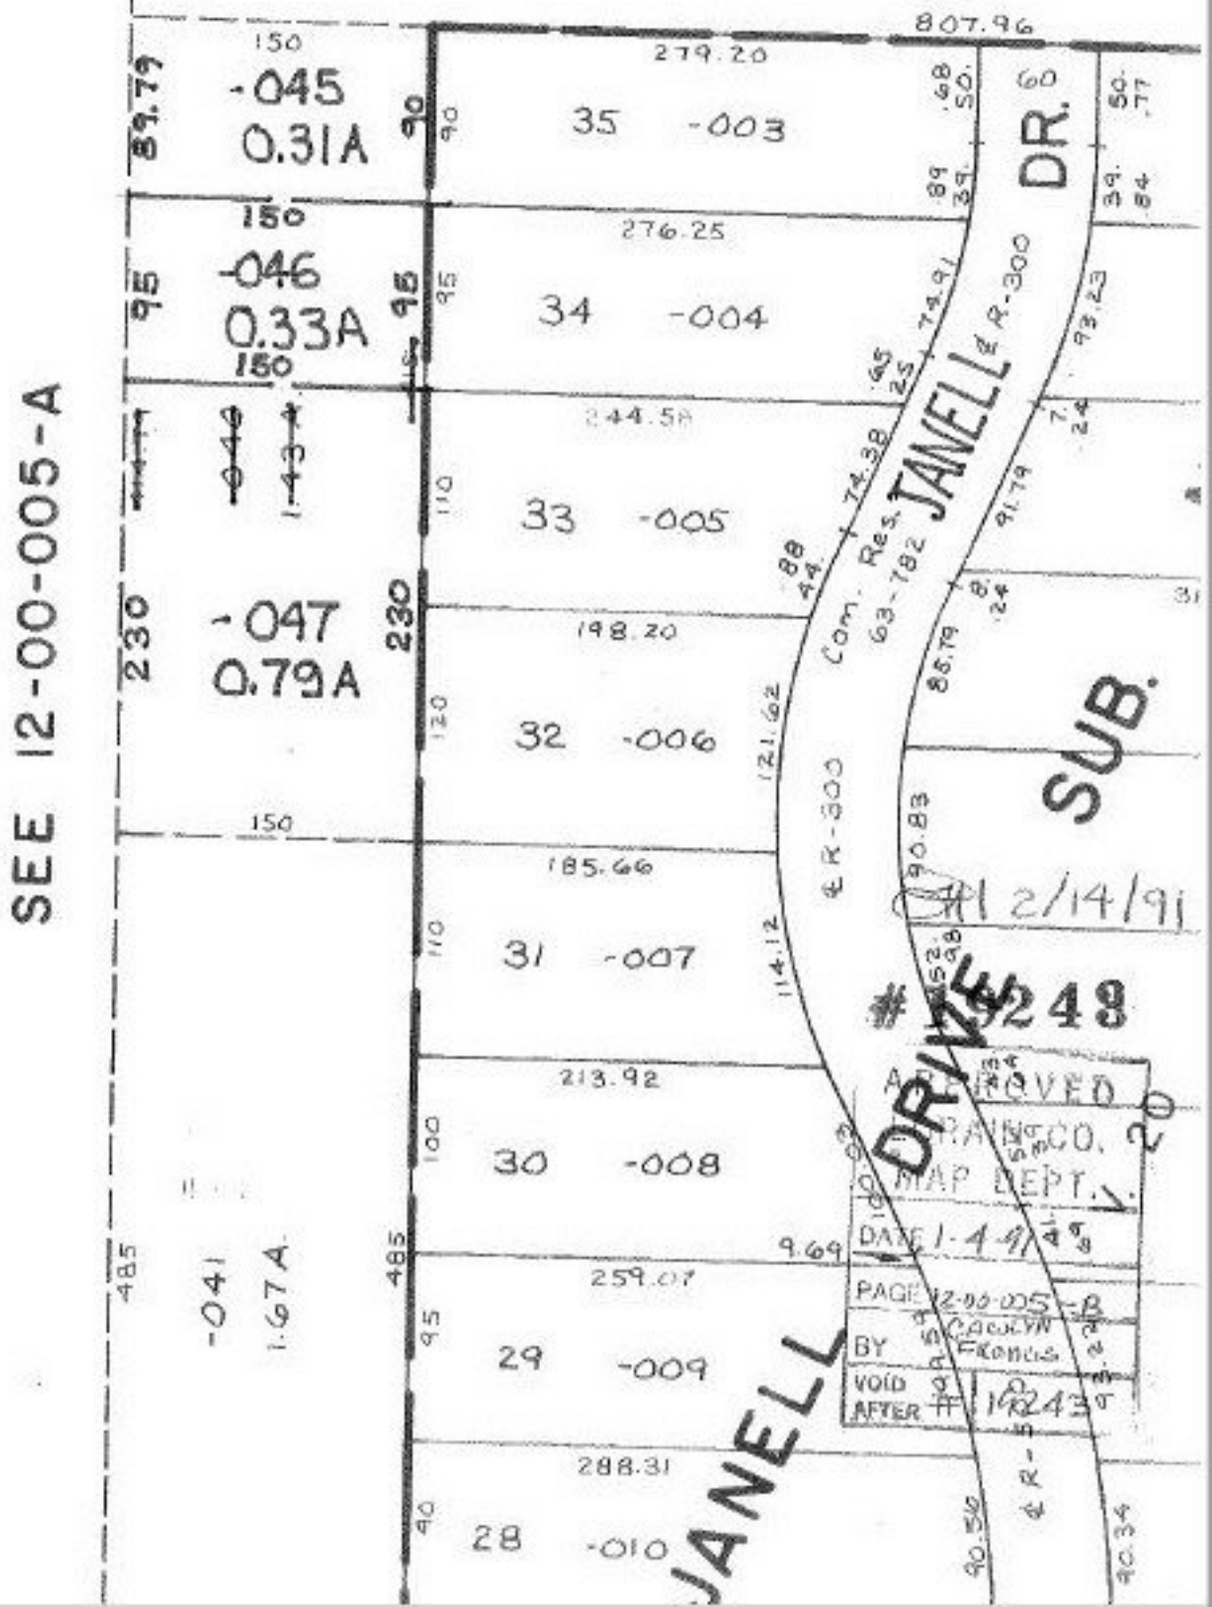
12-00-005-102- PRIOR INST. 1304/395
SURVEYED BY: ANDREW E. RUDY REG. SURVEYOR
(1) & (2) C=1: INF.