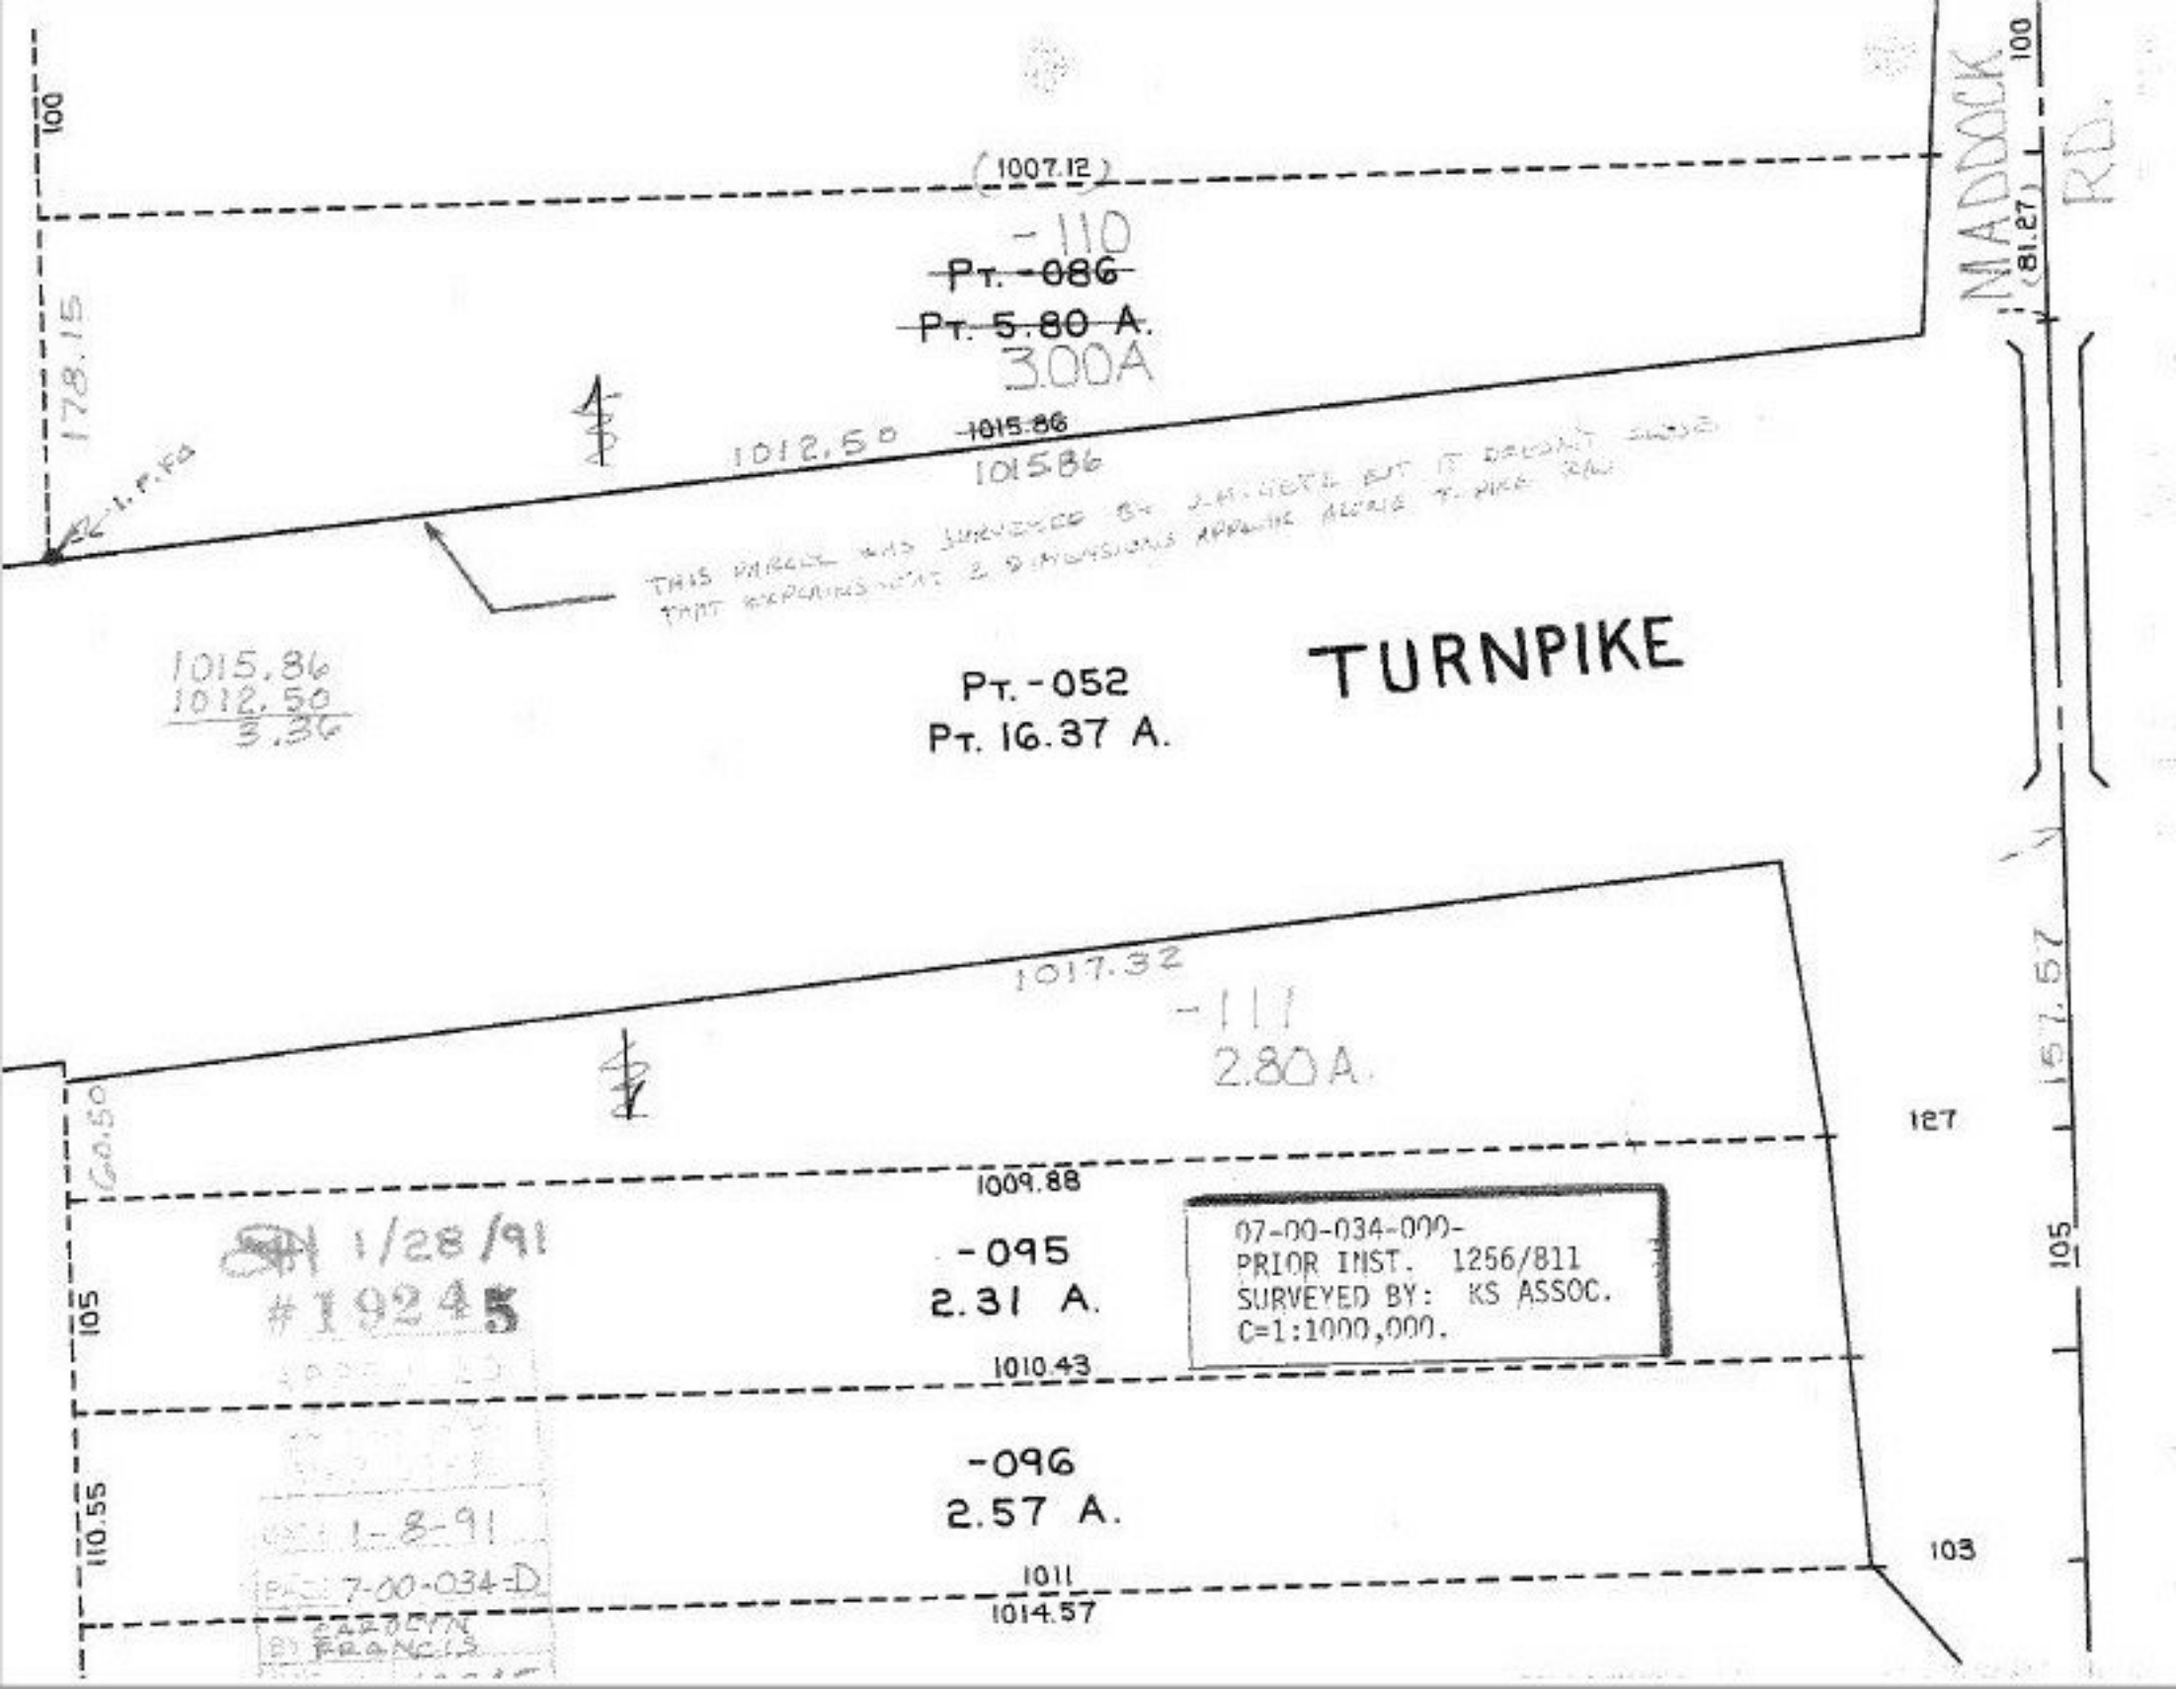
100
(1007.12)
-110
PT. -086
PT. 5.80 A.
3.00A
178.15
1012.50
1015.86
1015.86
THIS PARCEL WAS SURVEYED BY J.H. HOEFL BUT IT DOESN'T SHOW THAT REPLACING MAT & DIMENSIONS APPROX ACROS TURNPIKE R/W
1015.86
1012.50
3.36
PT. -052
PT. 16.37 A.
TURNPIKE
MADDOCK RD.
(81.27)
100
1017.32
-111
2.80 A.
127
167.57
105
1009.88
-095
2.31 A.
07-00-034-000-
PRIOR INST. 1256/811
SURVEYED BY: KS ASSOC.
C=1:1000,000.
1010.43
105
-096
2.57 A.
110.55
103
1011
1014.57
1/28/91
#19245
1-8-91
7-00-034-D
FRANCIS