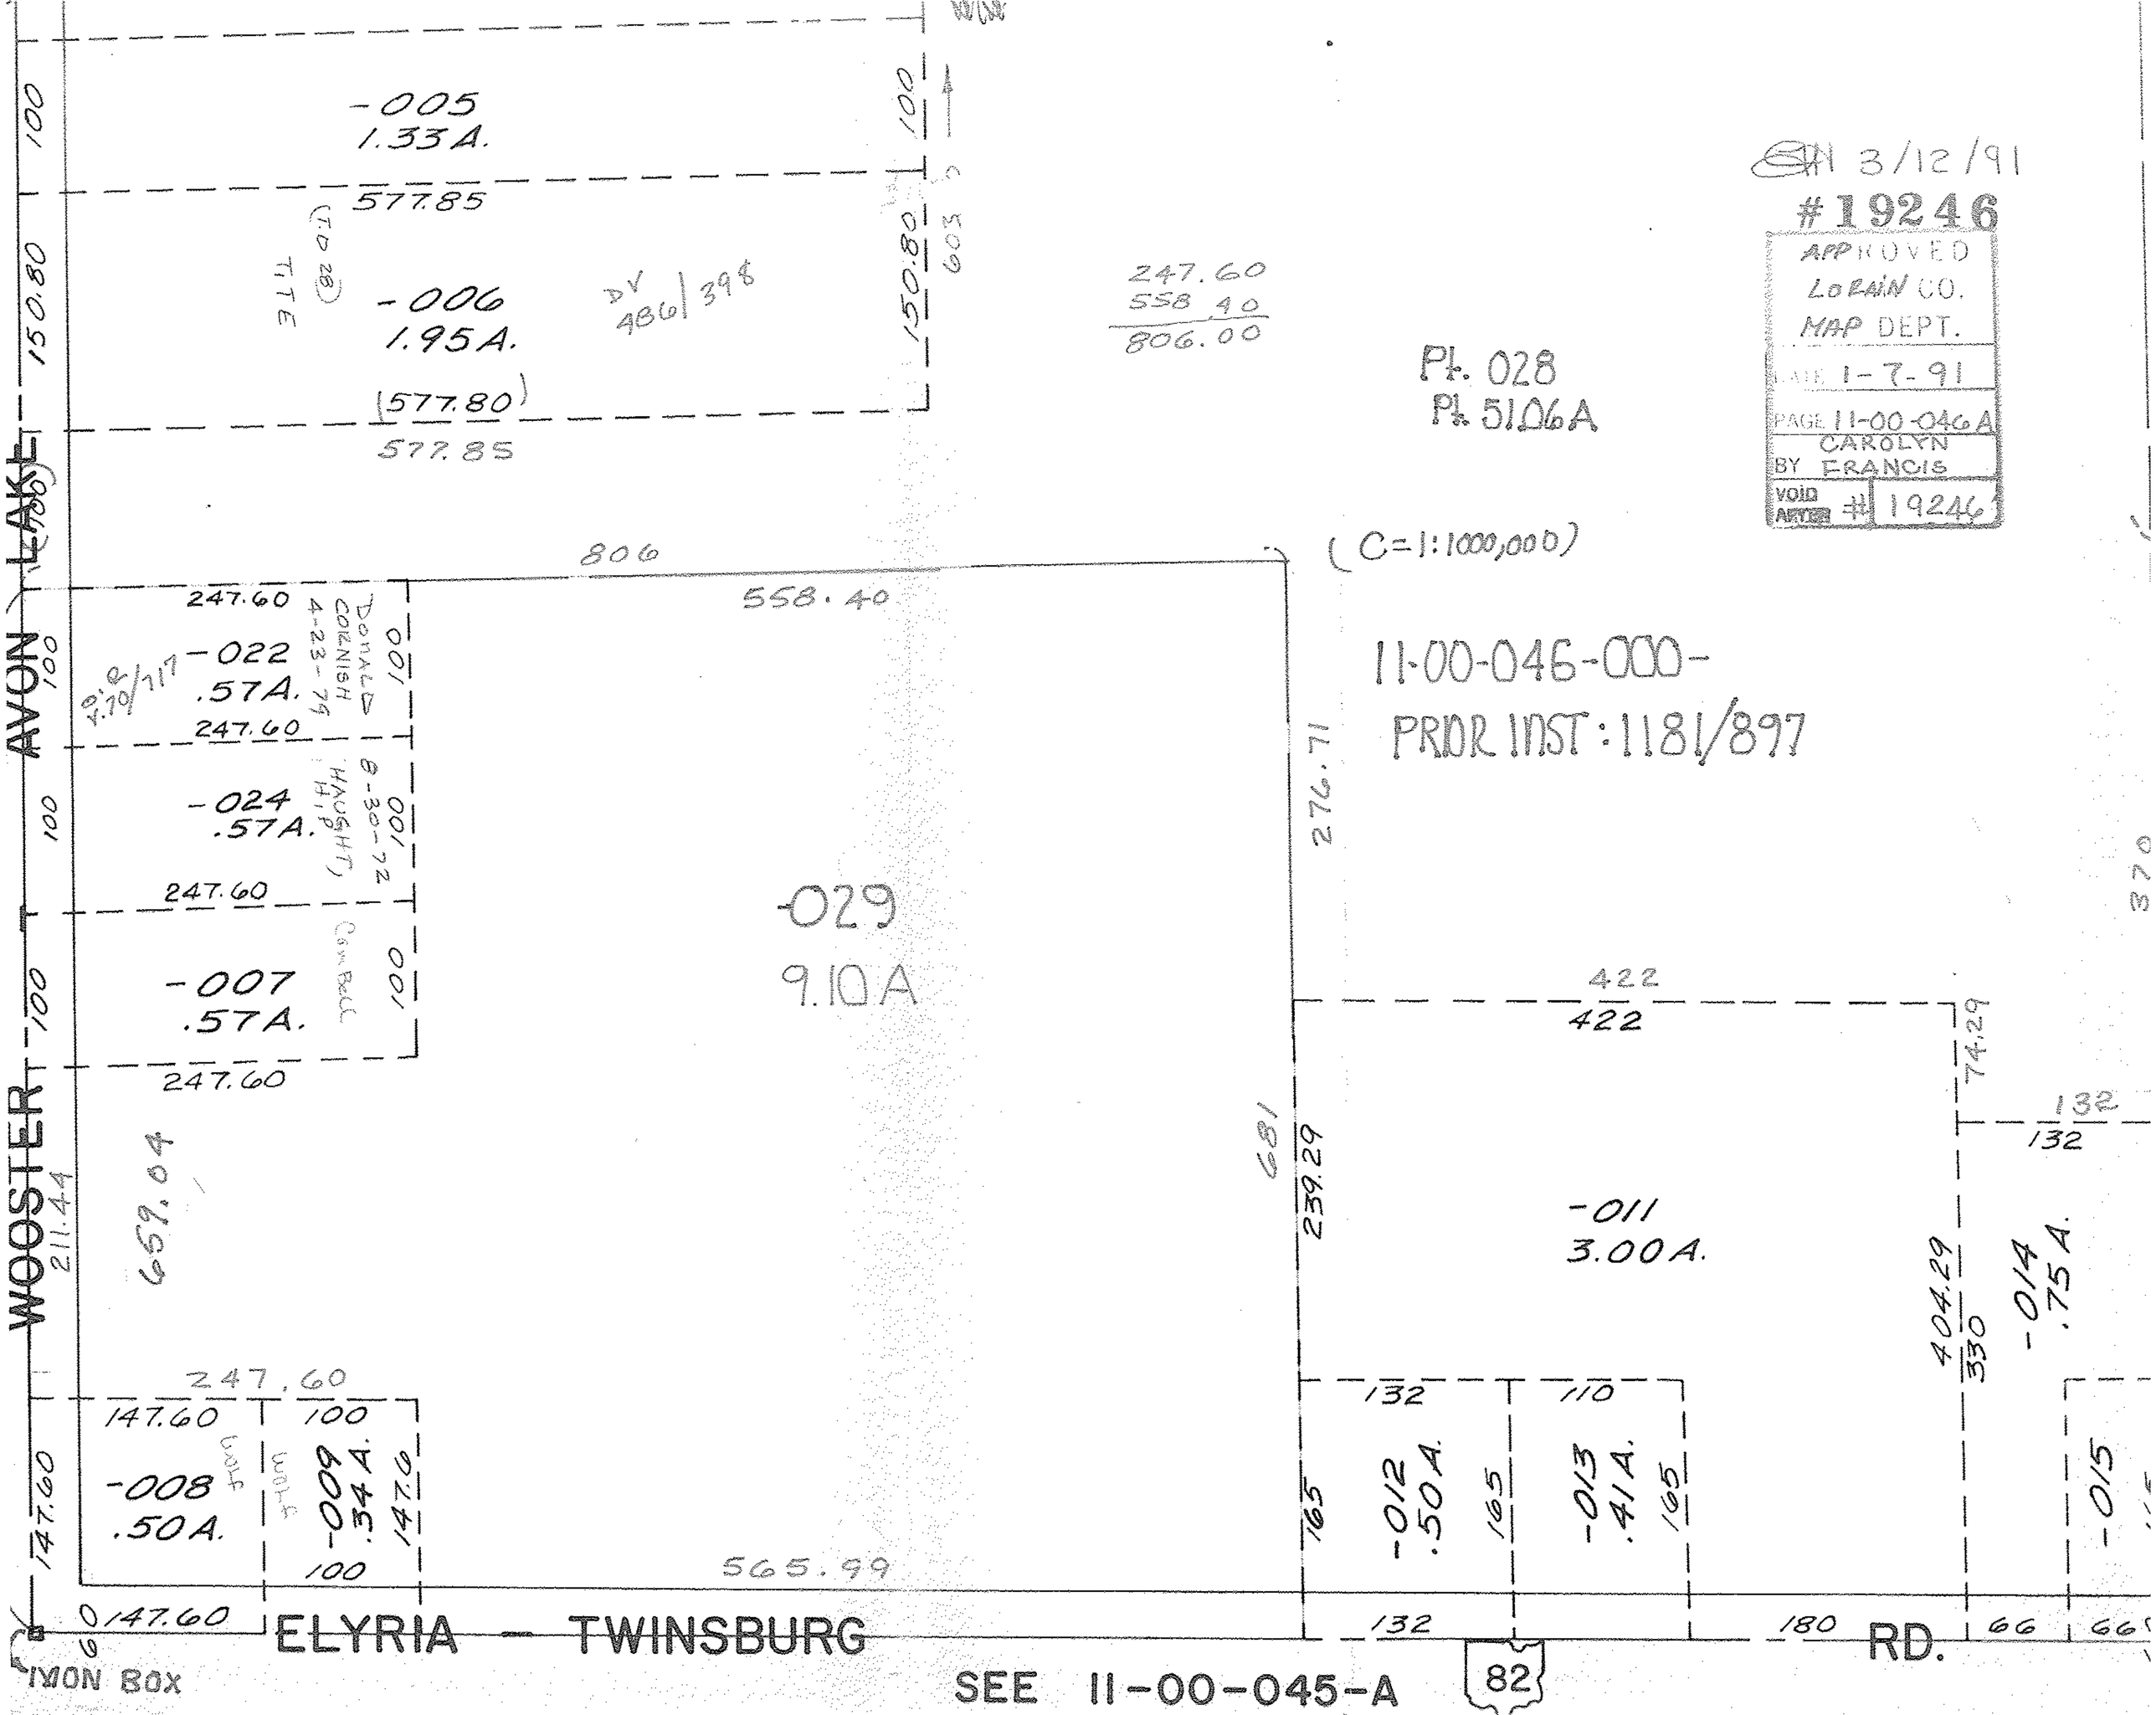

3/12/91
#19246
APPROVED
LORAIN CO.
MAP DEPT.
DATE 1-7-91
PAGE 11-00-046A
BY CAROLYN FRANCIS
VOID AFTER # 19246
Pt. 028
Pt. 5106A
(C=1:1000,000)
11-00-046-000-
PRIOR INST: 1181/897
-005
1.33A.
577.85
-006
1.95A.
(577.80)
577.85
DV 486/398
247.60
558.40
806.00
806
558.40
-022
.57A.
247.60
-024
.57A.
247.60
-007
.57A.
247.60
-029
9.10A
276.71
422
422
74.29
132
132
681
239.29
-011
3.00A.
404.29
330
-014
.75A.
-015
659.04
211.44
247.60
147.60
-008
.50A.
-009
.34A.
147.6
565.99
132
110
-012
.50A.
-013
.41A.
165
132
180
66
66
147.60
ELYRIA — TWINSBURG RD.
WOOSTER AVON LAKE
IMON BOX
SEE 11-00-045-A
82