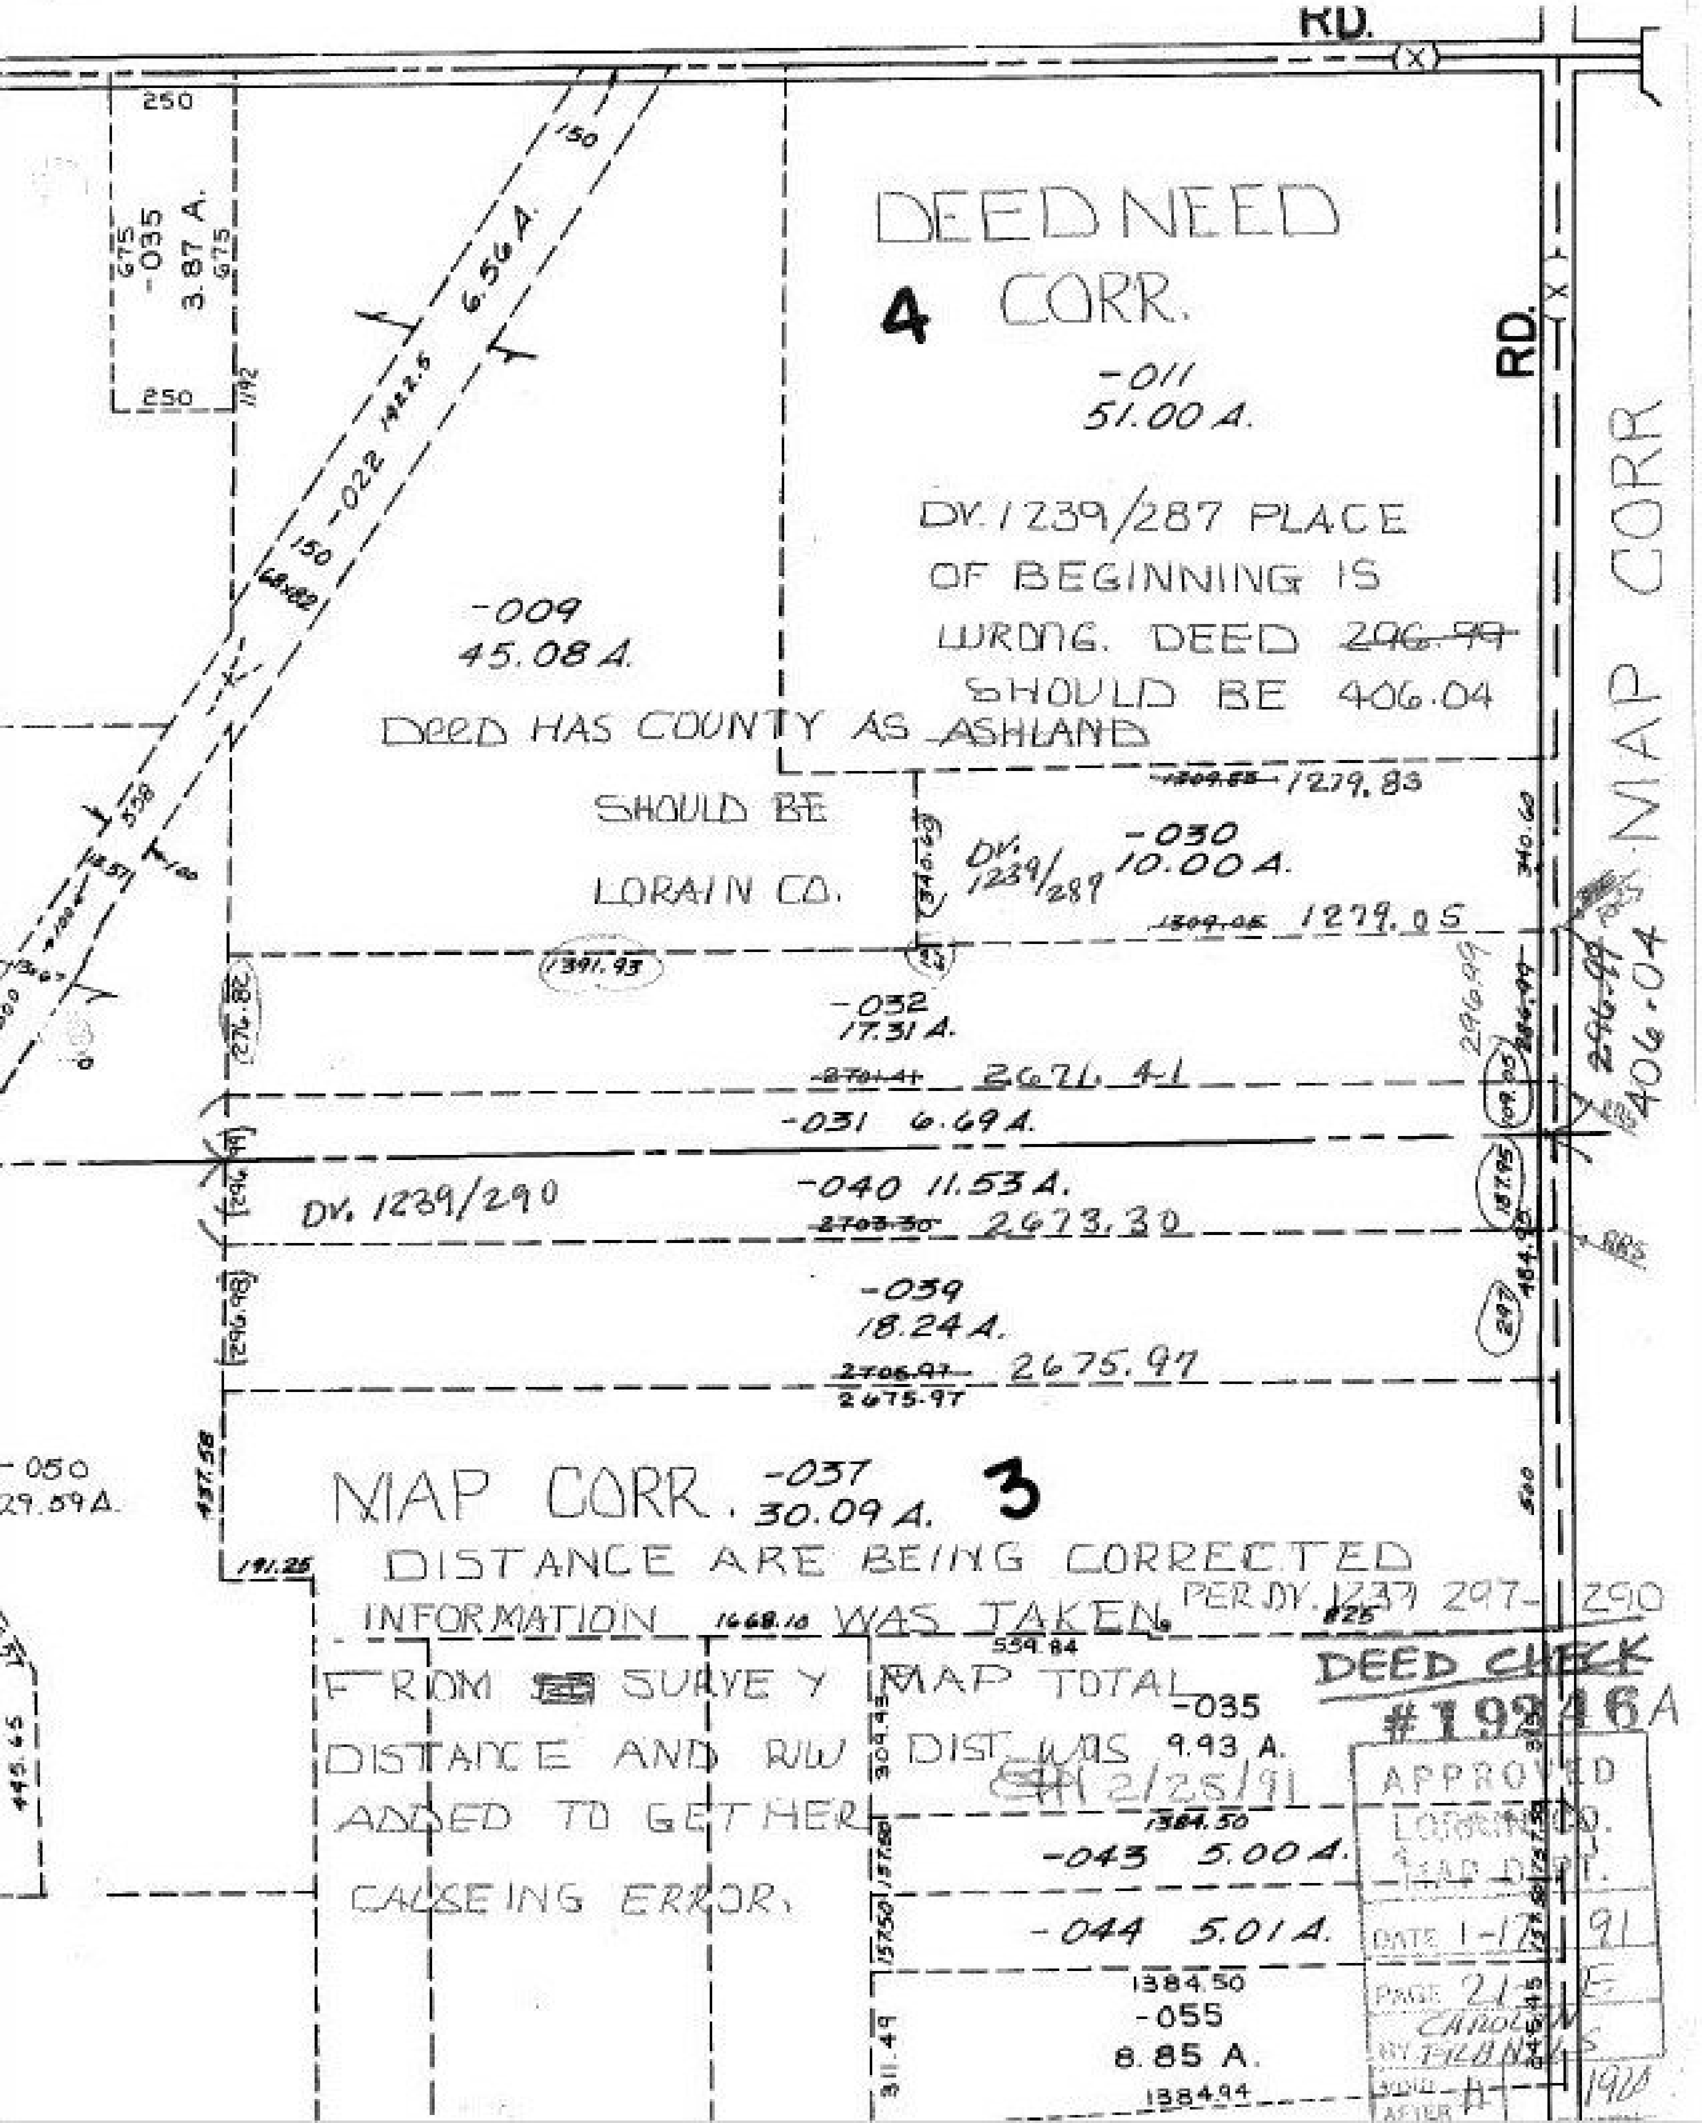

RD.
DEED NEED
4 CORR.
-011
51.00 A.
DV. 1239/287 PLACE
OF BEGINNING IS
WRONG. DEED 296.99
SHOULD BE 406.04
RD.
MAP CORR
-035
3.87 A.
250
-022 6.56 A.
150
-009
45.08 A.
DEED HAS COUNTY AS ASHLAND
SHOULD BE
LORAIN CO.
DV. 1239/289
-030
10.00 A.
1279.83
1279.05
1391.93
-032
17.31 A.
2671.41
-031 6.69 A.
-040 11.53 A.
DV. 1239/290
2673.30
-039
18.24 A.
2675.97
406.04
-050
29.59 A.
MAP CORR.
-037
30.09 A.
3
DISTANCE ARE BEING CORRECTED
INFORMATION WAS TAKEN
PER DV. 1239 287-290
FROM SURVEY MAP TOTAL
DISTANCE AND R/W DIST WAS
ADDED TO GETHER
CAUSEING ERROR.
DEED CHECK
#19246A
-035
9.93 A.
2/25/91
-043 5.00 A.
-044 5.01 A.
1384.50
-055
8.85 A.
APPROVED
LORAIN CO.
MAP DEPT.
DATE 1-17-91
PAGE 21