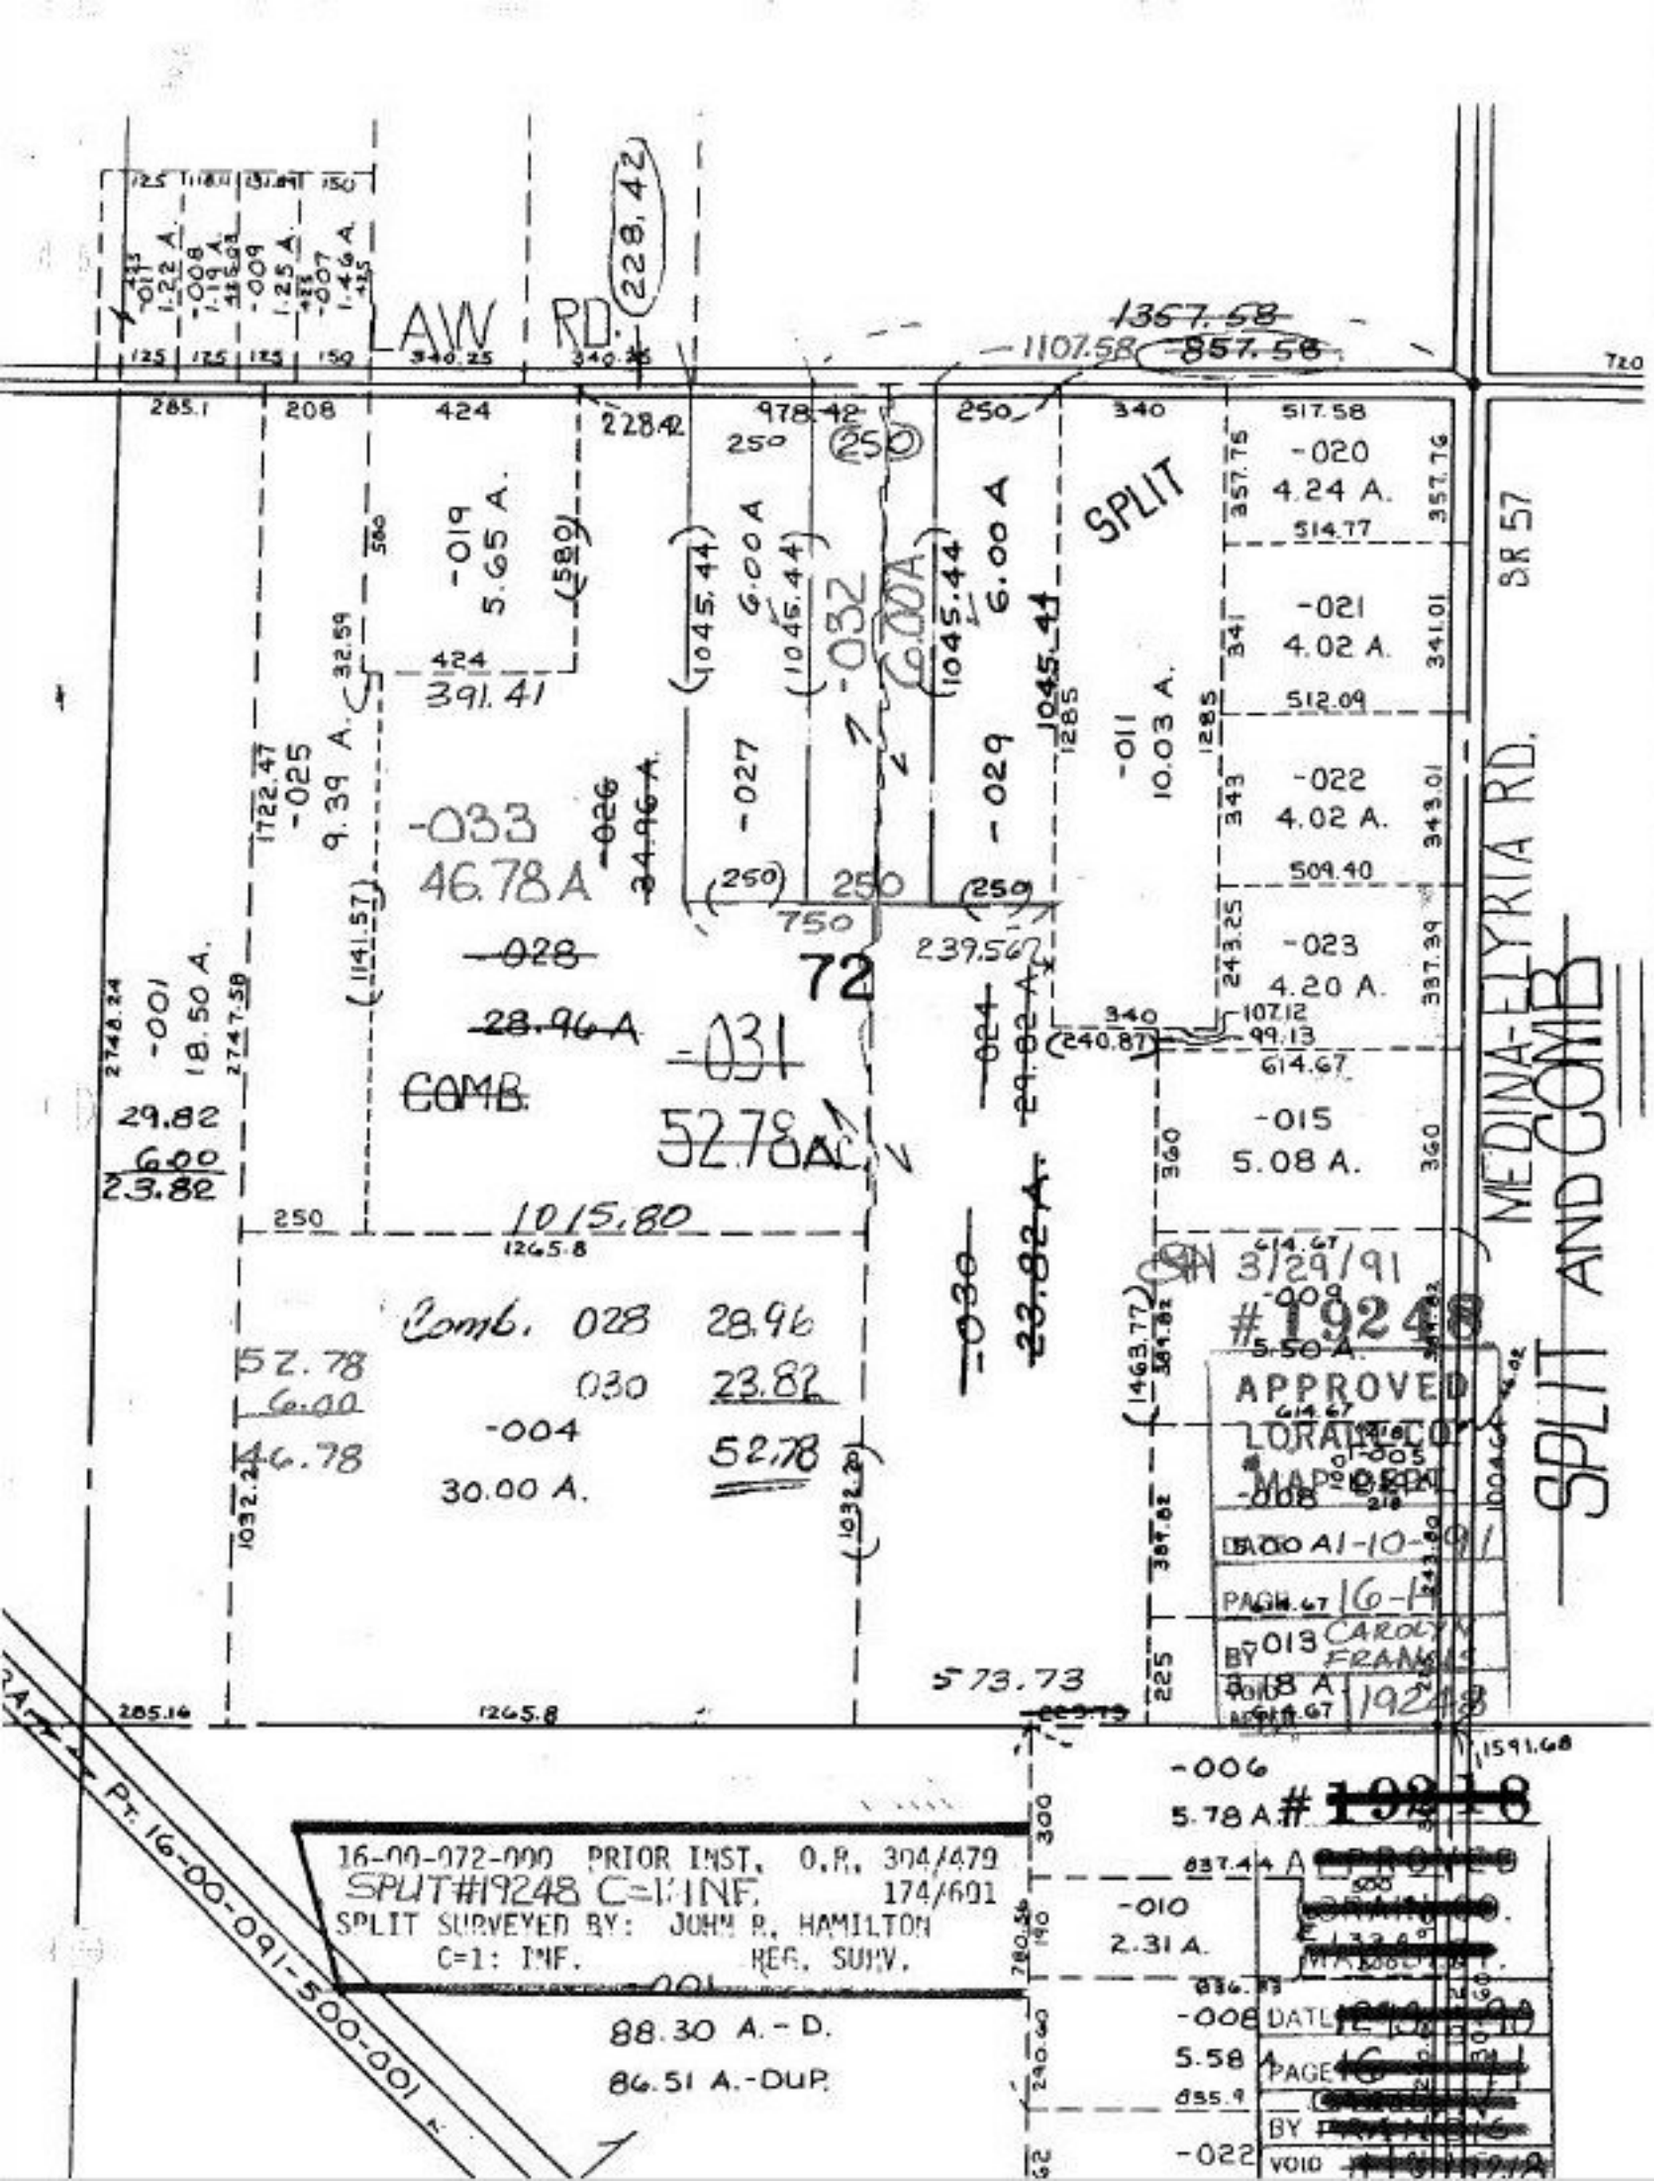
LAW RD.
MEDINA-ELYRIA RD.
SPLIT AND COMB
SR 57
SPLIT
-020 4.24 A.
-021 4.02 A.
-022 4.02 A.
-023 4.20 A.
-015 5.08 A.
-019 5.65 A.
-025 9.39 A.
-033 46.78 A
-028 28.96 A
COMB.
-031 52.78 A.
-032 6.00 A
-027
-029
-011 10.03 A.
-001 18.50 A.
29.82
6.00
23.82
72
1015.80
Comb. 028 28.96
030 23.82
-004 30.00 A.
52.78
6.00
46.78
573.73
-006 5.78 A.
-010 2.31 A.
-008 5.58 A.
-022
88.30 A.-D.
86.51 A.-DUP.
Pt. 16-00-091-500-001
SN 3/29/91
#19248
APPROVED
LORAIN CO.
MAP DEPT.
DATE 1-10-91
PAGE 16-1
BY CAROLYN FRANKS
VOID 19248
16-00-072-000 PRIOR INST. O.R. 304/479
SPLIT#19248 C=1:INF. 174/601
SPLIT SURVEYED BY: JOHN R. HAMILTON
C=1: INF. REG. SURV.