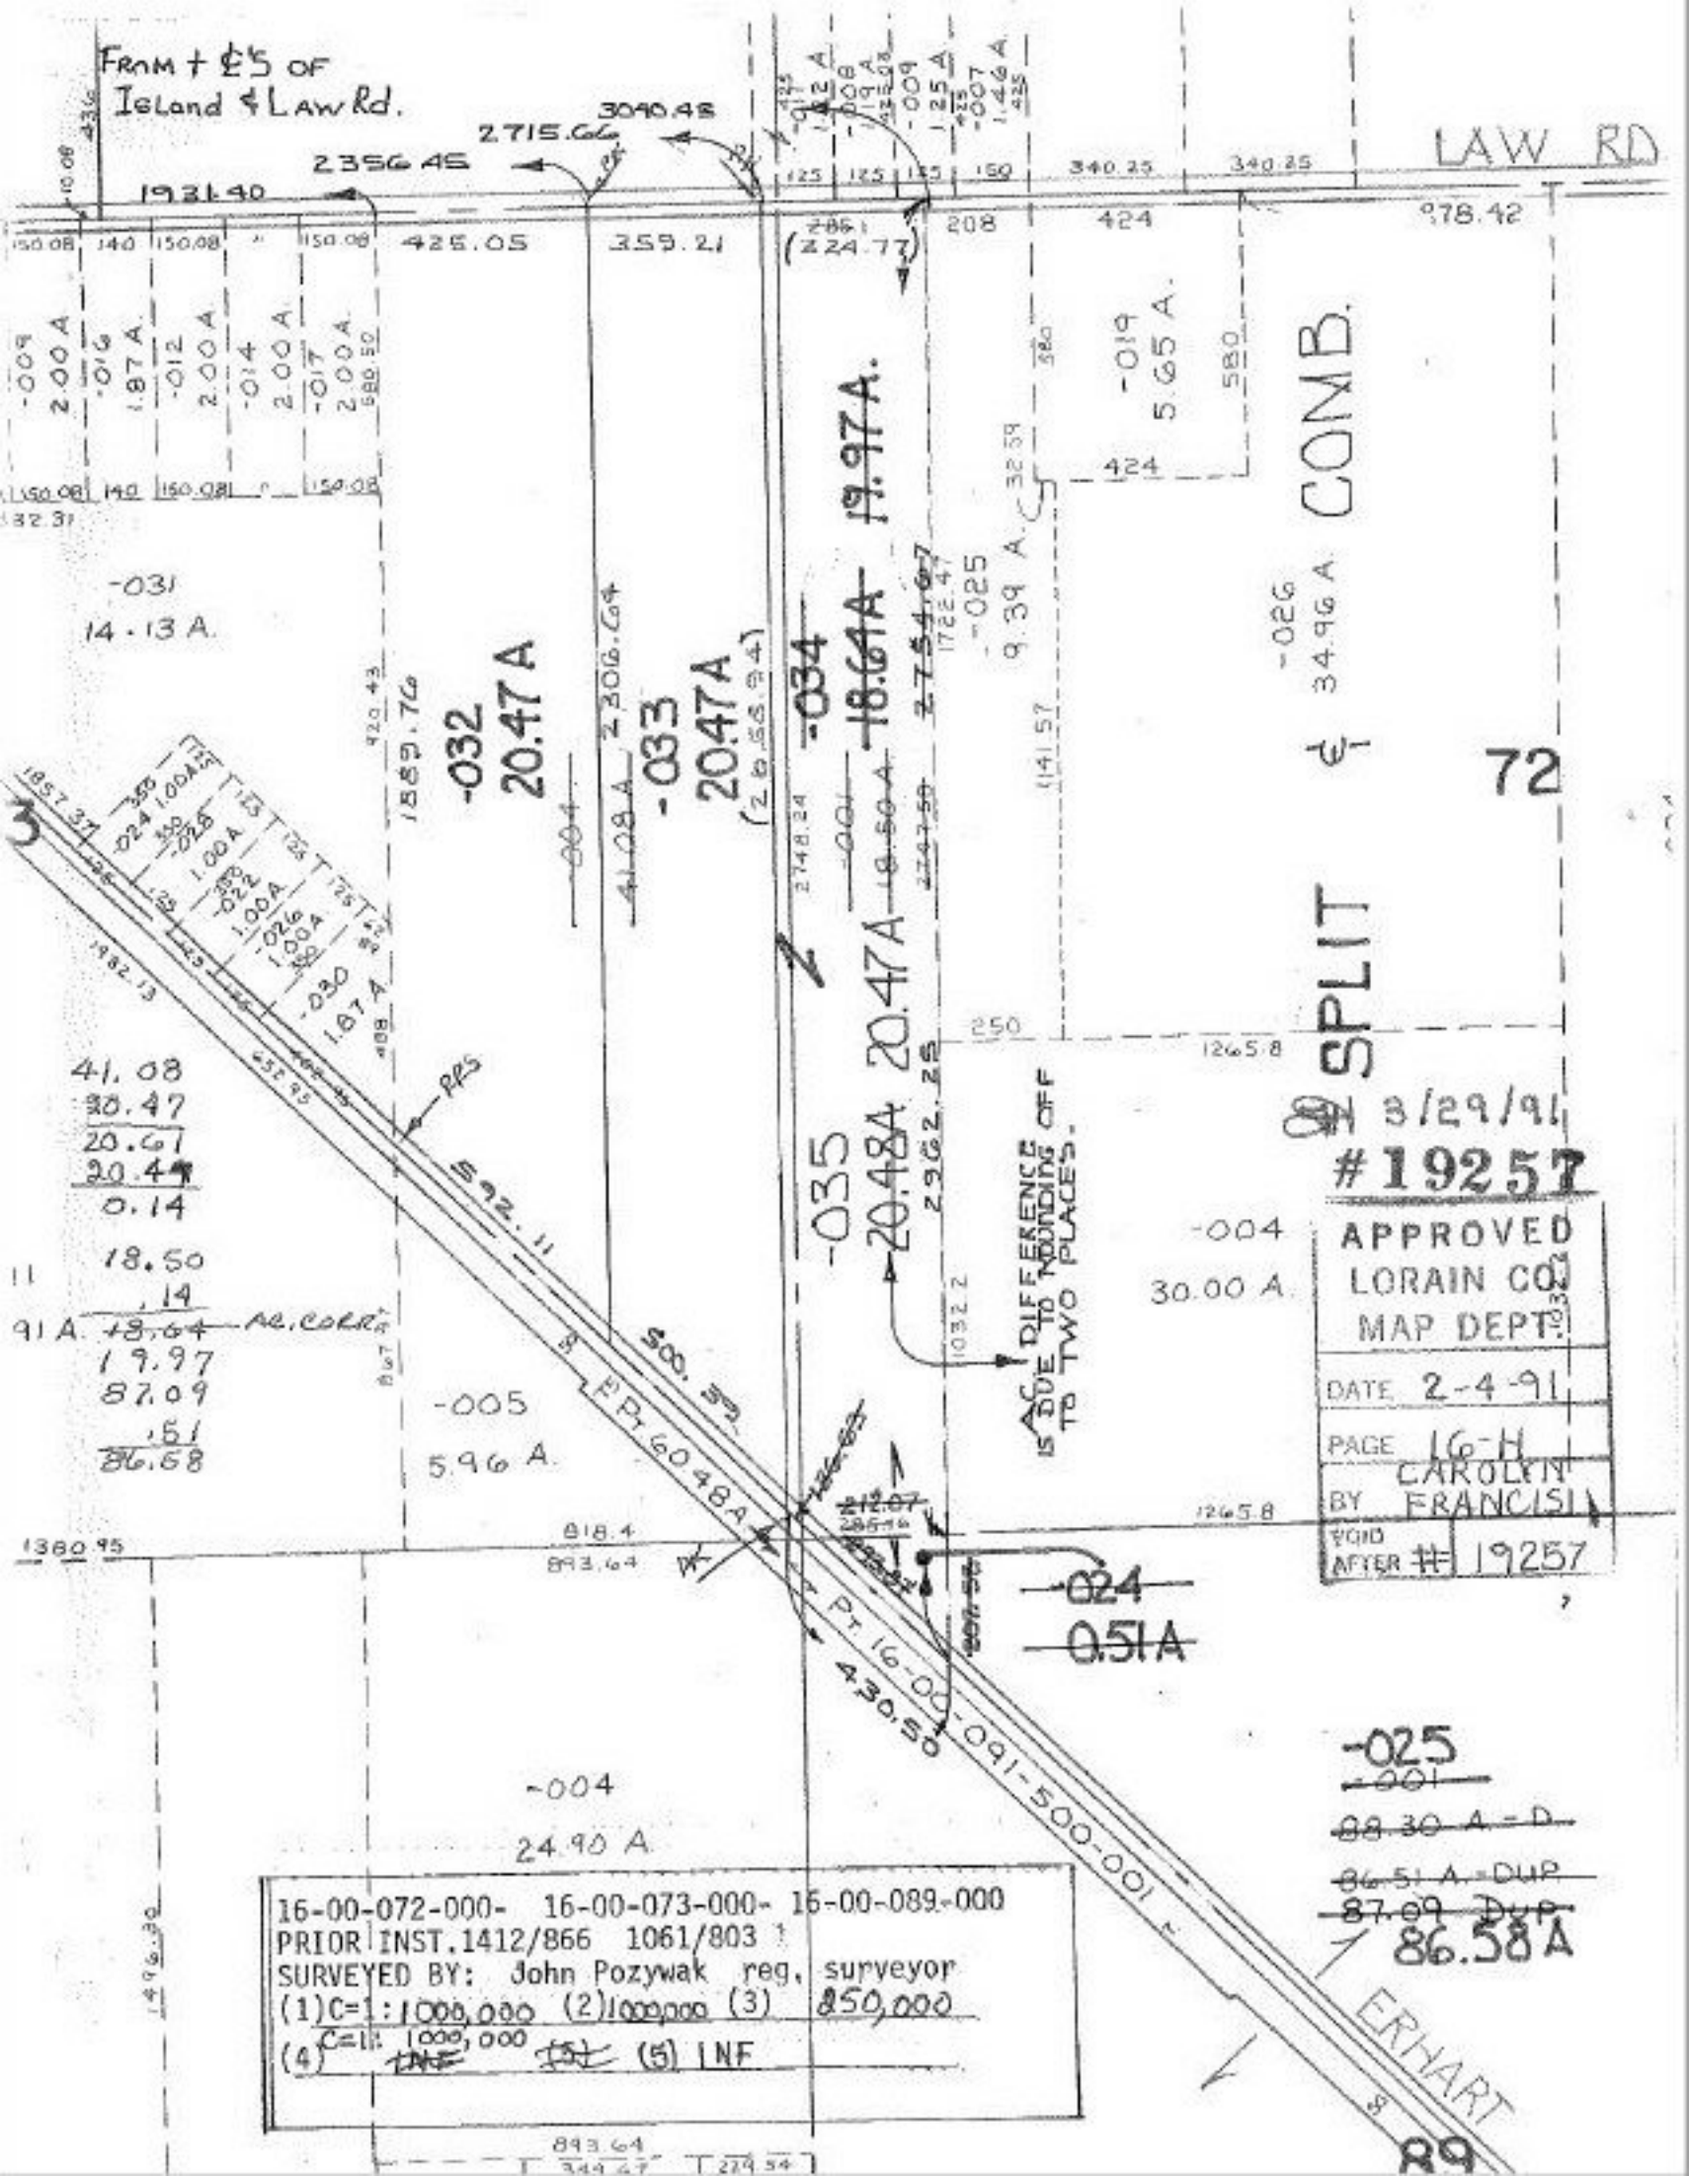

From + ℄'s of Island & Law Rd.
LAW RD
COMB.
SPLIT
72
-032 20.47 A
-033 20.47 A
-034 18.64 A 19.97 A.
-035 20.48 A 20.47 A
-019 5.65 A.
-025 9.39 A.
-026 34.96 A
-031 14.13 A.
-005 5.96 A.
-004 30.00 A.
-004 24.90 A.
-024 0.51 A
-025
88.30 A - D
86.51 A - DUP
87.09 DUP
86.58 A
AC. DIFFERENCE IS DUE TO ROUNDING OFF TO TWO PLACES.
PT. 60.48 A
PT. 16-00-091-500-001
ERHART
89
3/29/91
#19257
APPROVED
LORAIN CO.
MAP DEPT.
DATE 2-4-91
PAGE 16-H
BY CAROLYN FRANCISI
VOID AFTER # 19257
16-00-072-000- 16-00-073-000- 16-00-089-000
PRIOR INST. 1412/866 1061/803
SURVEYED BY: John Pozywak reg. surveyor
(1) C=1: 1000,000 (2) 1000,000 (3) 850,000
(4) C=1: 1000,000 (5) INF