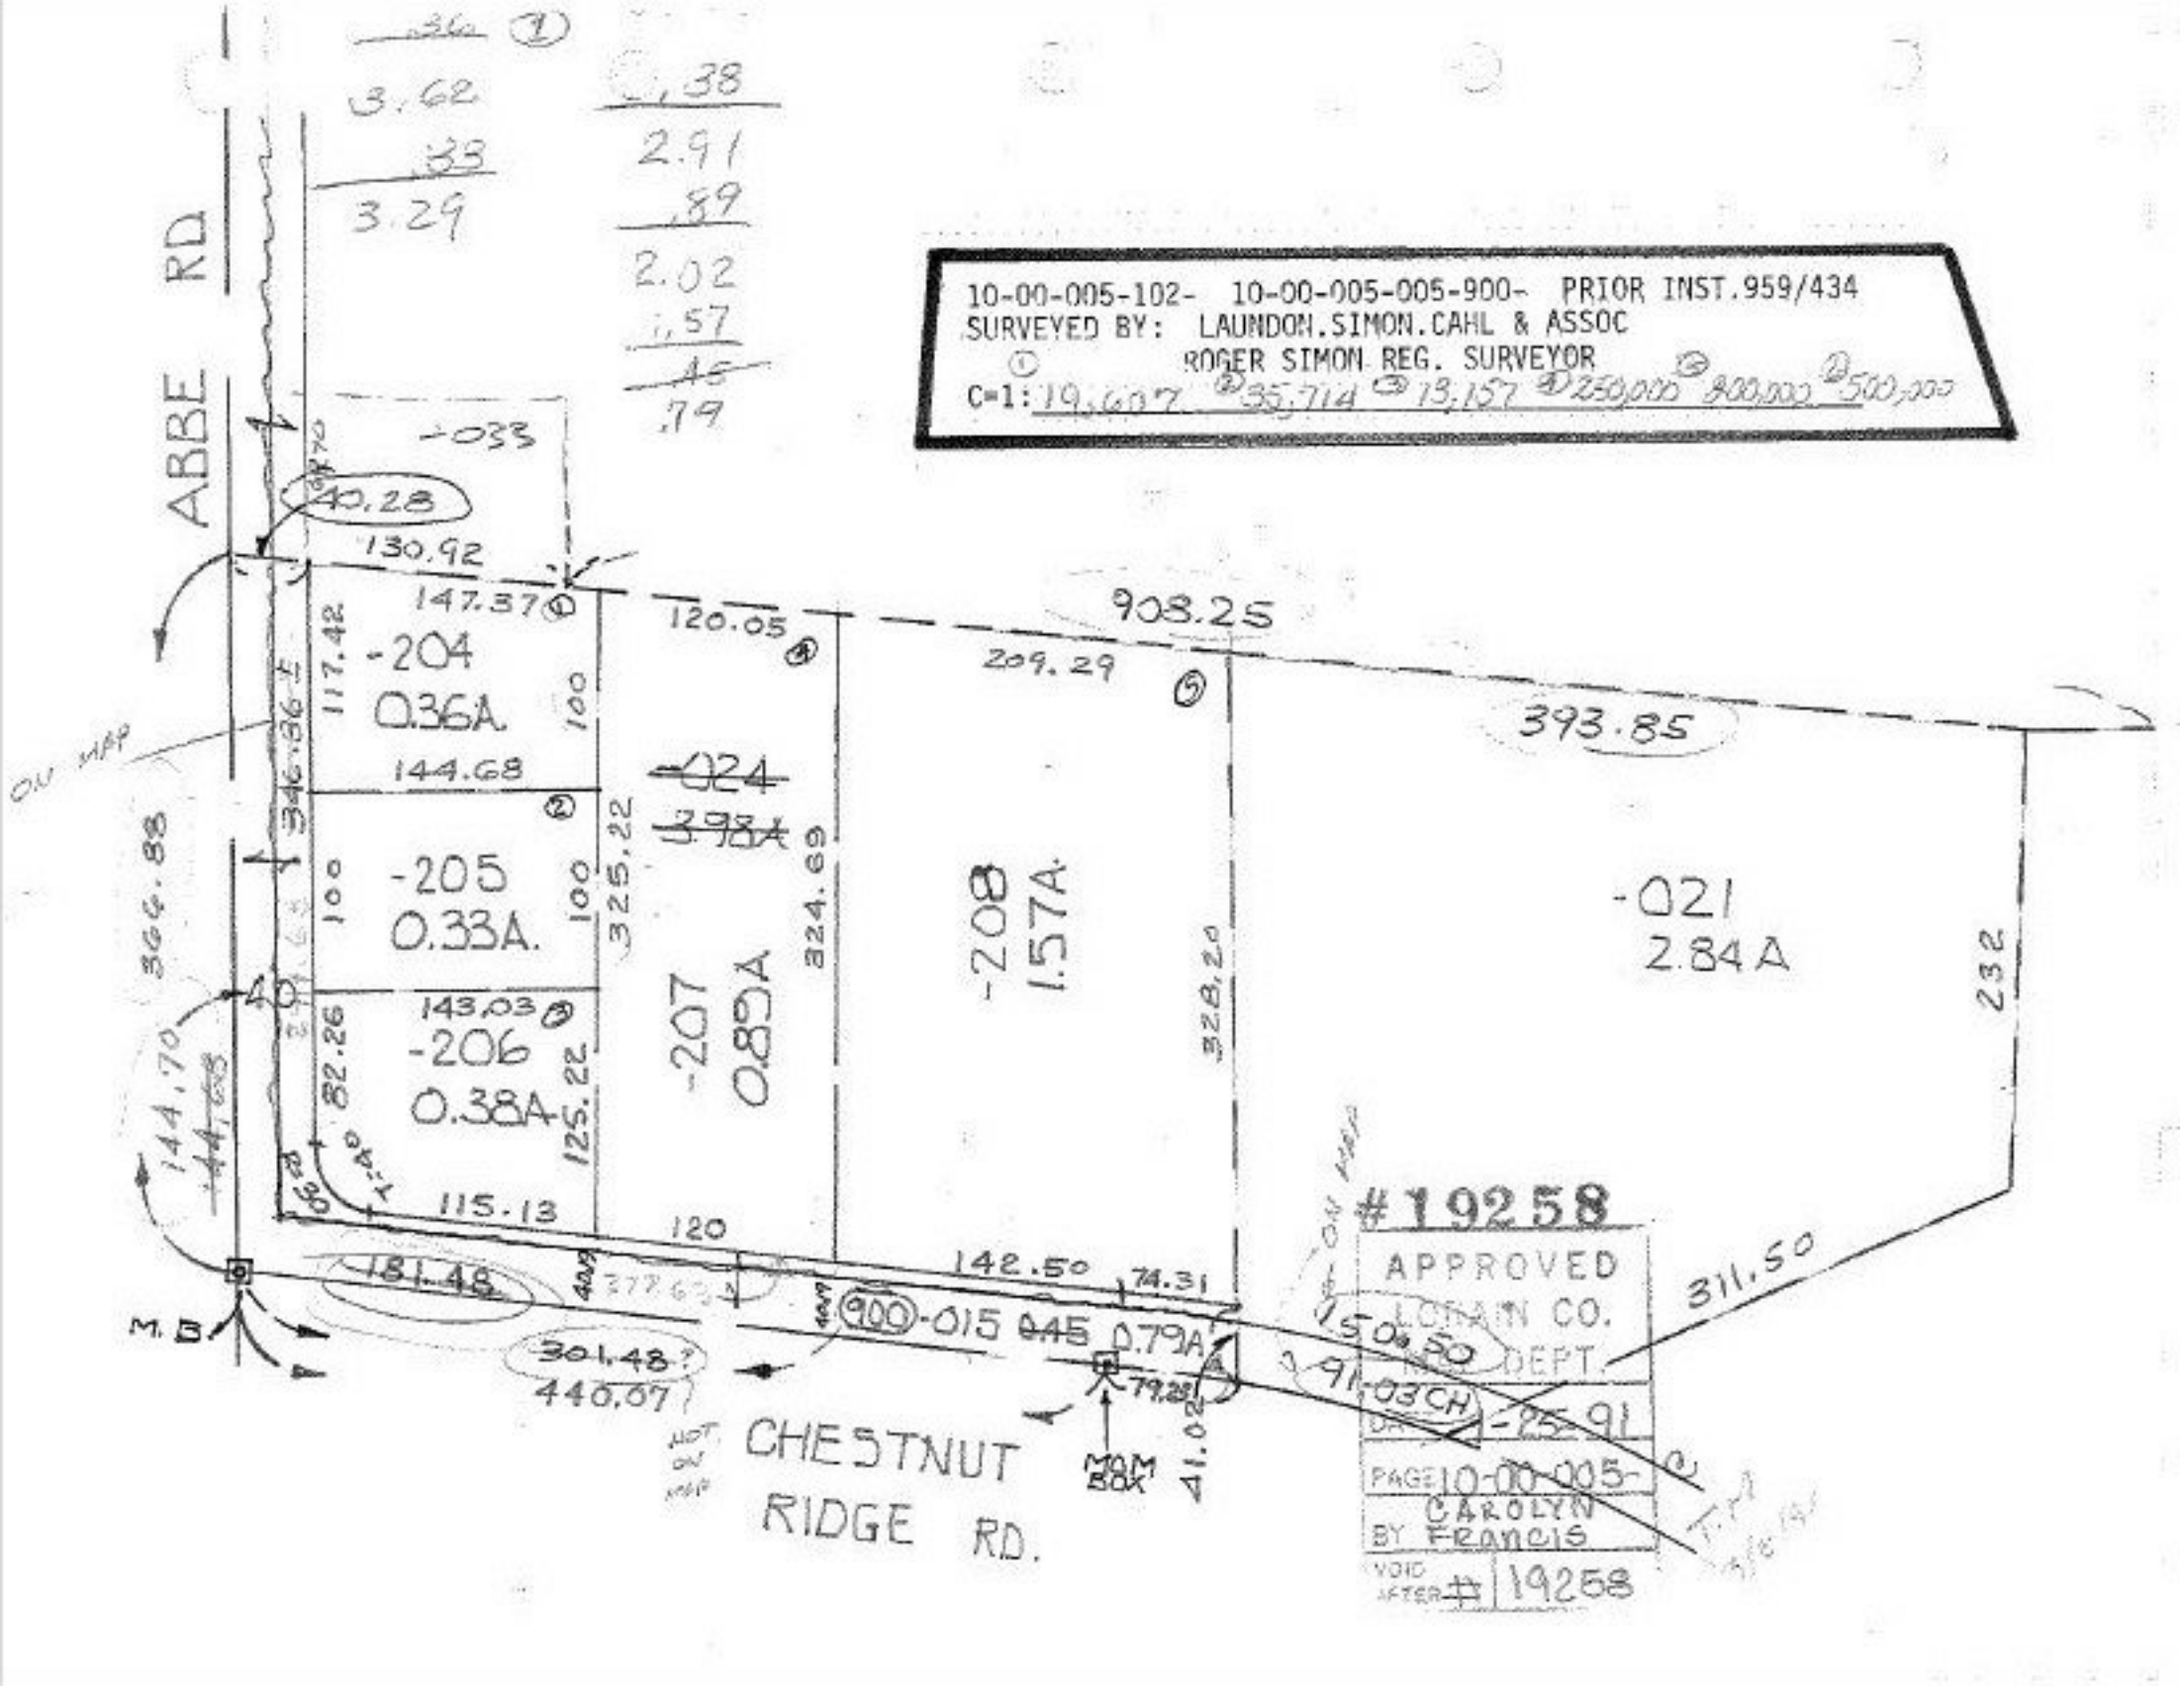

10-00-005-102- 10-00-005-005-900- PRIOR INST.959/434
SURVEYED BY: LAUNDON.SIMON.CAHL & ASSOC
ROGER SIMON REG. SURVEYOR
C=1: 19,607 35,714 13,157 250,000 800,000 500,000
ABBE RD
CHESTNUT RIDGE RD.
-204 0.36A.
-205 0.33A.
-206 0.38A
-207 0.89A
-208 1.57A
-021 2.84A
-024 3.98A
900-015 0.45 0.79A
-033
40.28
130.92
147.37
120.05
908.25
209.29
393.85
117.42
100
144.68
325.22
324.69
328.20
232
366.88
143.03
82.26
125.22
115.13
120
142.50
74.31
181.48
301.48
440.07
79.28
41.02
311.50
M.B.
MAIL BOX
ON MAP
NOT ON MAP
#19258
APPROVED
LORAIN CO.
DEPT.
-25-91
PAGE 10-00-005-
BY CAROLYN FRANCIS
VOID AFTER # 19258