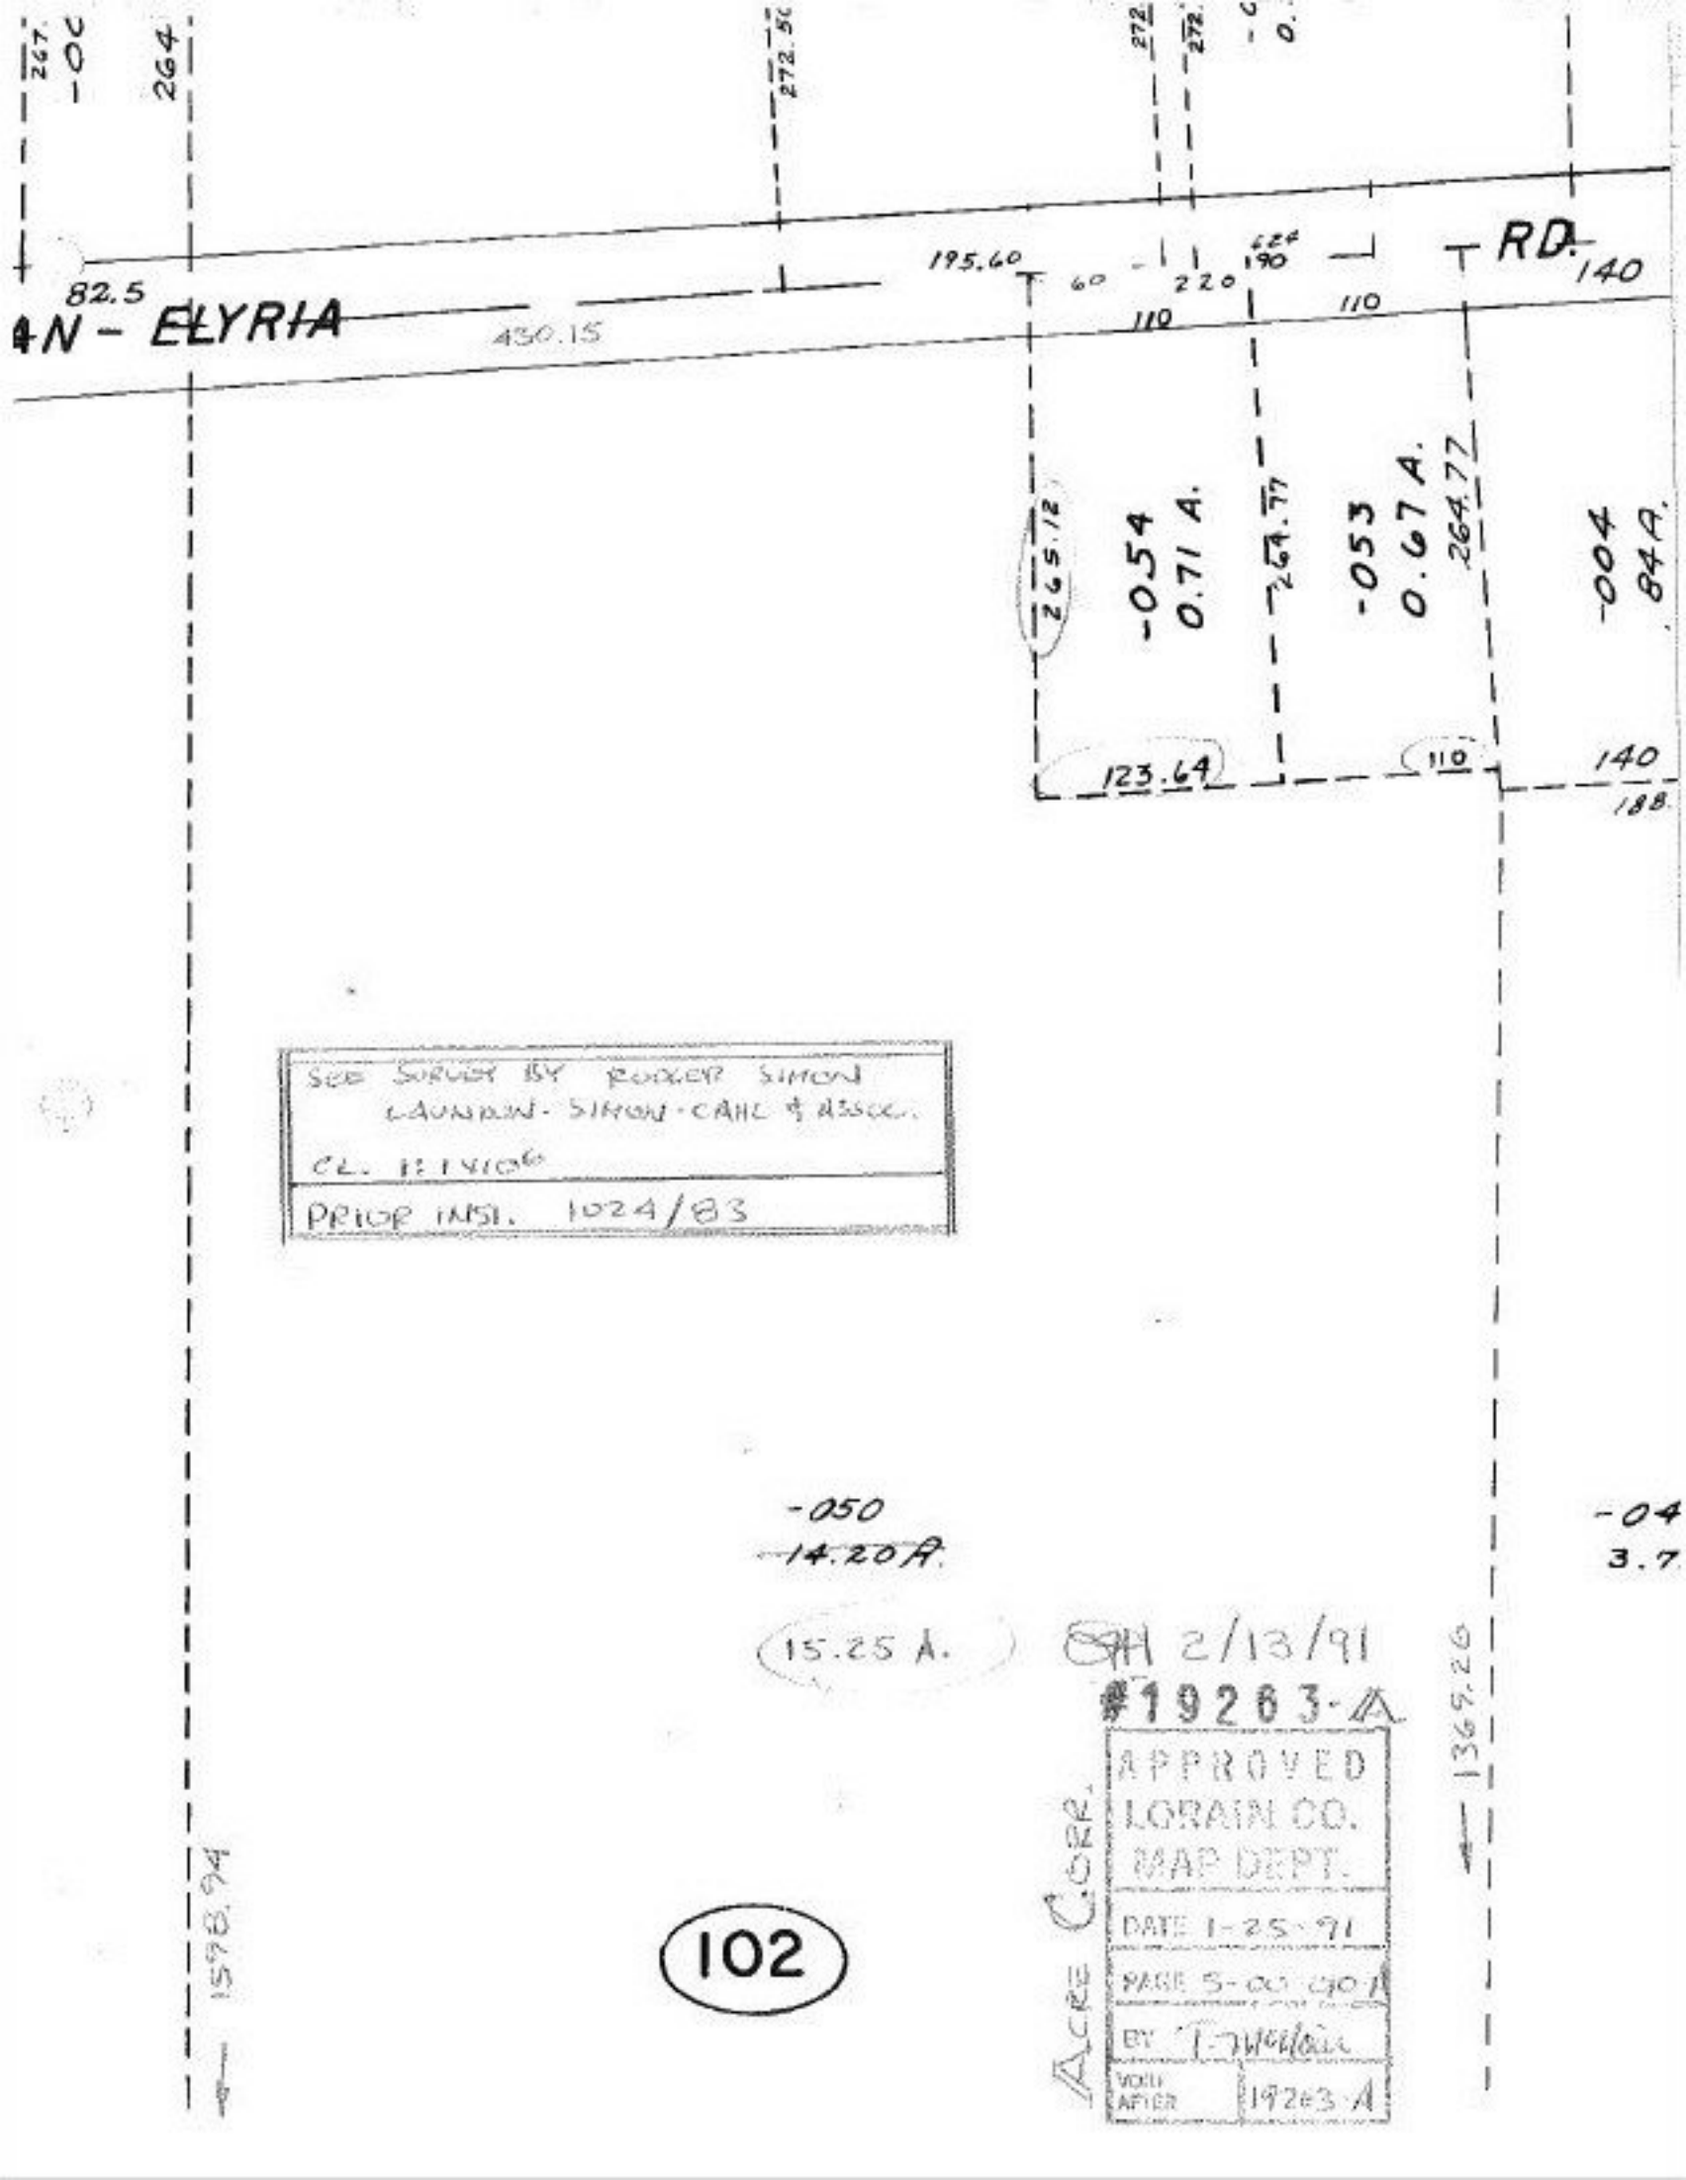

267
-00
264
272.50
272
272
82.5
N - ELYRIA
430.15
195.60
60
220
624
190
110
110
RD.
140
265.12
-054
0.71 A.
264.77
-053
0.67 A.
264.77
-004
.84 A.
123.64
110
140
188
SEE SURVEY BY RODGER SIMON
LAUNDON - SIMON - CAHL & ASSOC.
CL. 1:1 X 10^6
PRIOR INST. 1024/83
-050
14.20 A.
15.25 A.
-04
3.7
1369.26
1598.94
102
ACRE CORR.
2/13/91
#19263-A
APPROVED
LORAIN CO.
MAP DEPT.
DATE 1-25-91
PAGE 5-00-90-A
BY
VOID AFTER
19263-A