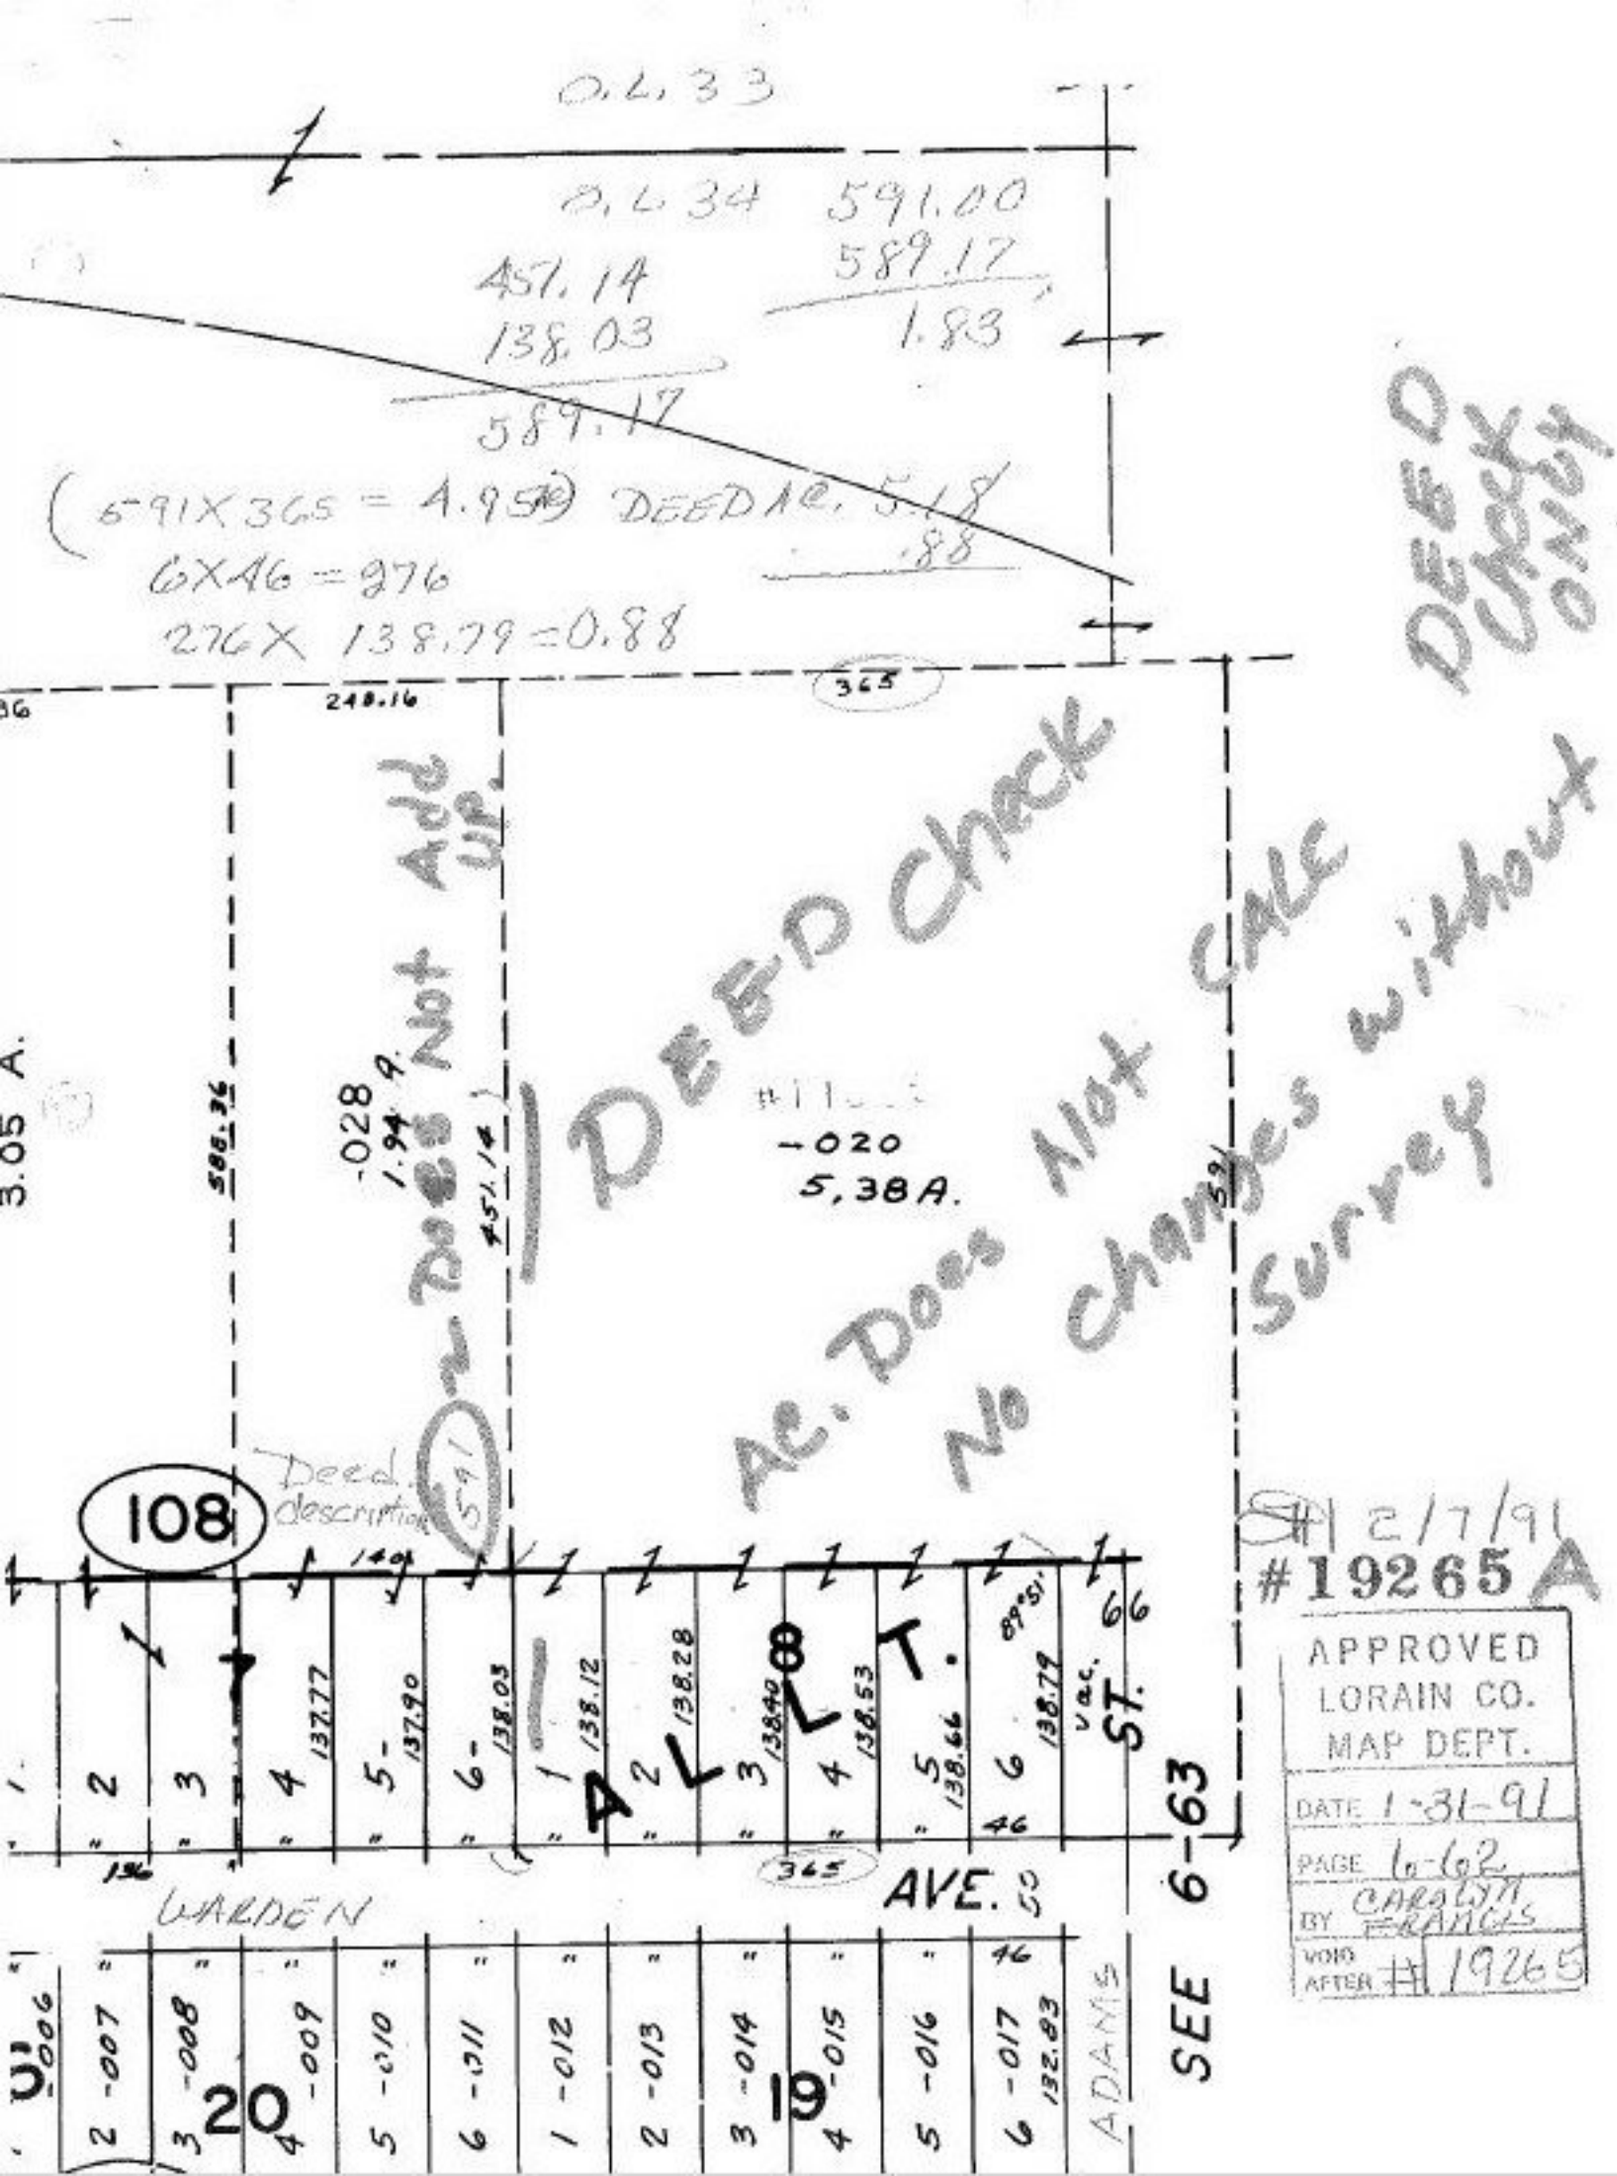
O.L. 33
O.L. 34
591.00
589.17
1.83
457.14
138.03
589.17
(591 X 365 = 1.95 DEED 1.83
.88
6 X 46 = 276
276 X 138.79 = 0.88
365
248.16
588.36
457.14
-028
1.94 9.
-020
5.38A.
3.05 A.
Our Rec Not Add Up
DEED Check
AC. Does Not CALC
No changes without Survey
DEED Check ONLY
Deed description
108
149
591
1
2
3
4 137.77
5 137.90
6 138.05
1 138.12
2 138.28
3 138.40
4 138.53
5 138.66
6 138.79
99.51
Vac. ST.
66
46
136
365
WARDEN
AVE.
50
SEE 6-63
2/7/91
#19265 A
APPROVED
LORAIN CO.
MAP DEPT.
DATE 1-31-91
PAGE 6-62
BY CAROLYN FRANCIS
VOID AFTER # 19265
006
2 -007
3 -008
20
4 -009
5 -010
6 -011
1 -012
2 -013
3 -014
19
4 -015
5 -016
6 -017
132.83
ADAMS