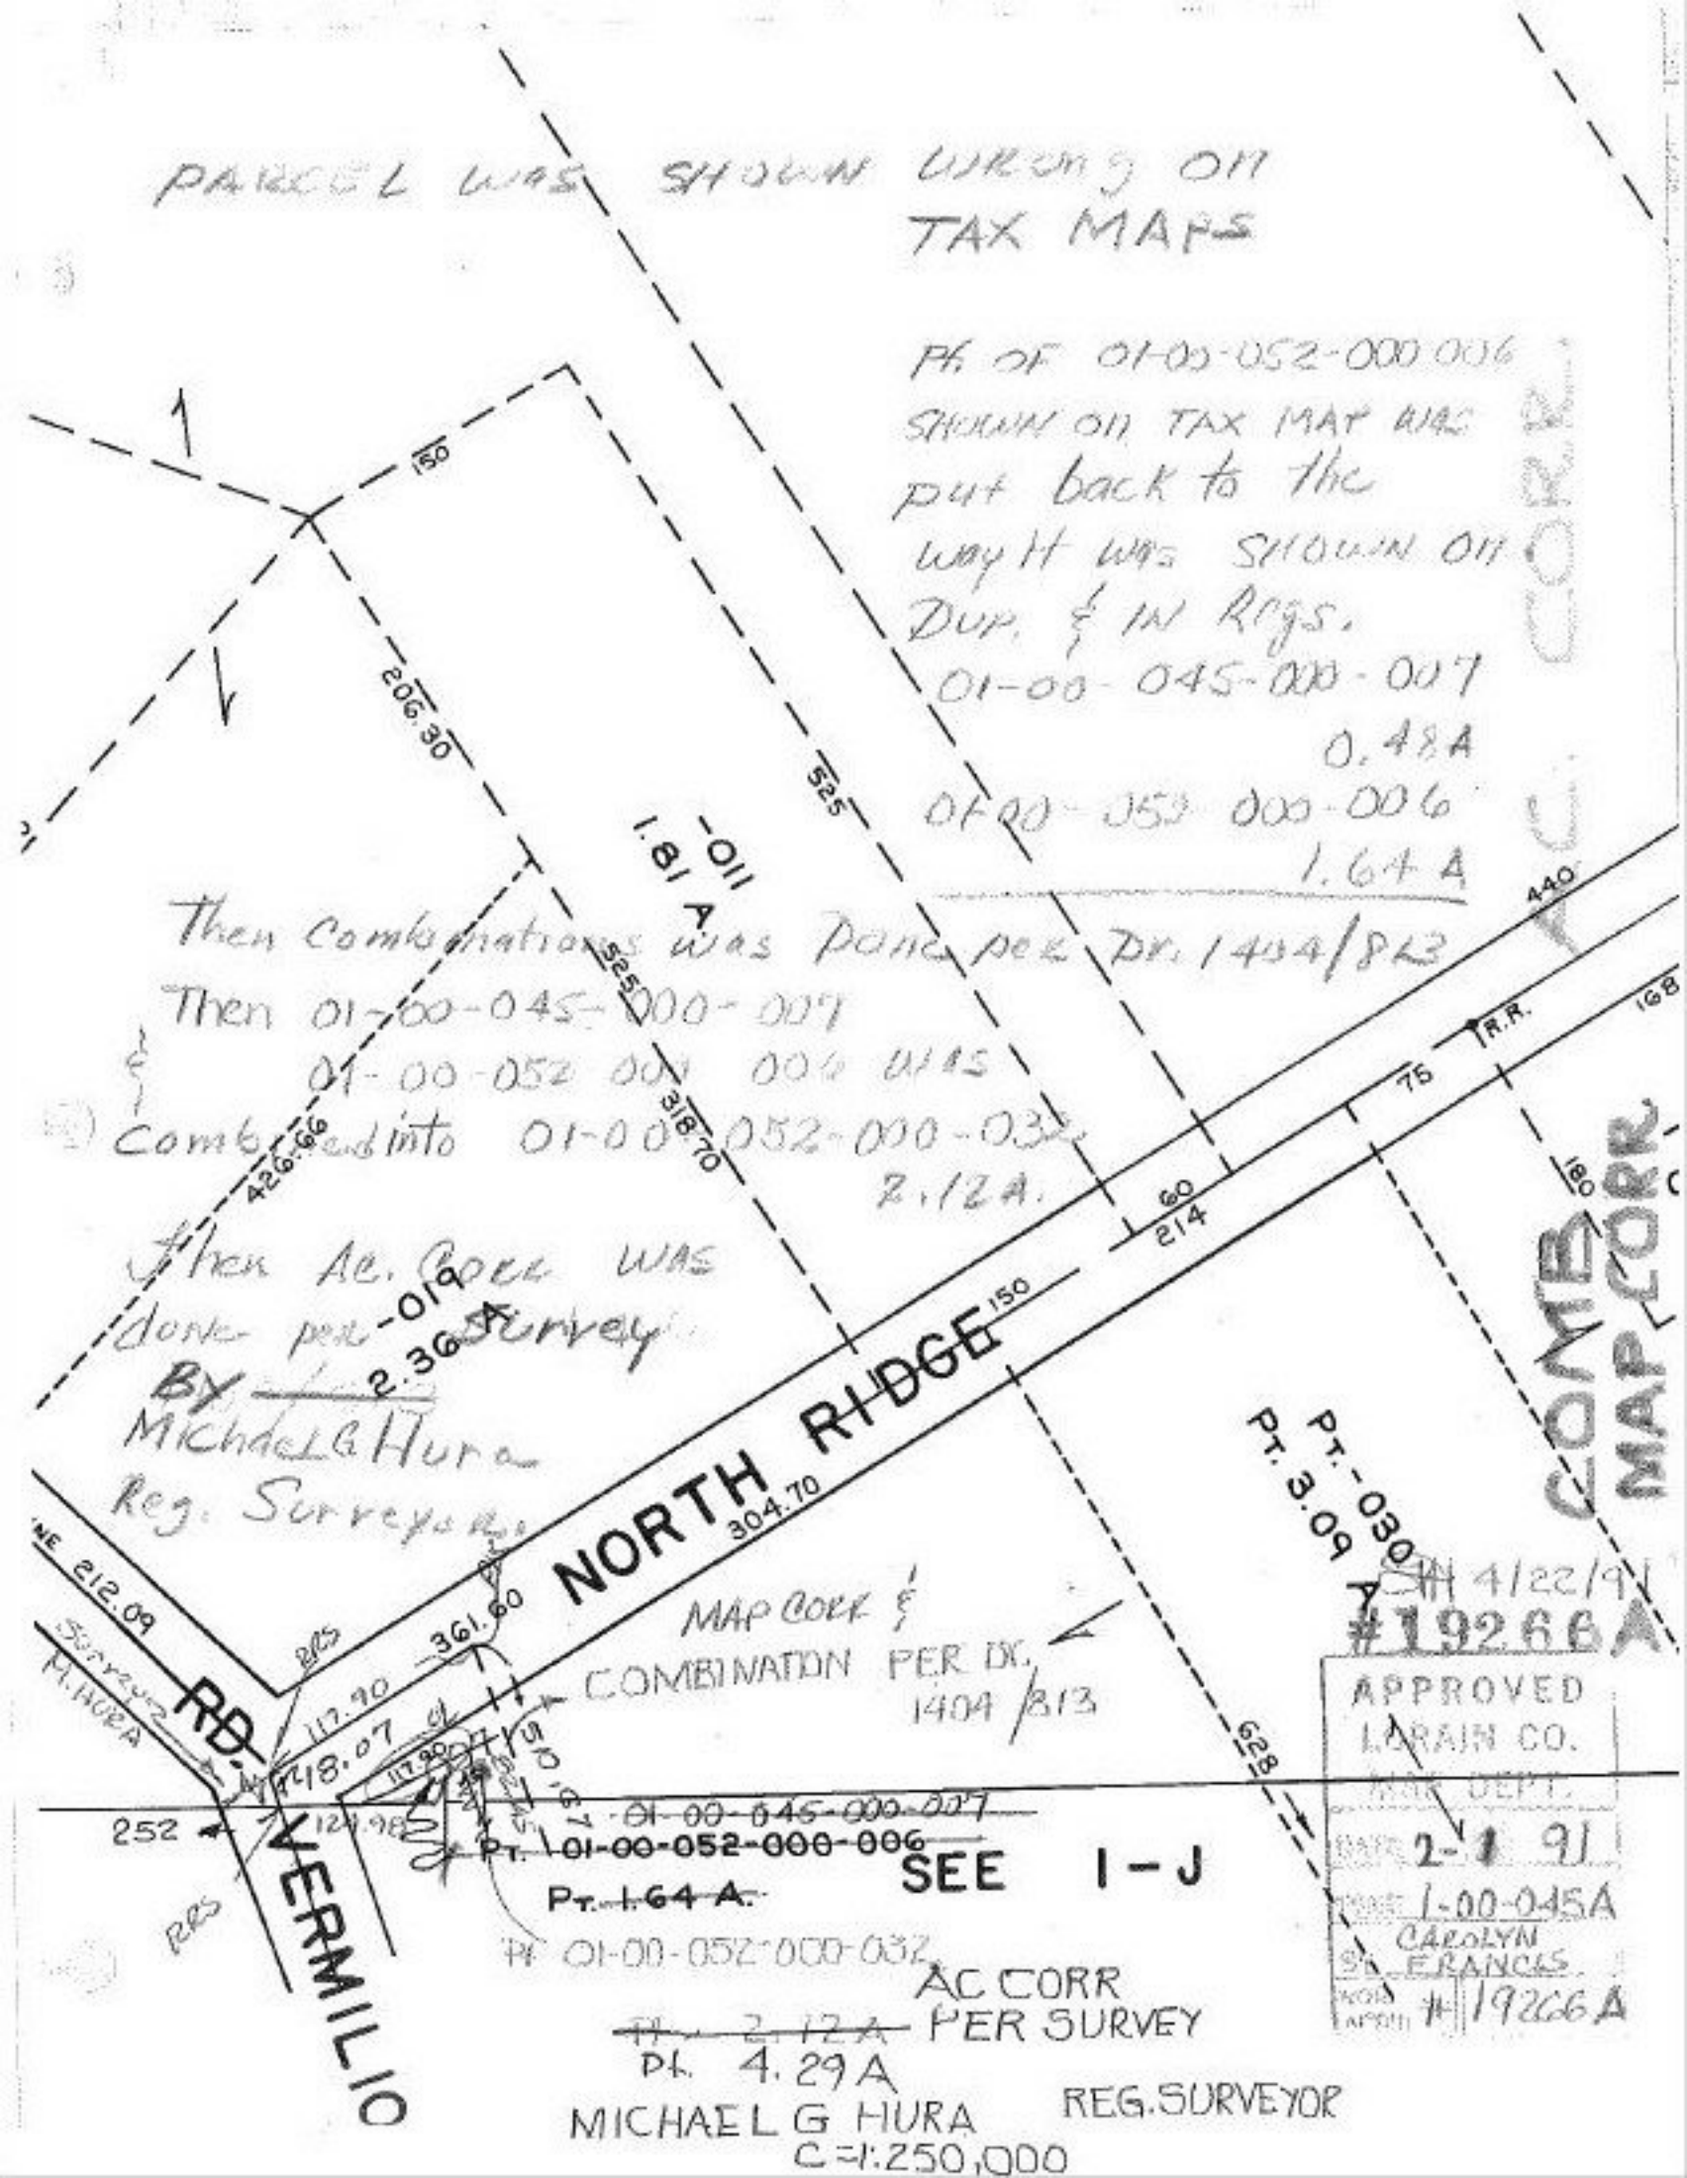

PARCEL WAS SHOWN WRONG ON TAX MAPS

Pt. OF 01-00-052-000-006 SHOWN ON TAX MAP WAS put back to the way it was SHOWN ON Dup. & IN Regs.

01-00-045-000-007
0.48A

01-00-052-000-006
1.64 A

Then Combinations was Done per Dr. 1404/813

Then 01-00-045-000-007
& 01-00-052-000-006 WAS
Combined into 01-00-052-000-032
2.12A.

Then Ac. Corr WAS done per Survey
BY
Michael G Hura
Reg. Surveyor

MAP CORR &
COMBINATION PER DR.
1404/813

SEE I-J

Pt. 01-00-045-000-007
Pt. 01-00-052-000-006
Pt. 1.64 A.
Pt. 01-00-052-000-032
Pt. 2.12 A
Pt. 4.29 A

AC CORR
PER SURVEY

MICHAEL G HURA REG. SURVEYOR
C=1:250,000

SH 4/22/91
#19266A

APPROVED
LORAIN CO.
MAP DEPT.
DATE 2-1 91
PAGE 1-00-045A
CAROLYN
ST. FRANCIS
NOR APPD # 19266A

COMB
MAP CORR
AC CORR

NORTH RIDGE
RD. VERMILIO
-011
1.81 A
-019
2.36 A
-030
Pt. 3.09 A
R.R.
150
206.30
525
440
168
75
60
214
180
426.66
318.70
304.70
361.60
212.09
117.90
118.07
124.98
510.67
628
252
RRS
Surveyor
M. HURA