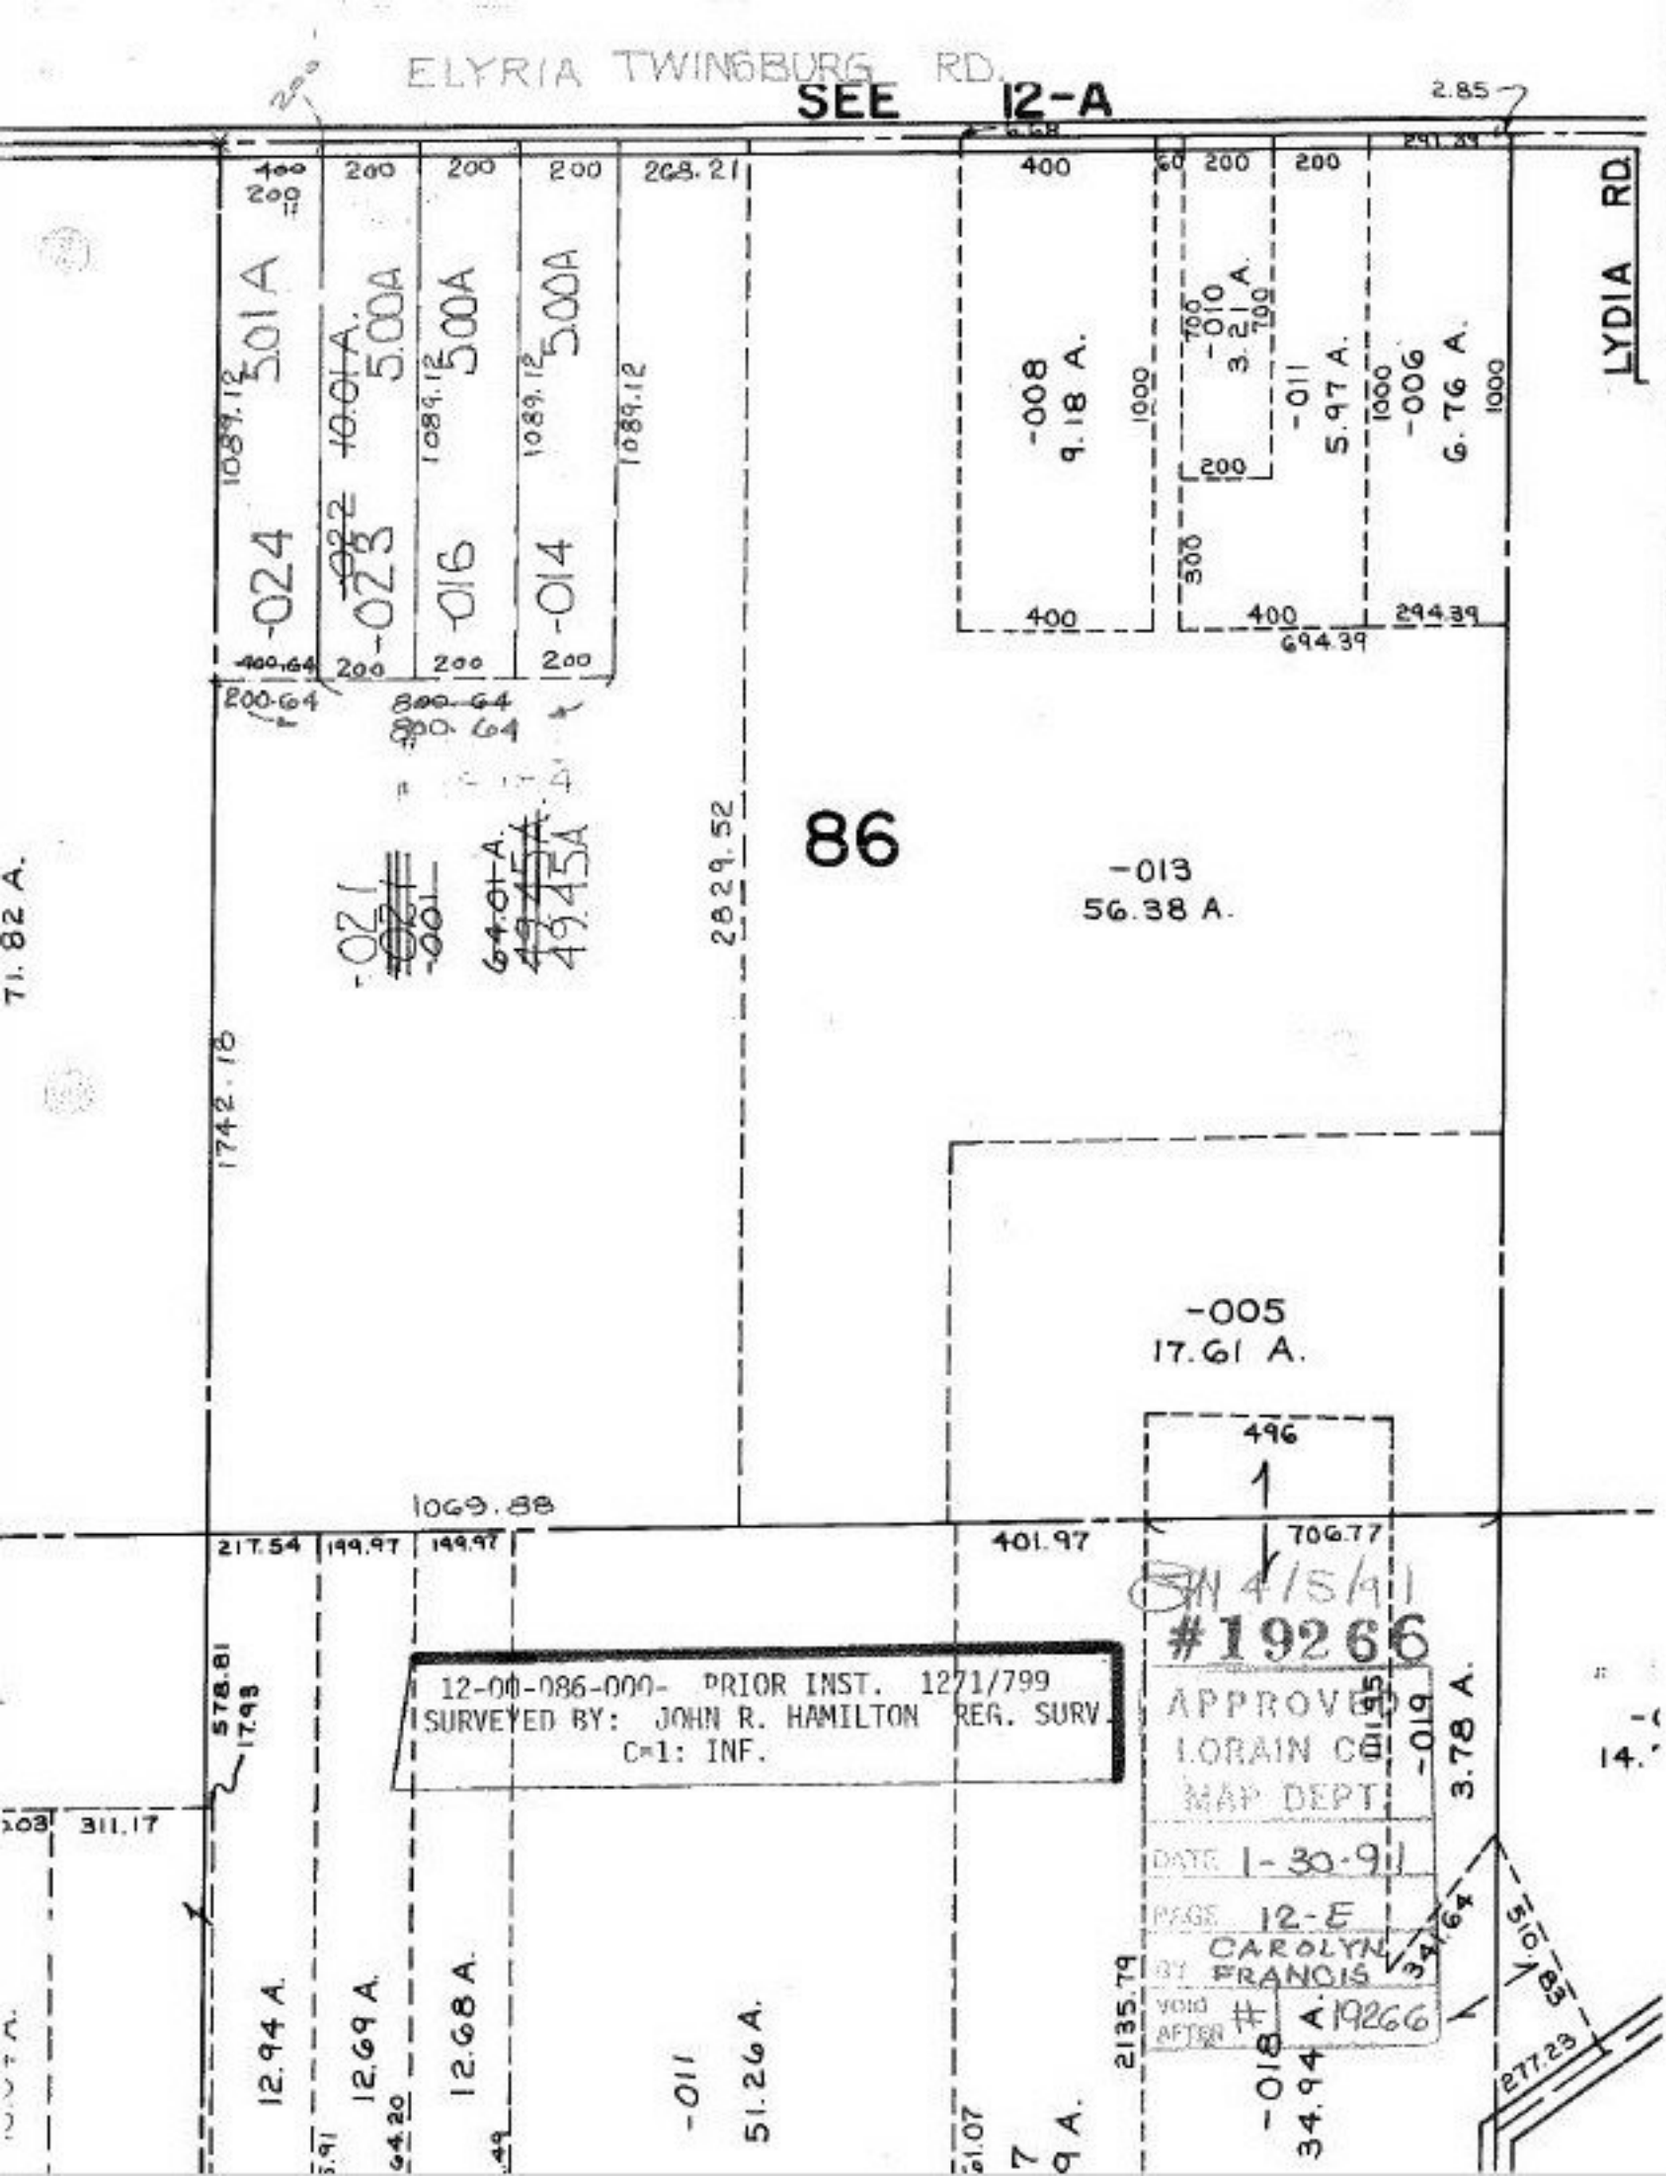
ELYRIA TWINSBURG RD.
SEE 12-A
LYDIA RD.
86
-024
-023
-016
-014
-021
-013
56.38 A.
-008
9.18 A.
-010
3.21 A.
-011
5.97 A.
-006
6.76 A.
-005
17.61 A.
-019
3.78 A.
-018
34.94 A.
12.94 A.
12.69 A.
12.68 A.
51.26 A.
71.82 A.
1742.18
2829.52
1069.88
401.97
706.77
2135.79
510.85
277.23
12-00-086-000- PRIOR INST. 1271/799
SURVEYED BY: JOHN R. HAMILTON REG. SURV.
C=1: INF.
#19266
APPROVED
LORAIN CO.
MAP DEPT.
DATE 1-30-91
PAGE 12-E
CAROLYN
BY FRANCIS
VOID AFTER # A19266