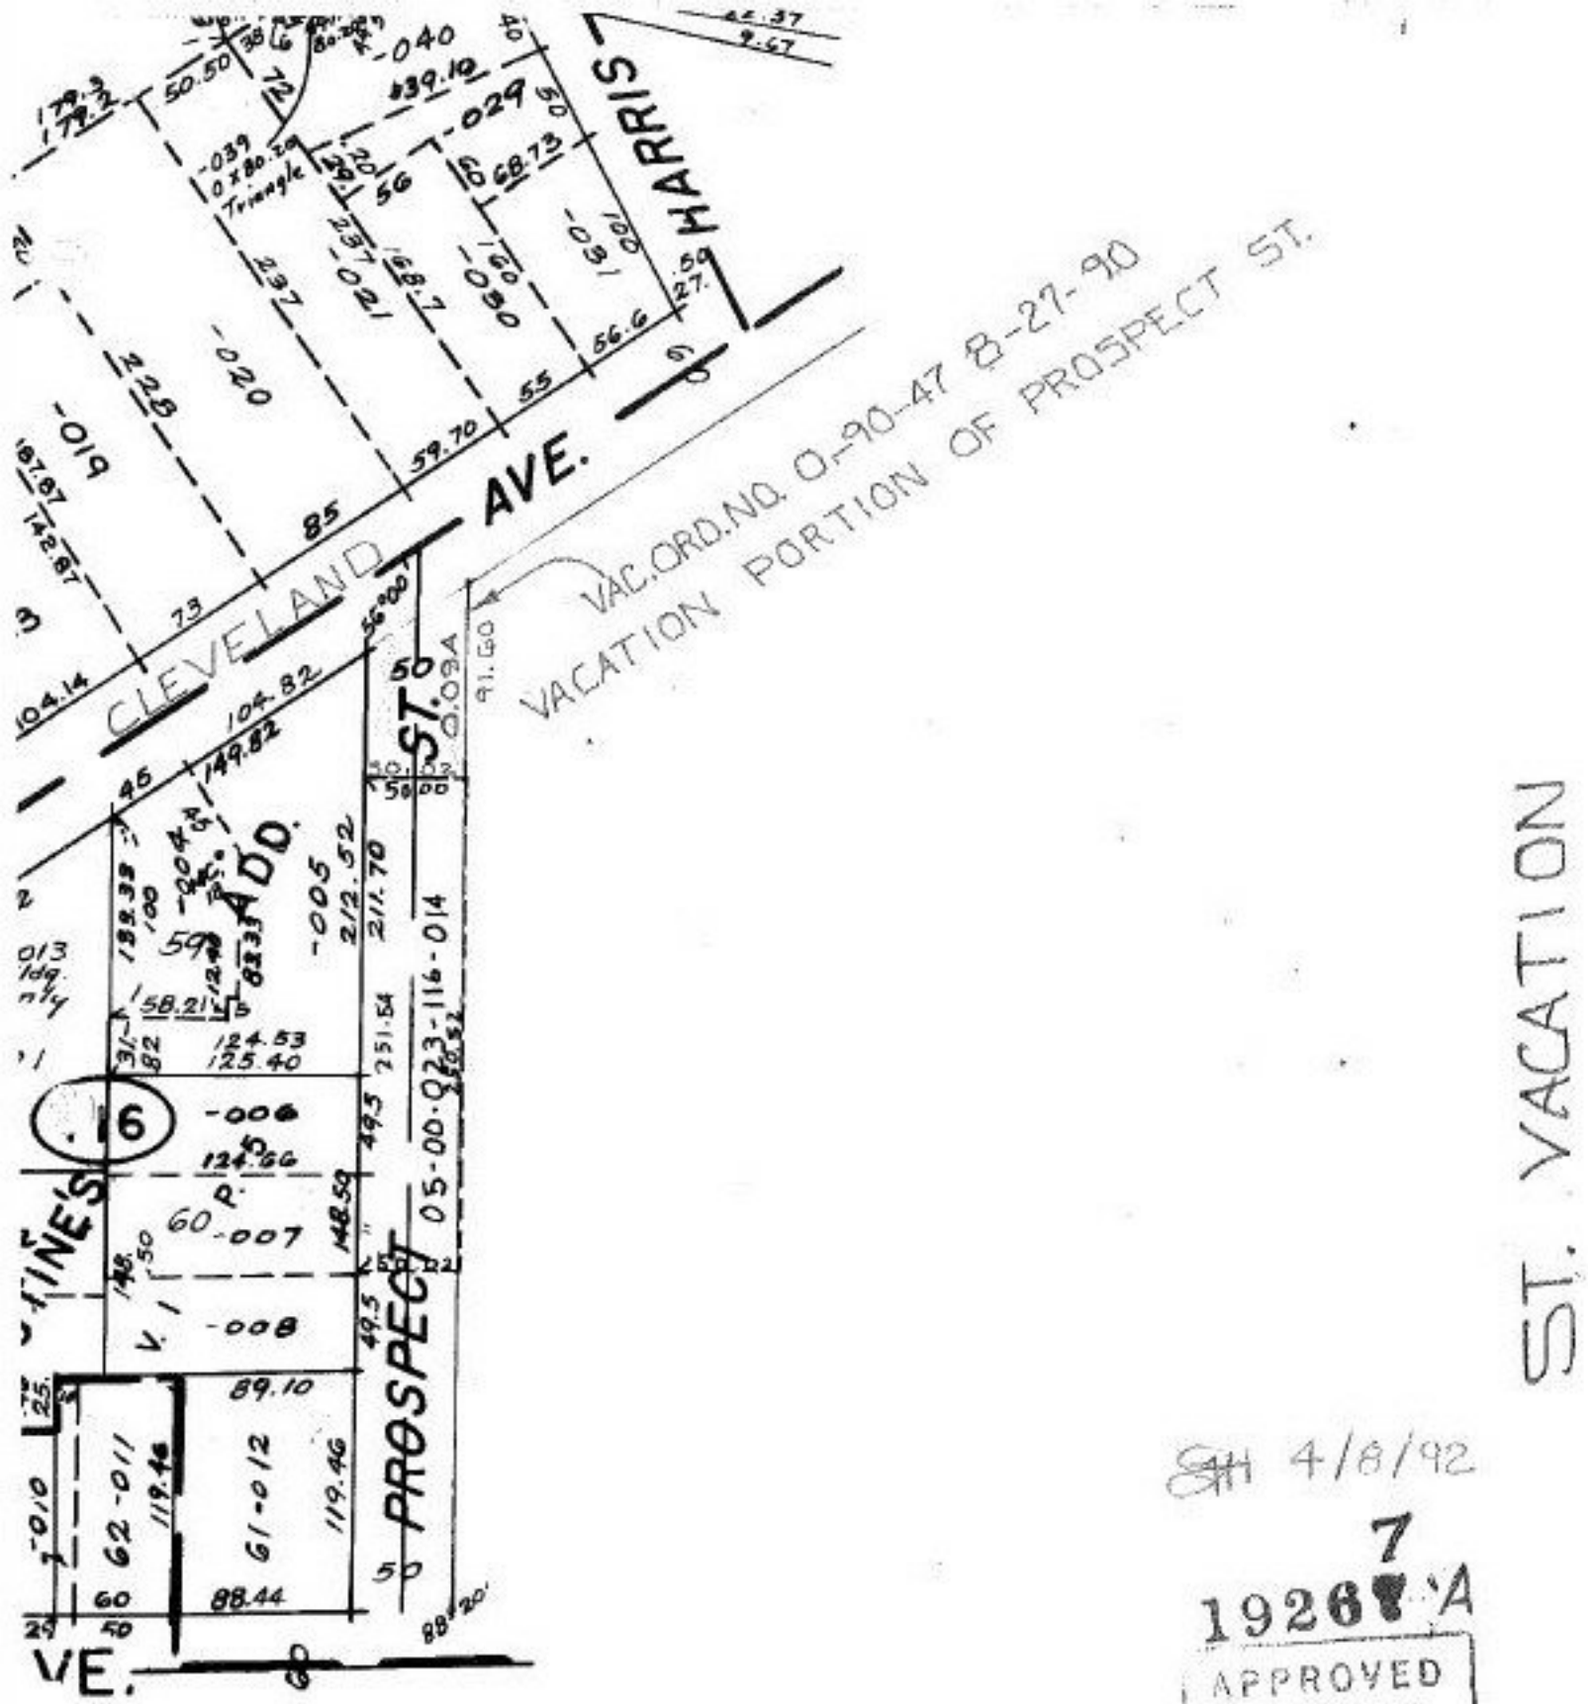


SH 4/8/92

7

19267-A

APPROVED
LORAIN CO.
MAP DEPT.

DATE 12-31-91

PAGE 5-00-023-A

BY CAROLYN FRANCIS

VOID AFTER # 19267-A

5-00-023-A