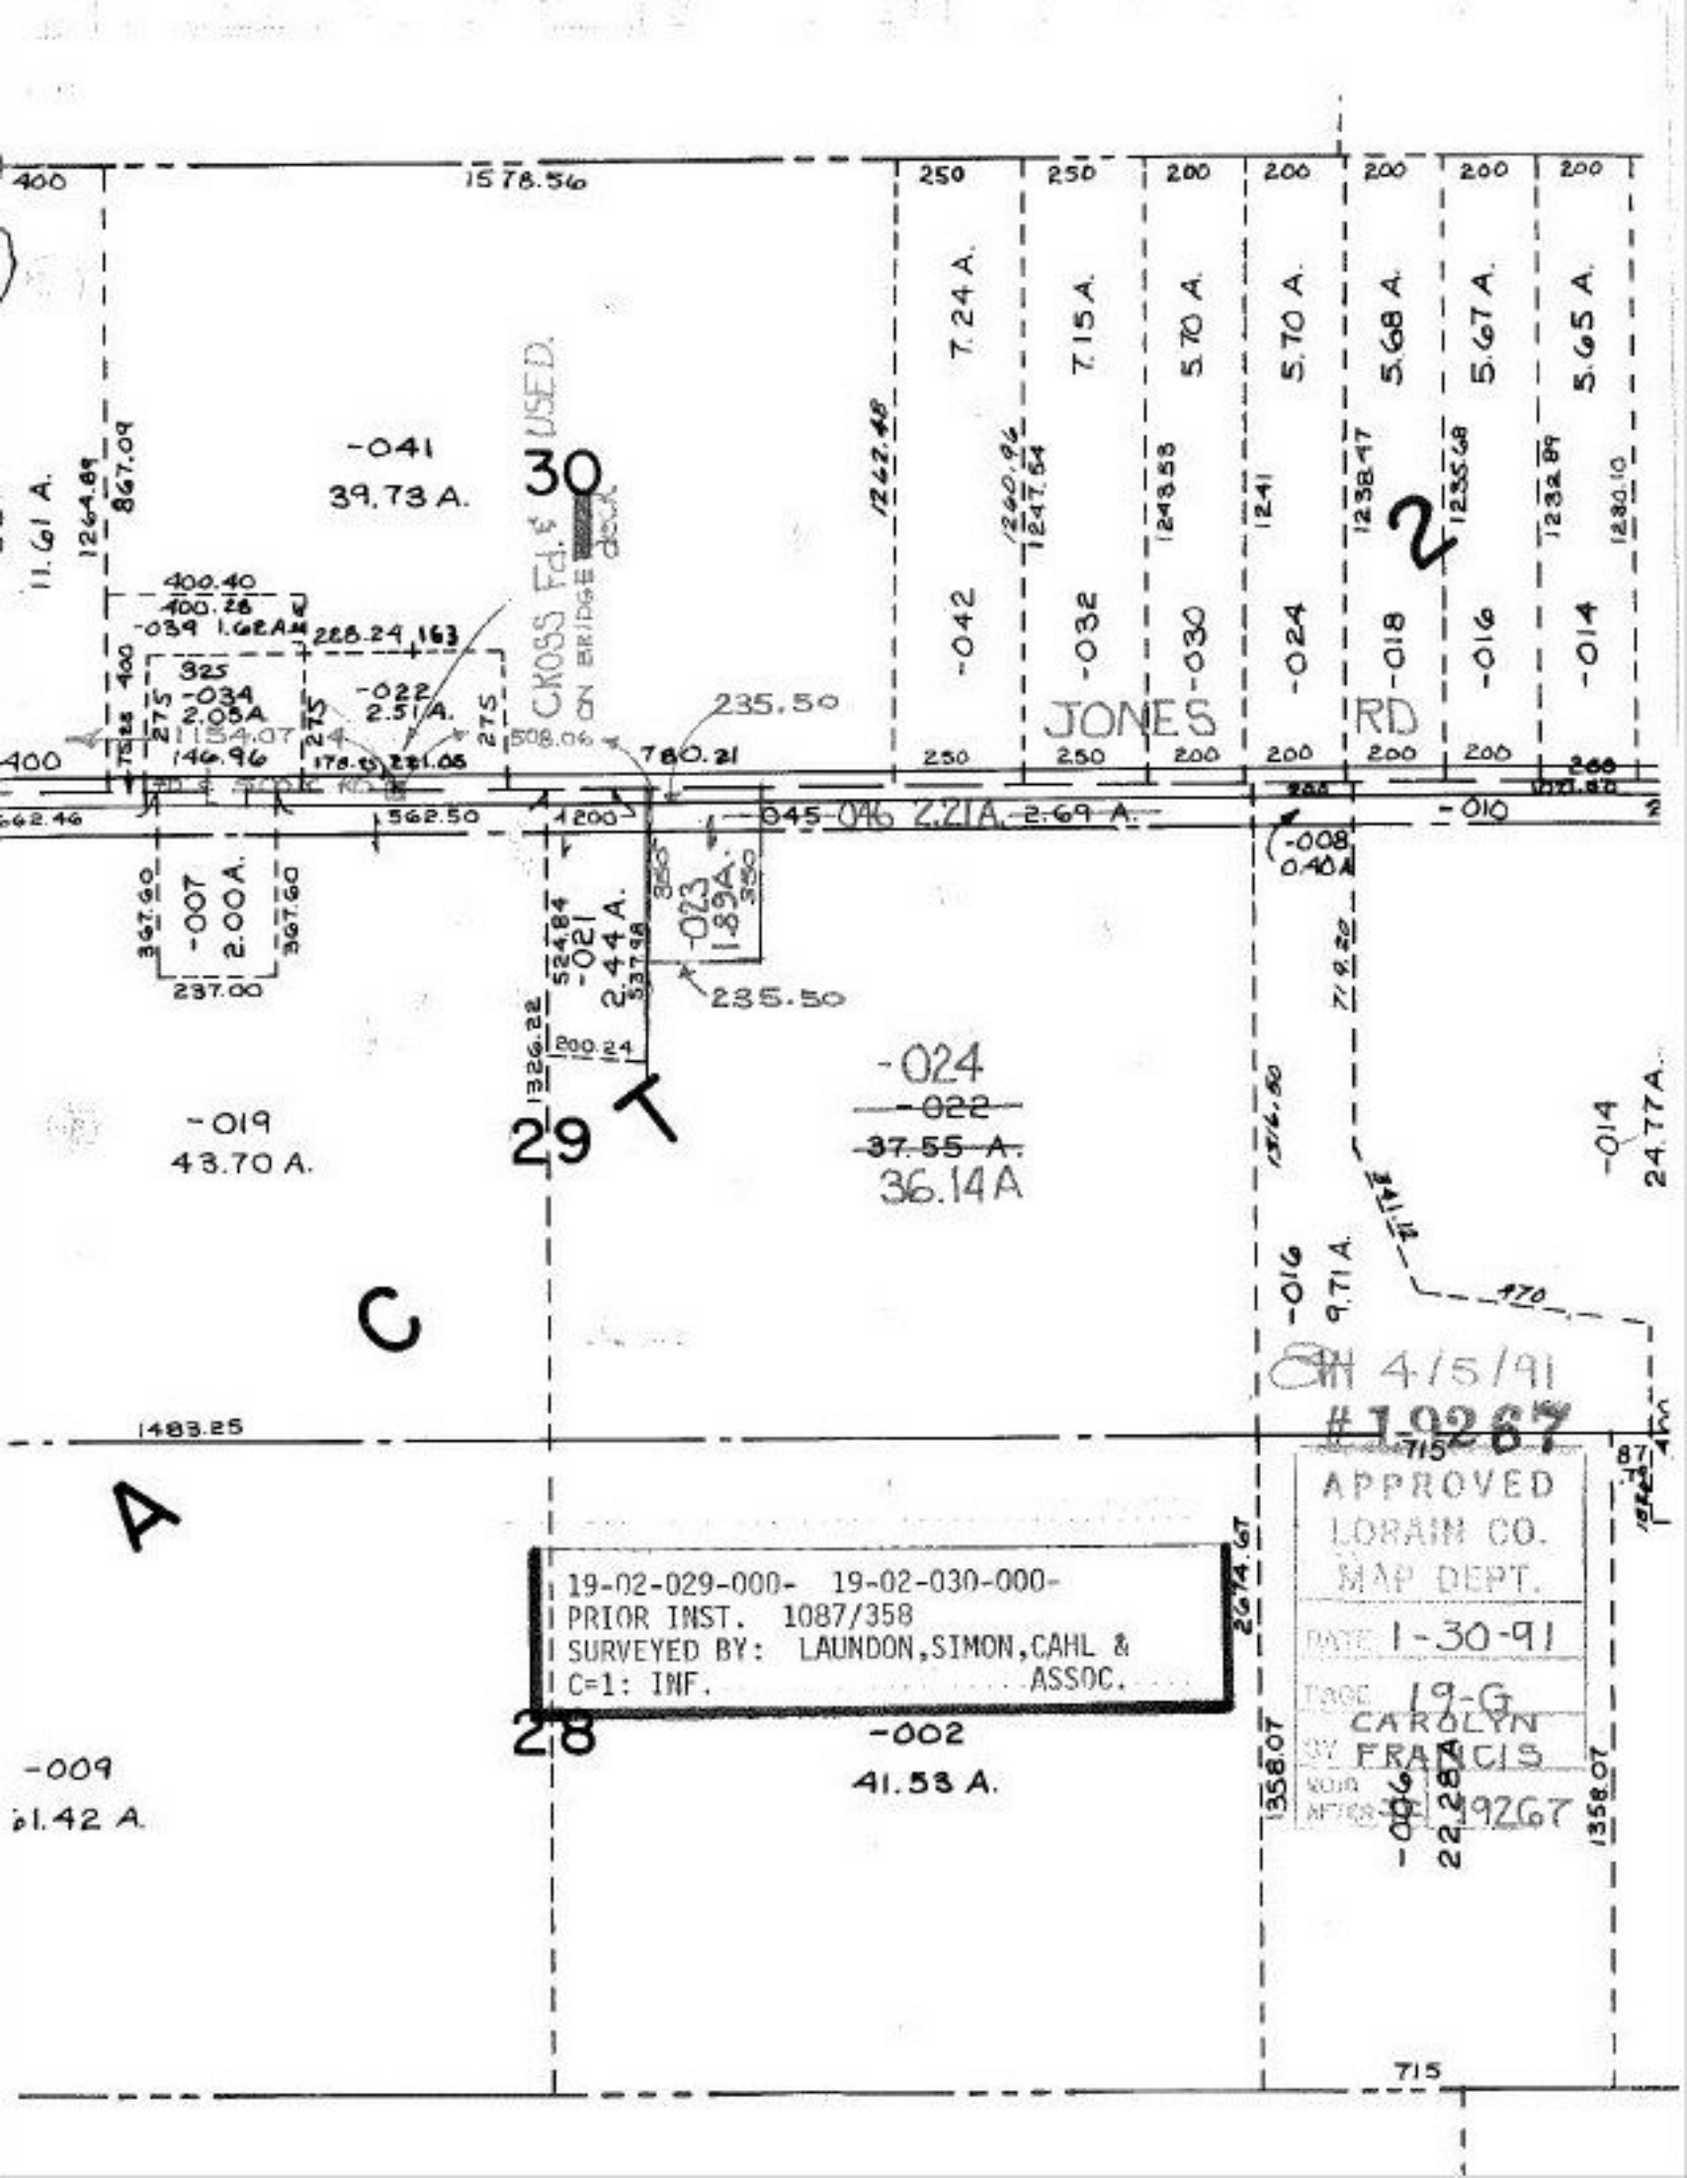

1578.56
-041
39.73 A.
30
CROSS Fd. & USED ON BRIDGE deck
7.24 A.
7.15 A.
5.70 A.
5.70 A.
5.68 A.
5.67 A.
5.65 A.
-042
-032
-030
-024
-018
-016
-014
JONES RD
2
-034
2.05A
-022
2.51A.
235.50
780.21
562.50
-045 -046 2.21A. 2.69 A.
-010
-008
0.40A
-007
2.00A.
237.00
-021
2.44 A.
-023
1.89A.
235.50
-024
-022
37.55 A.
36.14A
-019
43.70 A.
29
T
C
-016
9.71 A.
-014
24.77A.
1483.25
A
19-02-029-000- 19-02-030-000-
PRIOR INST. 1087/358
SURVEYED BY: LAUNDON,SIMON,CAHL &
C=1: INF. ASSOC.
28
-002
41.53 A.
-009
61.42 A.
-006
22.28A
715
APPROVED
LORAIN CO.
MAP DEPT.
DATE 1-30-91
PAGE 19-G
BY CAROLYN FRANCIS
ROW NO. 19267